F.H.W.A. REGION NO.	STATE	FED. AID PROJ. NO.	SHEET NO.	TOTAL SHEETS
3	MD.	HES-3003(1)	6	12

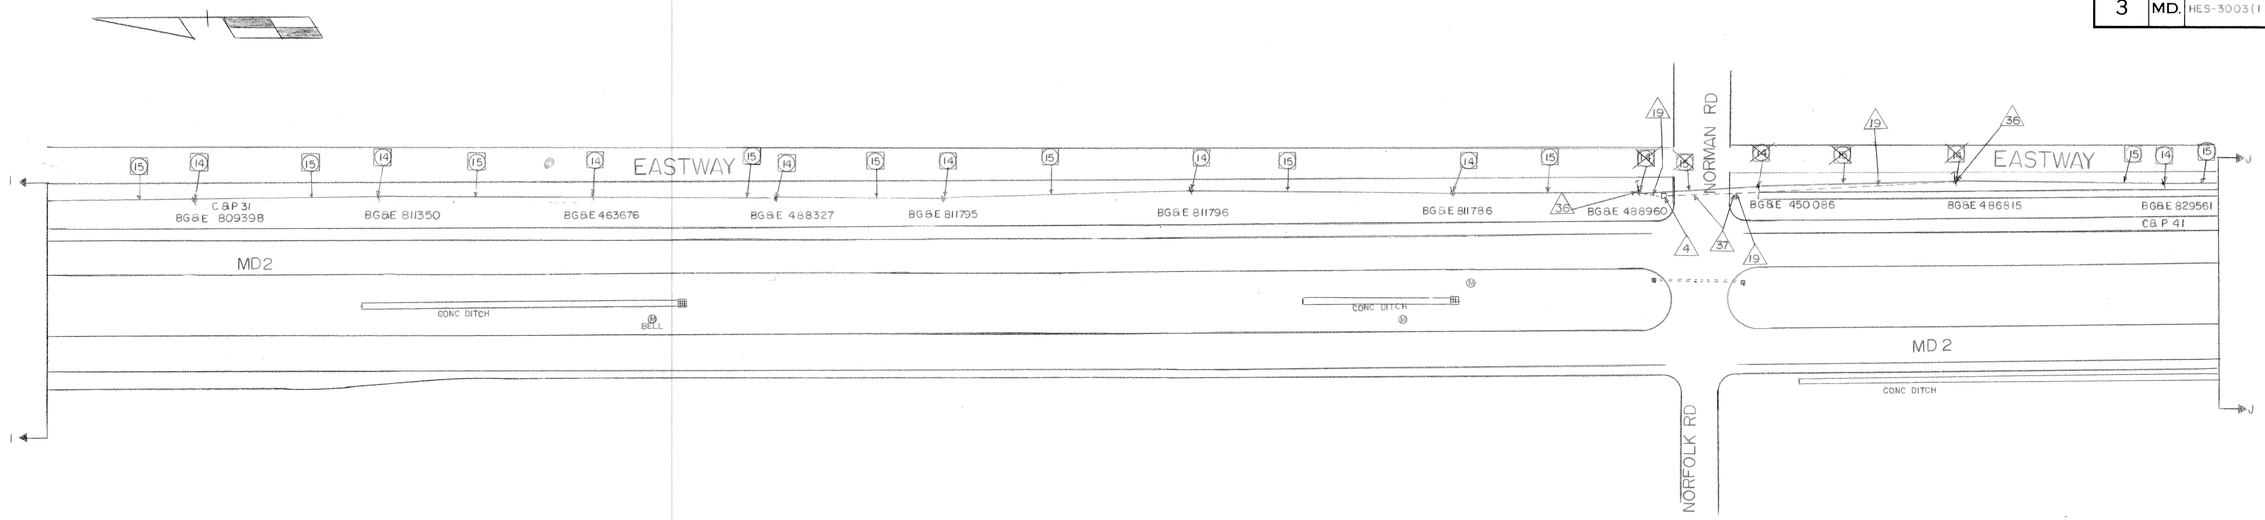

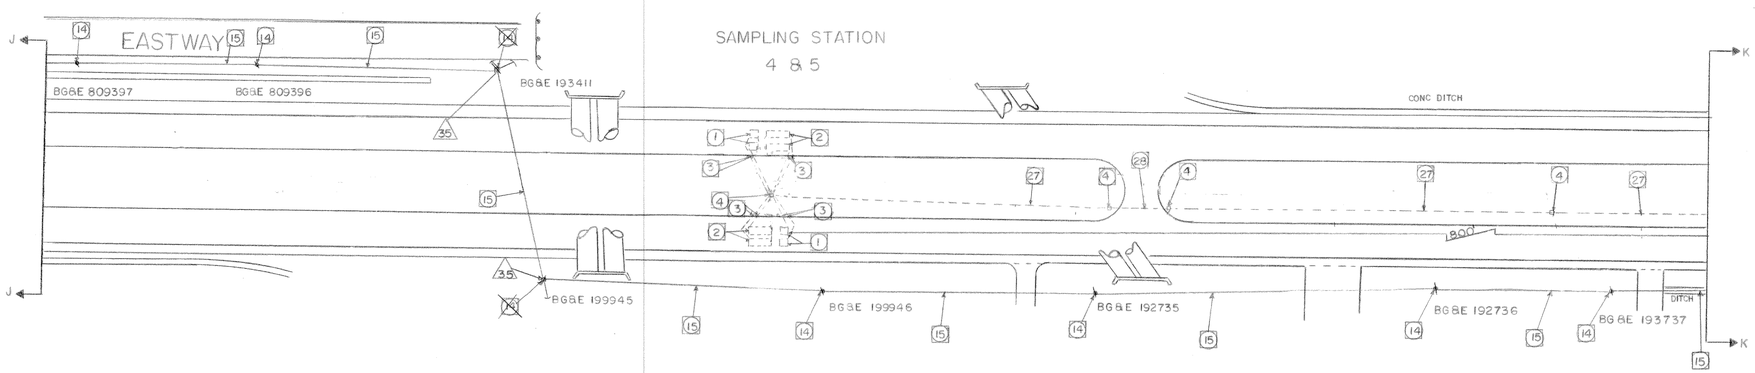

APPROVAL: REGIONAL TRAFFIC ENGINEER

APPROVAL: CHIEF-BUREAU OF TRAFFIC ENGINEERING

APPROVAL: ASS'T. CHIEF ENGINEER TRAFFIC

C 11-2-87 RED LINE REVISION OVERHEAD INTERCONNECT SHA NO. AA-441-501-576

B 4/6/87 INSTALL NEW TELEMETRY INTERCONNECT CABLE SHA NO. AA-441-501-576

A ASBUILT 8-26-82

FAP NO T-8005(12) AA-887-2-585

REVISIONS

STATE OF MARYLAND
DEPARTMENT OF TRANSPORTATION
STATE HIGHWAY ADMINISTRATION

TRAFFIC DIVISION – BUREAU OF TRAFFIC ENGINEERING

MD2, FROM MD 177 TO 6th AVENUE

SCALE 1"=50' | DATE 8-23-73 | CONTRACT NO.

DRAWN BY: BT & JG | COUNTY: ANNE ARUNDEL

DESIGNED BY: | SIGNAL NO.:

CHECKED BY:

DRAWING NO. TS-1135X4C

BRUNING 44.511 19927