F.H.WA REGION NO	STATE	FED. AID PROJ. NO	SHEET NO.	TOTAL SHEETS
3	MD.	HES-3003 (1)	8	12

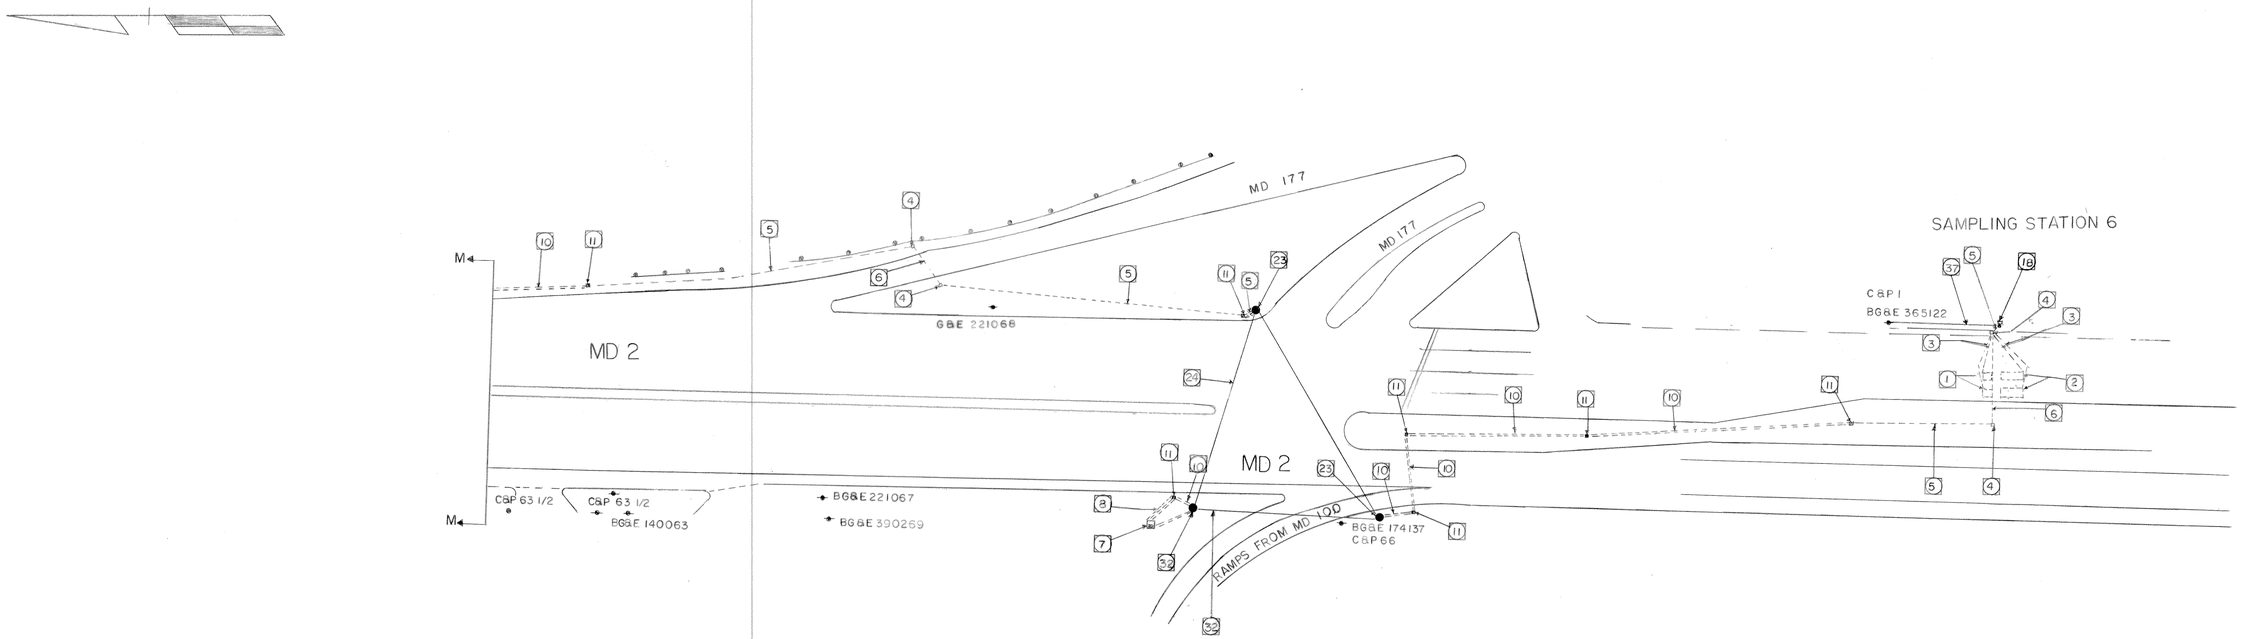

REVISIONS	APPROVALS
B 477/87 INSTALL NEW TELEMETRY INTERCONNECT CABLE SHA NO. AA-441-501-576	CHIEF, DESIGN SECTION
A ASBUILT 6-26-82 FAP NO T-8005 (12) AA-887-2-585	ASST. DISTRICT ENGINEER, TRAFFIC
	CHIEF, BUREAU OF TRAFFIC ENGINEERING
	DEPUTY CHIEF ENGINEER, OFFICE OF TRAFFIC

MARYLAND DEPARTMENT OF TRANSPORTATION
STATE HIGHWAY ADMINISTRATION – OFFICE OF TRAFFIC
BUREAU OF TRAFFIC ENGINEERING

DRAWN BY BT & JG
DES. BY:
CHK. BY:

MD 2 FROM MD 177 TO 6th AVENUE

COUNTY: ANNE ARUNDEL

DATE: 8-23-87
SCALE: 1" = 50'

F.A.P. NO. T-8005 (12)
S.H.A. NO. AA-887-2-585

TS/FILE NO. 1135 X 6B

SHEET NO. 8 OF 12