F H WA REGION NO	STATE	FED. AID PROJ. NO	SHEET NO.	TOTAL SHEETS
3	MD.			

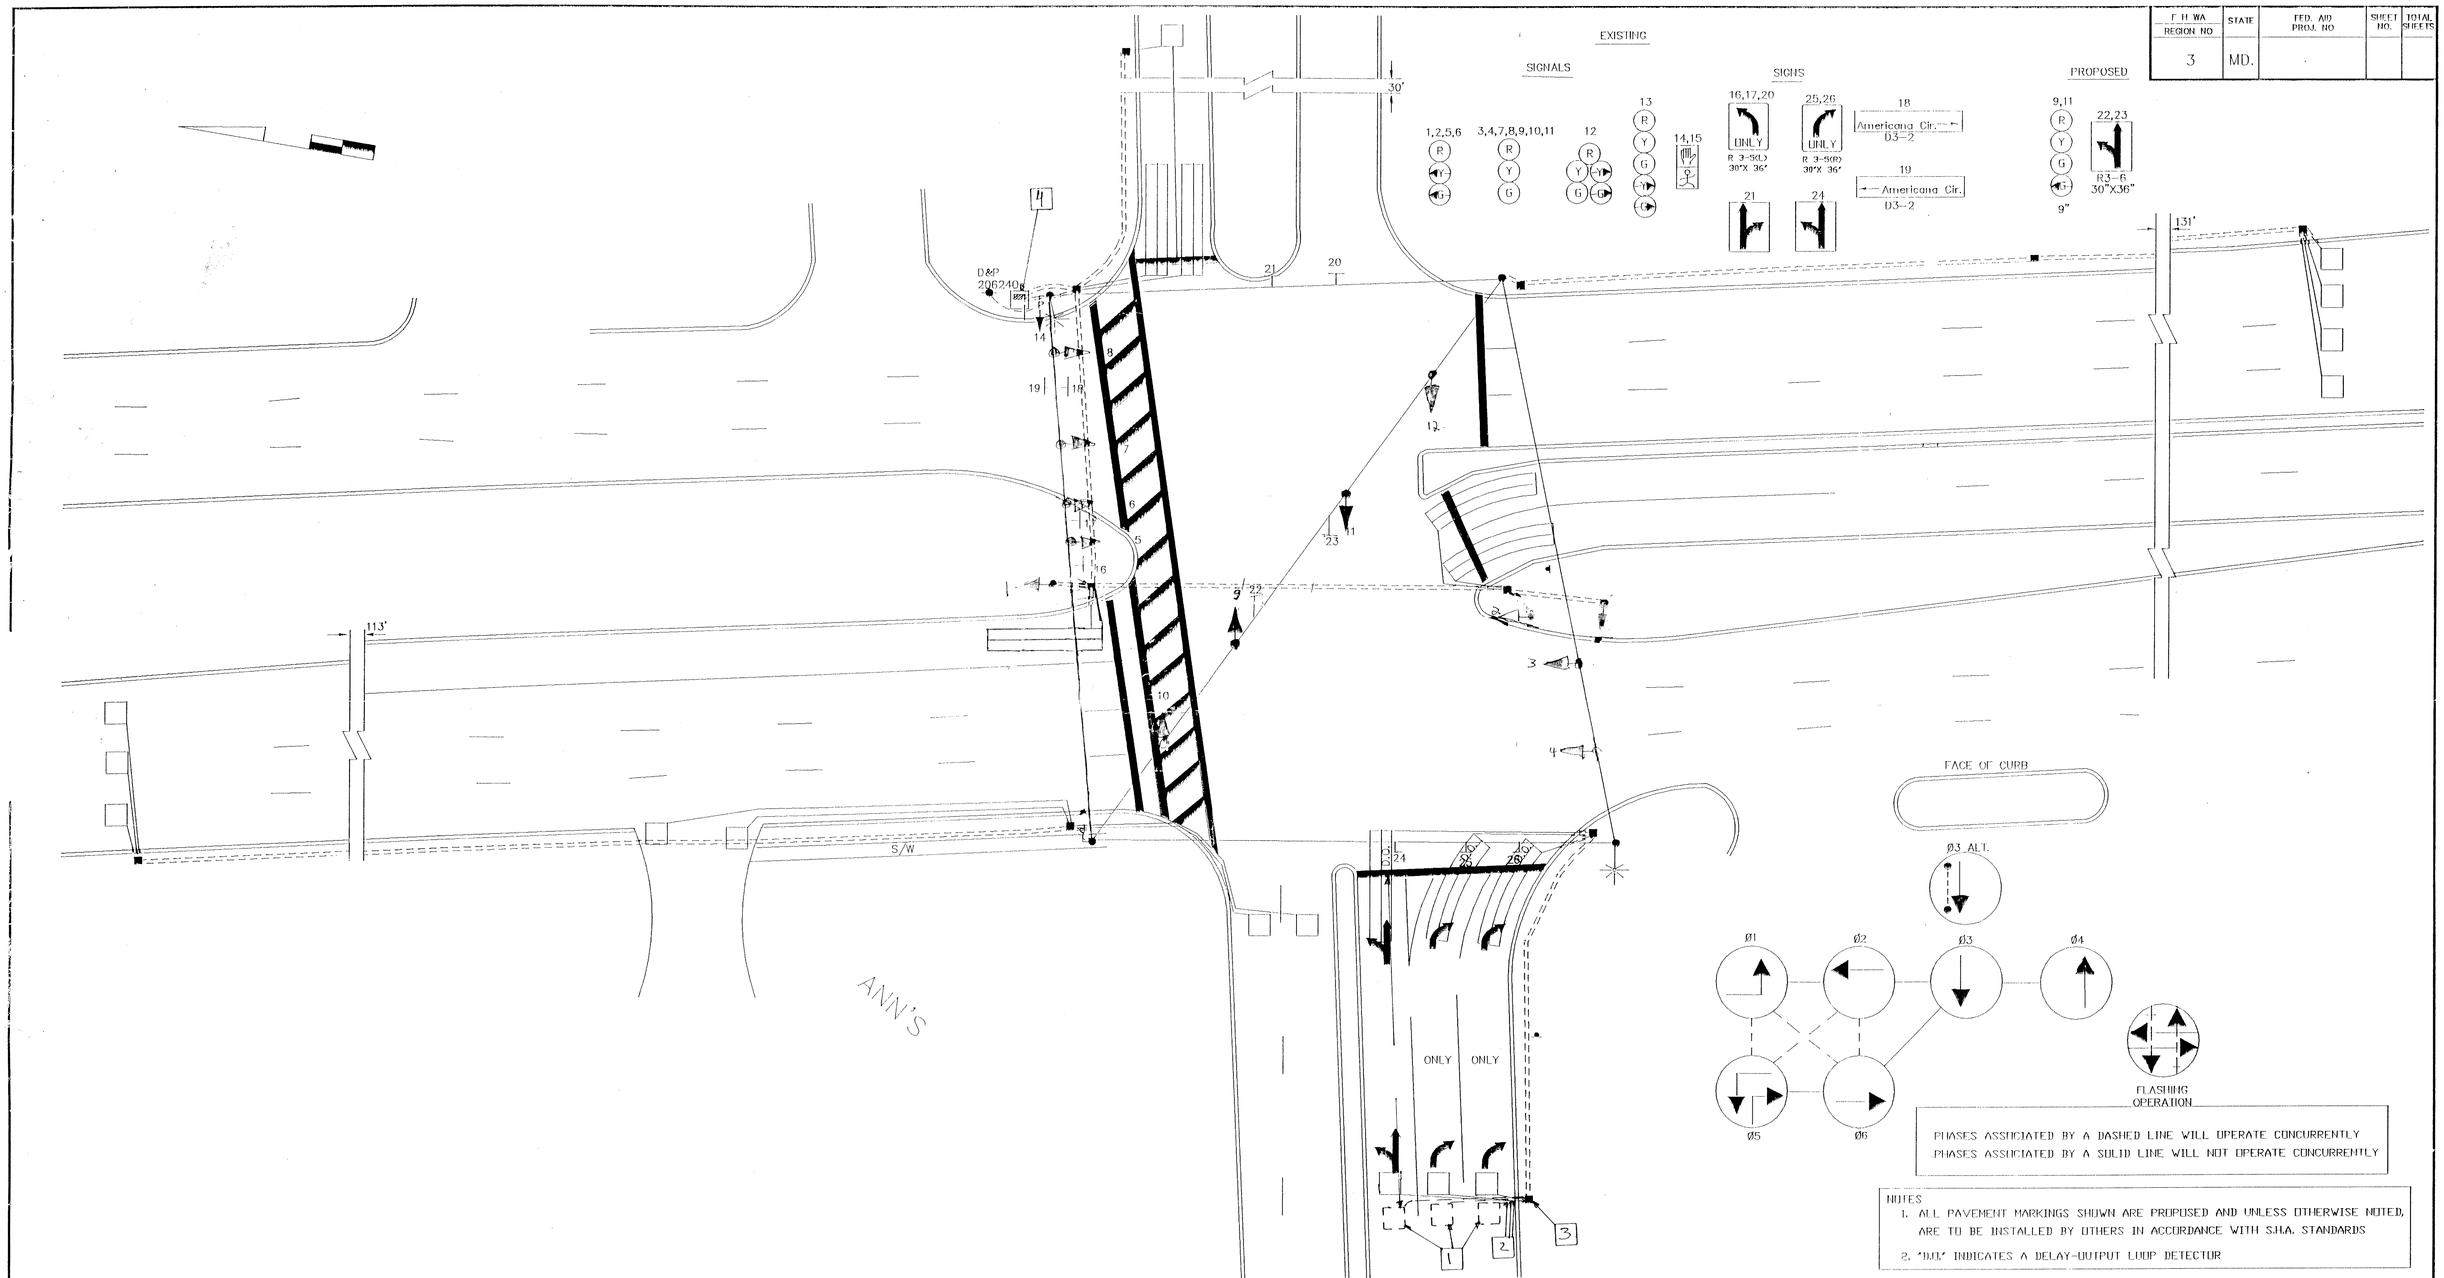

PHASES ASSOCIATED BY A DASHED LINE WILL OPERATE CONCURRENTLY
PHASES ASSOCIATED BY A SOLID LINE WILL NOT OPERATE CONCURRENTLY

NOTES
1. ALL PAVEMENT MARKINGS SHOWN ARE PROPOSED AND UNLESS OTHERWISE NOTED, ARE TO BE INSTALLED BY OTHERS IN ACCORDANCE WITH S.H.A. STANDARDS
2. "D.O." INDICATES A DELAY-OUTPUT LOOP DETECTOR

UTILITY LEGEND

—G— G—	GAS MAIN
—W— W—	WATER MAIN
—S— S—	SEWER MAIN
—E— E—	ELECTRIC CABLES
—A— A—	AERIAL CABLES
—T— T—	TELEPHONE CABLES

REVISIONS

E REPLACE FAILED LOOP DETECTORS 3/94
SHA NO.: AW 577-501-085
FAP NO.: AC-CMG-STPG-0005(192)E
RCS

D RED-LINE REVISION INSTALL LOOP DETECTOR 9/91
MEL

C SPLIT SIDE STREET 7/91
MEL

B INSTALL COUNTING STATION FOR MARLEY STATION MALL 5/87
CE | SAR | DAZ | EIP | III

APPROVALS

ORIGINALS
CHIEF, SIGNAL DESIGN SECTION

NOTED
ASST. DISTRICT ENGINEER, TRAFFIC

ON FILE
CHIEF, TRAFFIC ENGINEERING DIVISION

DEPUTY CHIEF ENGINEER, OFFICE OF TRAFFIC

MDOT – STATE HIGHWAY ADMINISTRATION
Office of Traffic
TRAFFIC ENGINEERING DIVISION

Log miles 02000234.26

DRAWN BY:
DES. BY:
CHK. BY:

GOV. RITCHIE HIGHWAY (MD ROUTE 2)
AT AMERICANA CIRCLE

COUNTY: ANNE ARUNDEL

DATE:
SCALE:
F.A.P. NO.
S.H.A. NO.

TS/STD. NO. TS-874CD

SHEET NO. ___ OF ___

02-000234.26