FHWA REGION NO.	STATE	FED. AID PROJ. NO.	SHEET NO.	TOTAL SHEETS
3	MD			

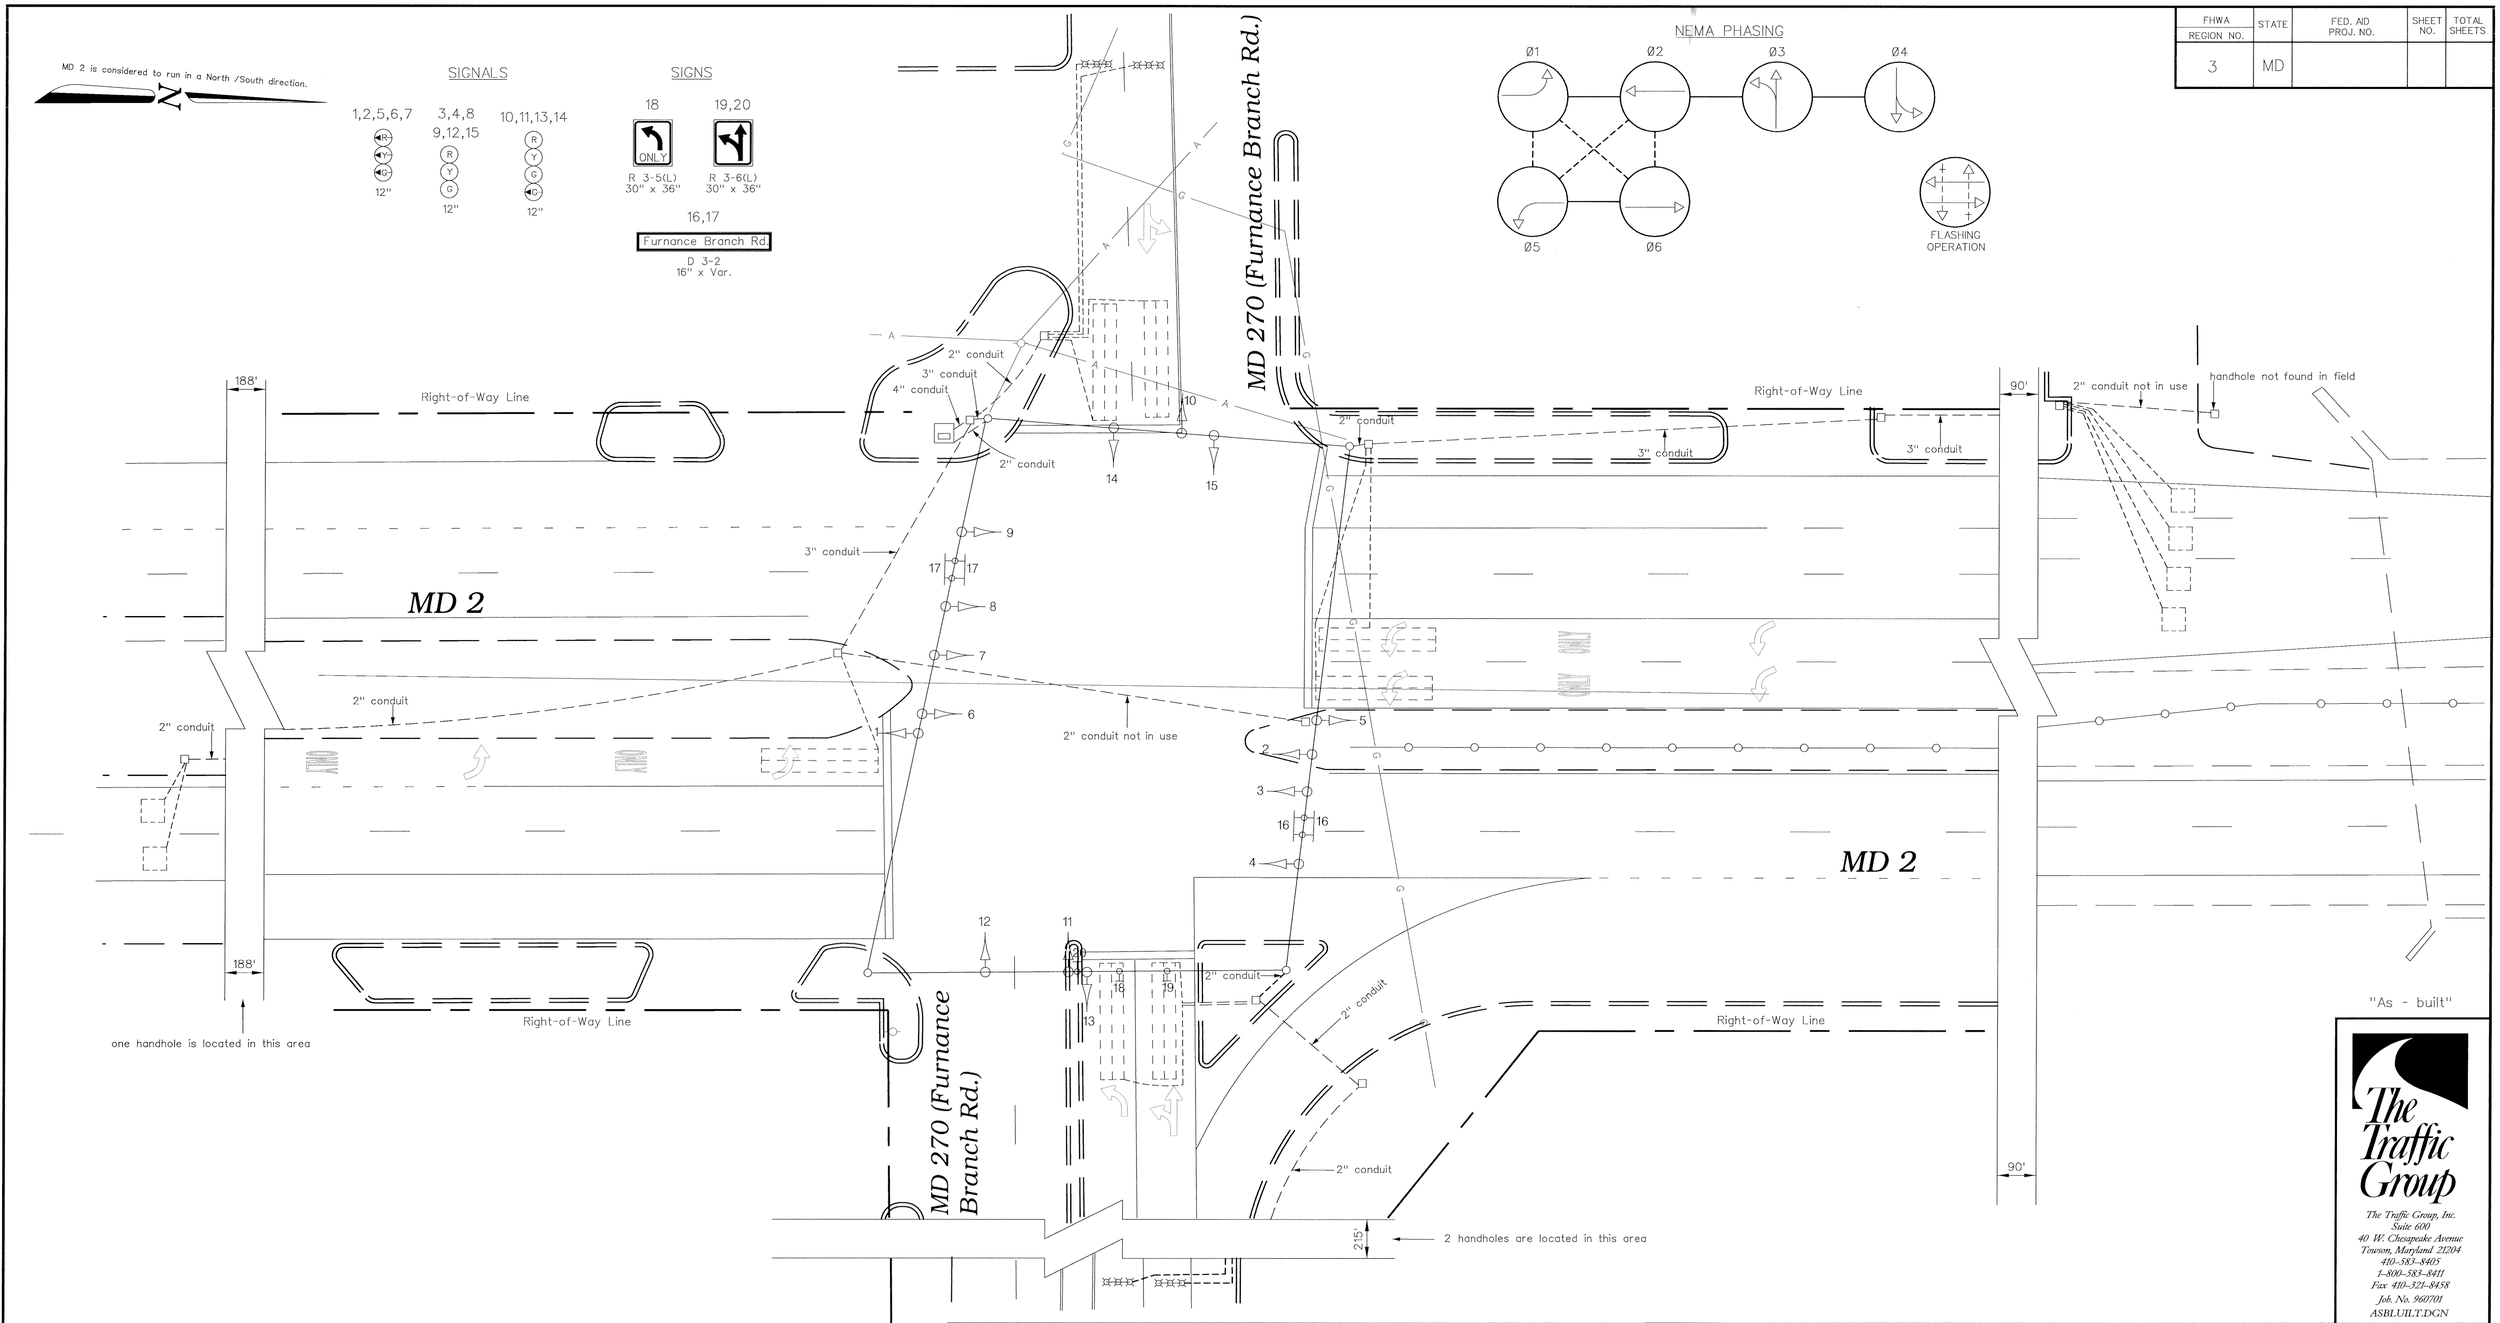

The Traffic Group

The Traffic Group, Inc.
Suite 600
40 W. Chesapeake Avenue
Towson, Maryland 21204
410-583-8405
1-800-583-8411
Fax 410-321-8458
Job. No. 960701
ASBLUILT.DGN

GEOMETRIC LEGEND

EXISTING GEOMETRICS
PROPOSED GEOMETRICS

UTILITY LEGEND

G G	GAS MAIN
W W	WATER MAIN
S S	SEWER MAIN
E E	ELECTRIC CABLES
D D	STORM DRAIN
A A	AERIAL CABLES
T T	TELEPHONE CABLES

REVISIONS

© AUGUST 2, 1996
AS-BUILT
S.H.A. No.: 855-25057051
DBD

APPROVALS

ASST. DIVISION CHIEF TRAFFIC ENGINEERING DESIGN DIVISION
CHIEF, TRAFFIC ENGINEERING DESIGN DIVISION
ASST. DISTRICT ENGINEER - TRAFFIC
DIRECTOR, OFFICE OF TRAFFIC & SAFETY

ORIGINAL ON FILE

MDOT – STATE HIGHWAY ADMINISTRATION
Office of Traffic & Safety
TRAFFIC ENGINEERING DESIGN DIVISION

DRAWN BY: DCD
DES. BY: DCD
CHK. BY:

(Traffic Signal Plan)
MD 2 at MD 270 (Furnance Branch Rd)

COUNTY: Anne Arundel:
LOG MILE * 02000238.04

DATE: January 1988
SCALE: 1" = 20'
F.A.P. NO. BR RS-1172(1)
S.H.A. NO. AA 397-501-580
TS/STD. NO. *761-E*
SHEET NO. 1 of 1