FAP NO T-8005 (12)
SHEET NO. 18 OF 21

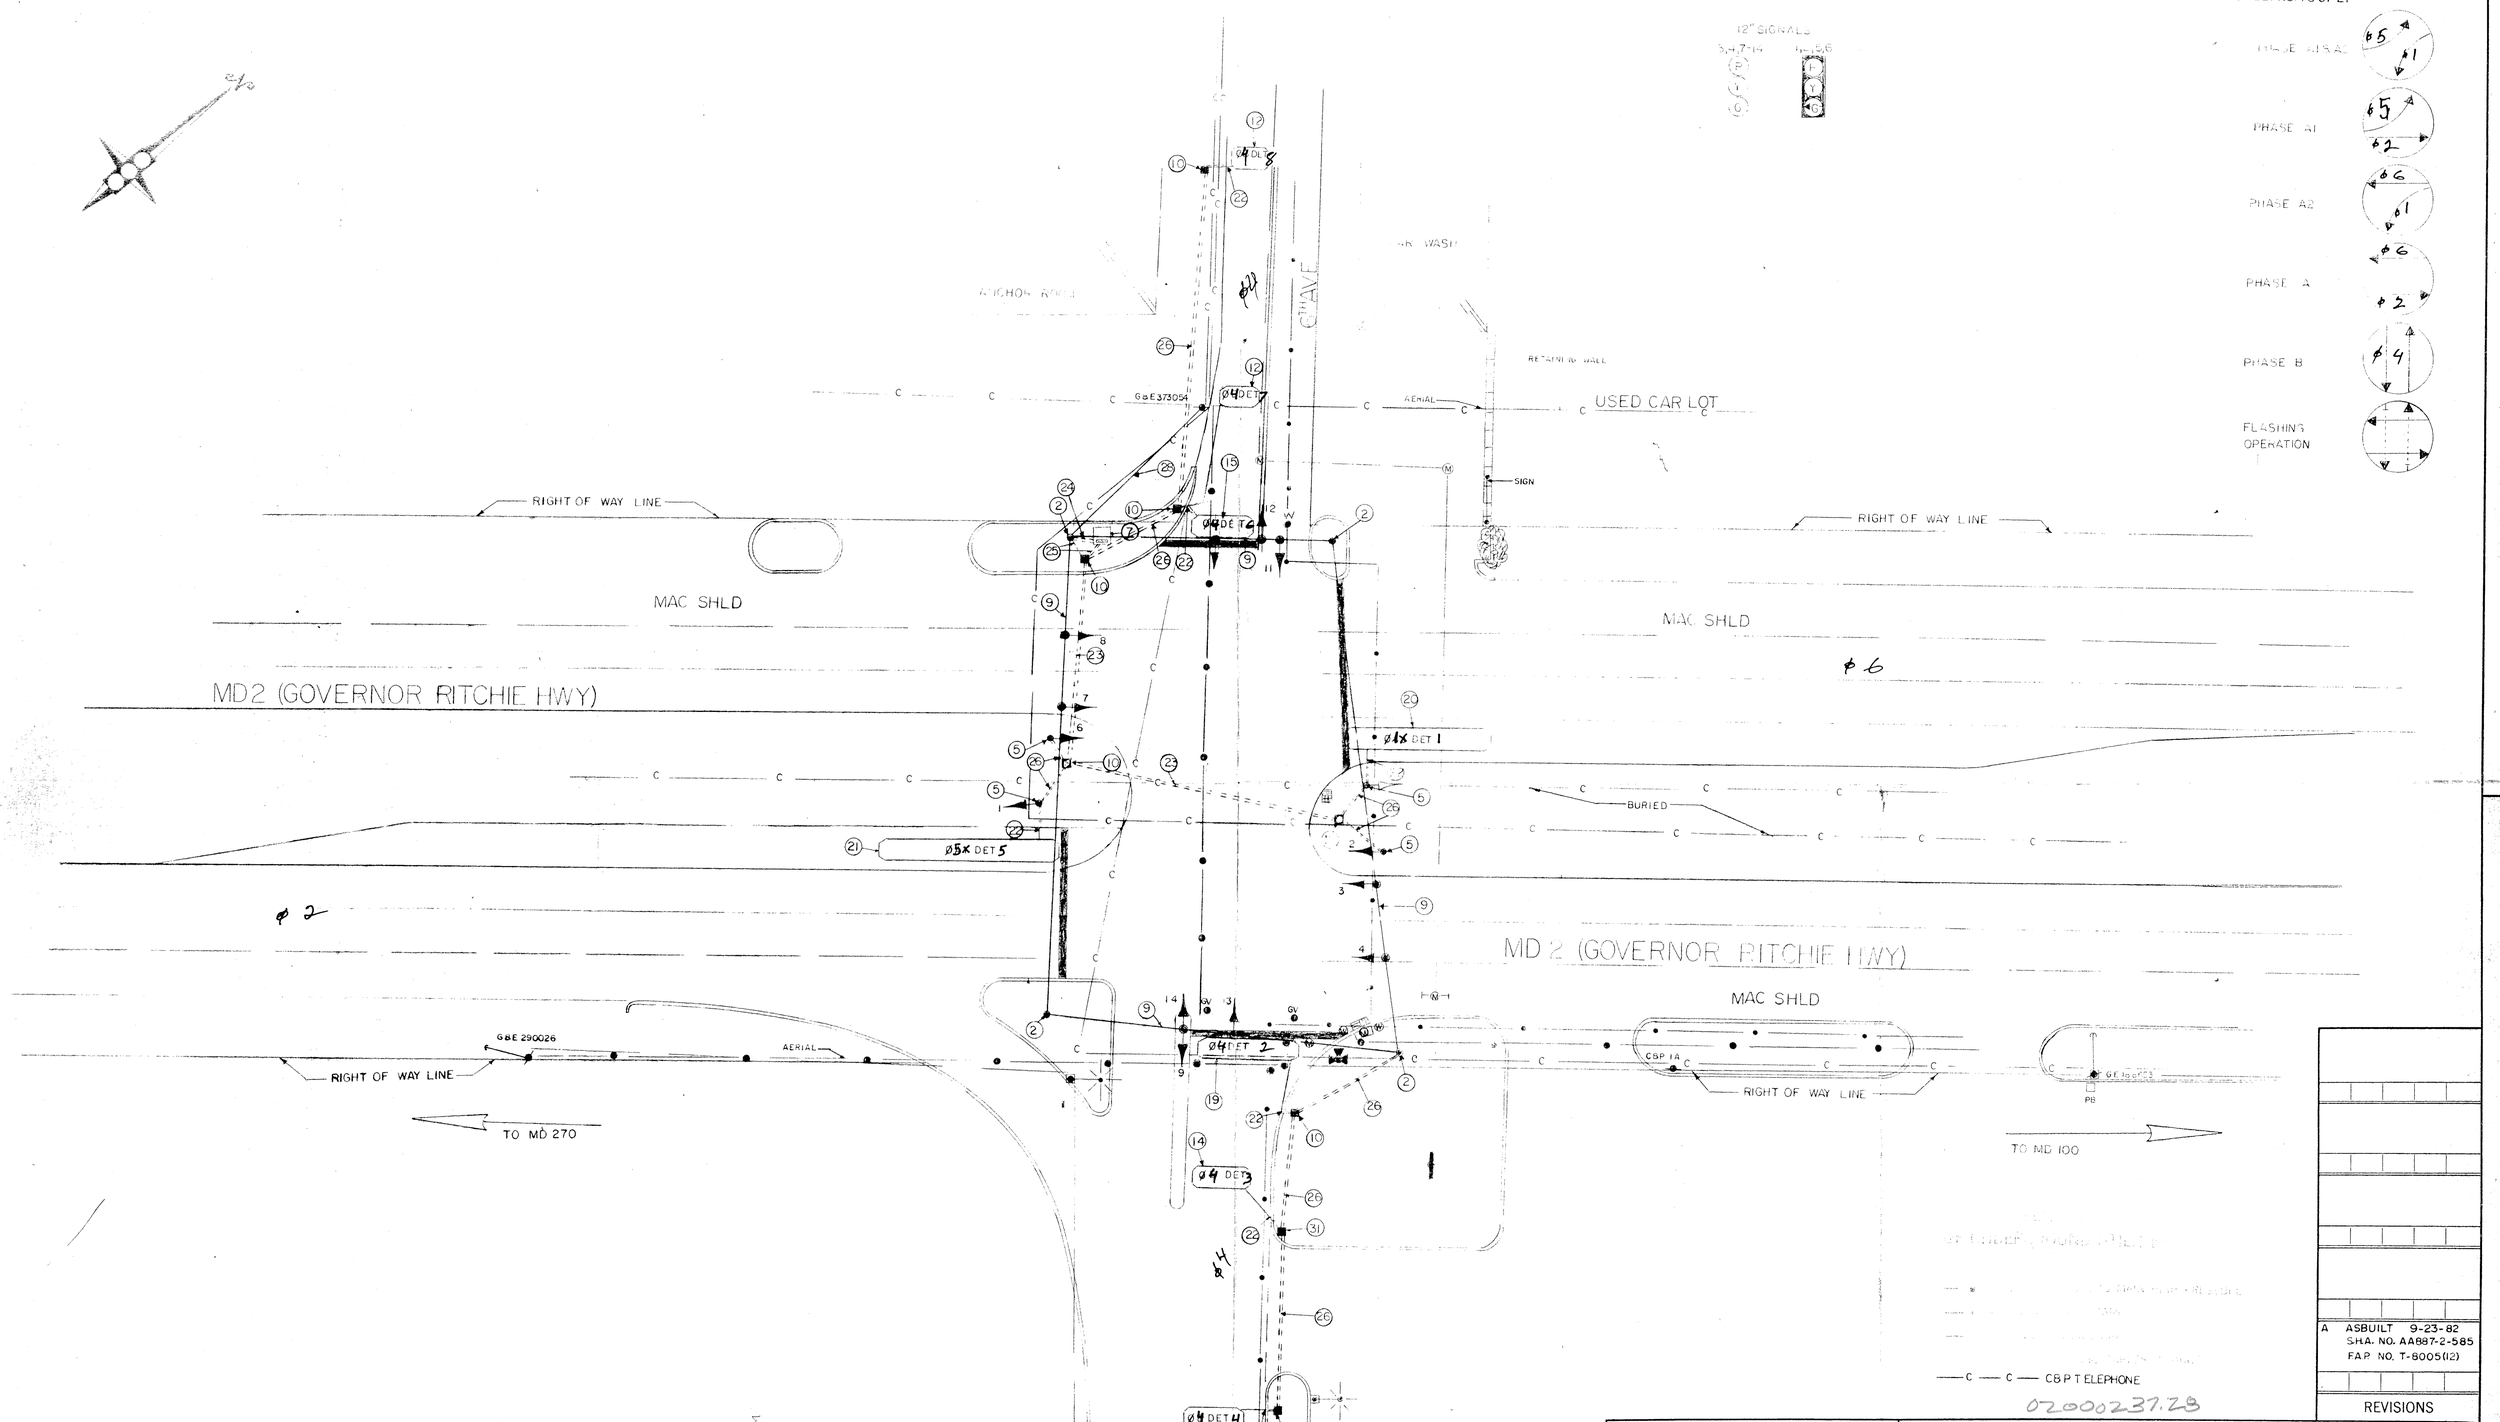

A	ASBUILT 9-23-82 S.H.A. NO. AA887-2-585 F.A.P. NO. T-8005(12)

REVISIONS

APPROVAL: CHIEF - BUREAU OF TRAFFIC ENGINEERING

APPROVAL: ASS'T CHIEF ENGINEER TRAFFIC SAFETY

MARYLAND STATE ROADS COMMISSION
DIVISION OF TRAFFIC SAFETY
BUREAU OF TRAFFIC ENGINEERING

MD 2 (RITCHIE HWY) & 6TH AVE

SIGNAL NO. 02062

DATE 11-9-72
SCALE 1" = 20'
CONTRACT NO
COUNTY ANNE ARUNDEL

DRAWING NO.