KAE 19 1153 6-81 MC 26474

F.H.W.A. REGION NO.	STATE	FED. AID PROJ. NO.	SHEET NO.	TOTAL SHEETS
3	MD.	US-9469 (1)	13	16

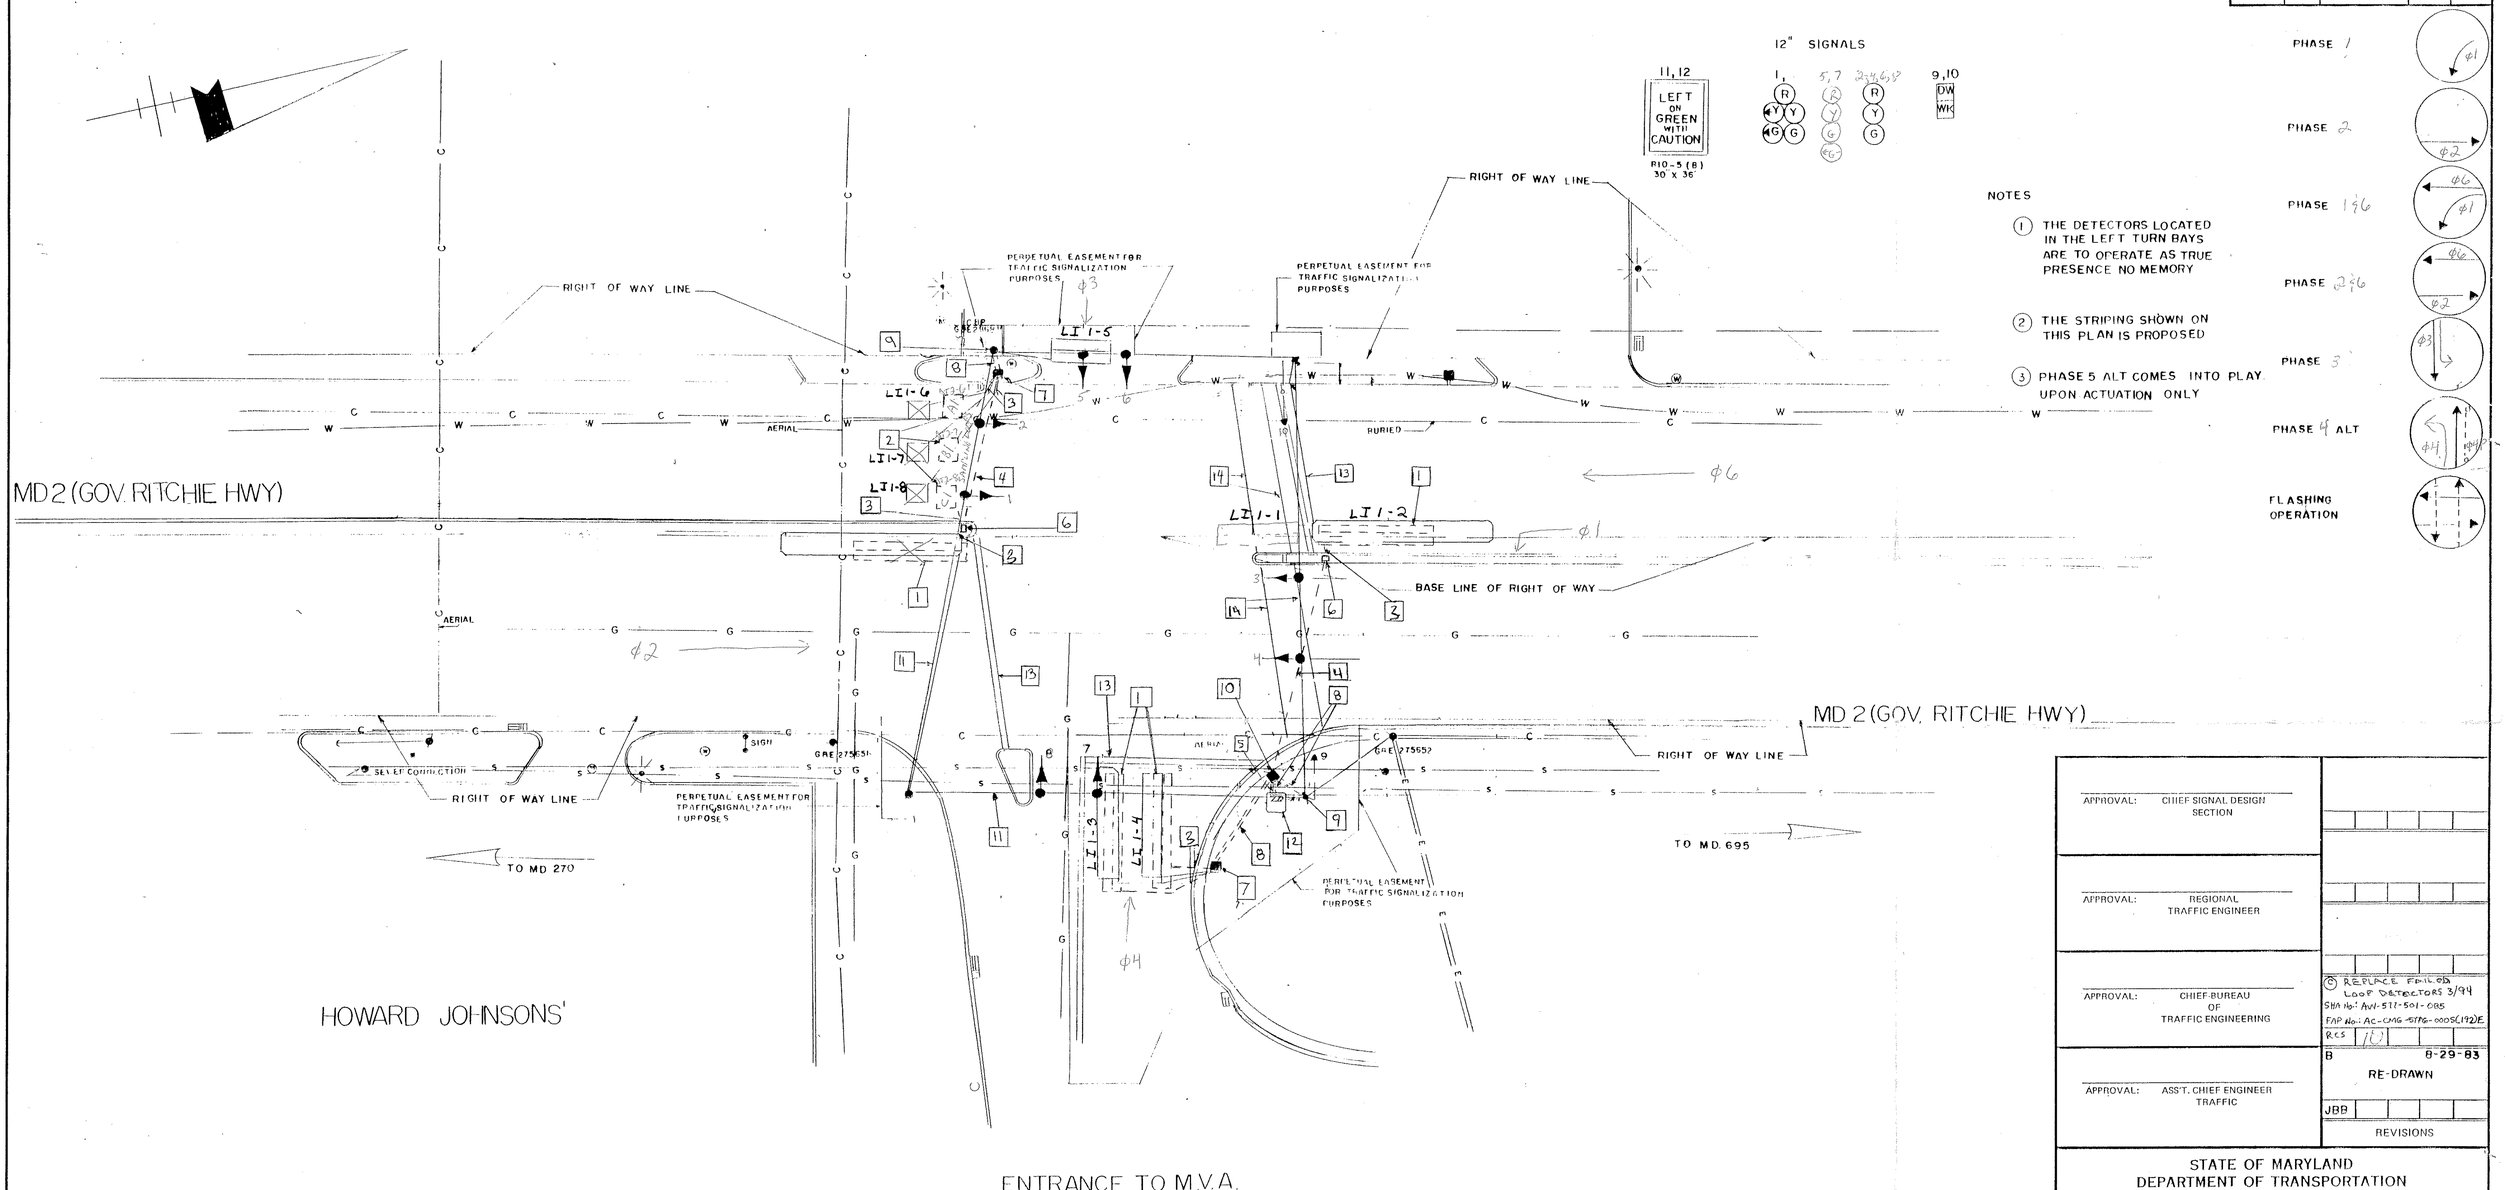

APPROVAL: CHIEF SIGNAL DESIGN SECTION

APPROVAL: REGIONAL TRAFFIC ENGINEER

APPROVAL: CHIEF BUREAU OF TRAFFIC ENGINEERING

APPROVAL: ASS'T. CHIEF ENGINEER TRAFFIC

C	REPLACE FAILED LOOP DETECTORS 3/94		
SHA No.: AW-511-501-085			
FAP No.: AC-CMG-5176-000S(192)E			
RCS	JB		
B	8-29-83	RE-DRAWN	
JBB			

REVISIONS

STATE OF MARYLAND
DEPARTMENT OF TRANSPORTATION
STATE HIGHWAY ADMINISTRATION

TRAFFIC DIVISION — BUREAU OF TRAFFIC ENGINEERING

MD 2 & ENTRANCE TO M.V.A.

NEW LOOPS HOOKED UP 11-94

SCALE 1"=20' DATE CONTRACT NO. AA-887-003-585

DRAWN BY: J GORDON COUNTY: ANNE ARUNDEL

DESIGNED BY: SIGNAL NO.: 02072

CHECKED BY: DRAWING NO. TS-530B

02000239.10