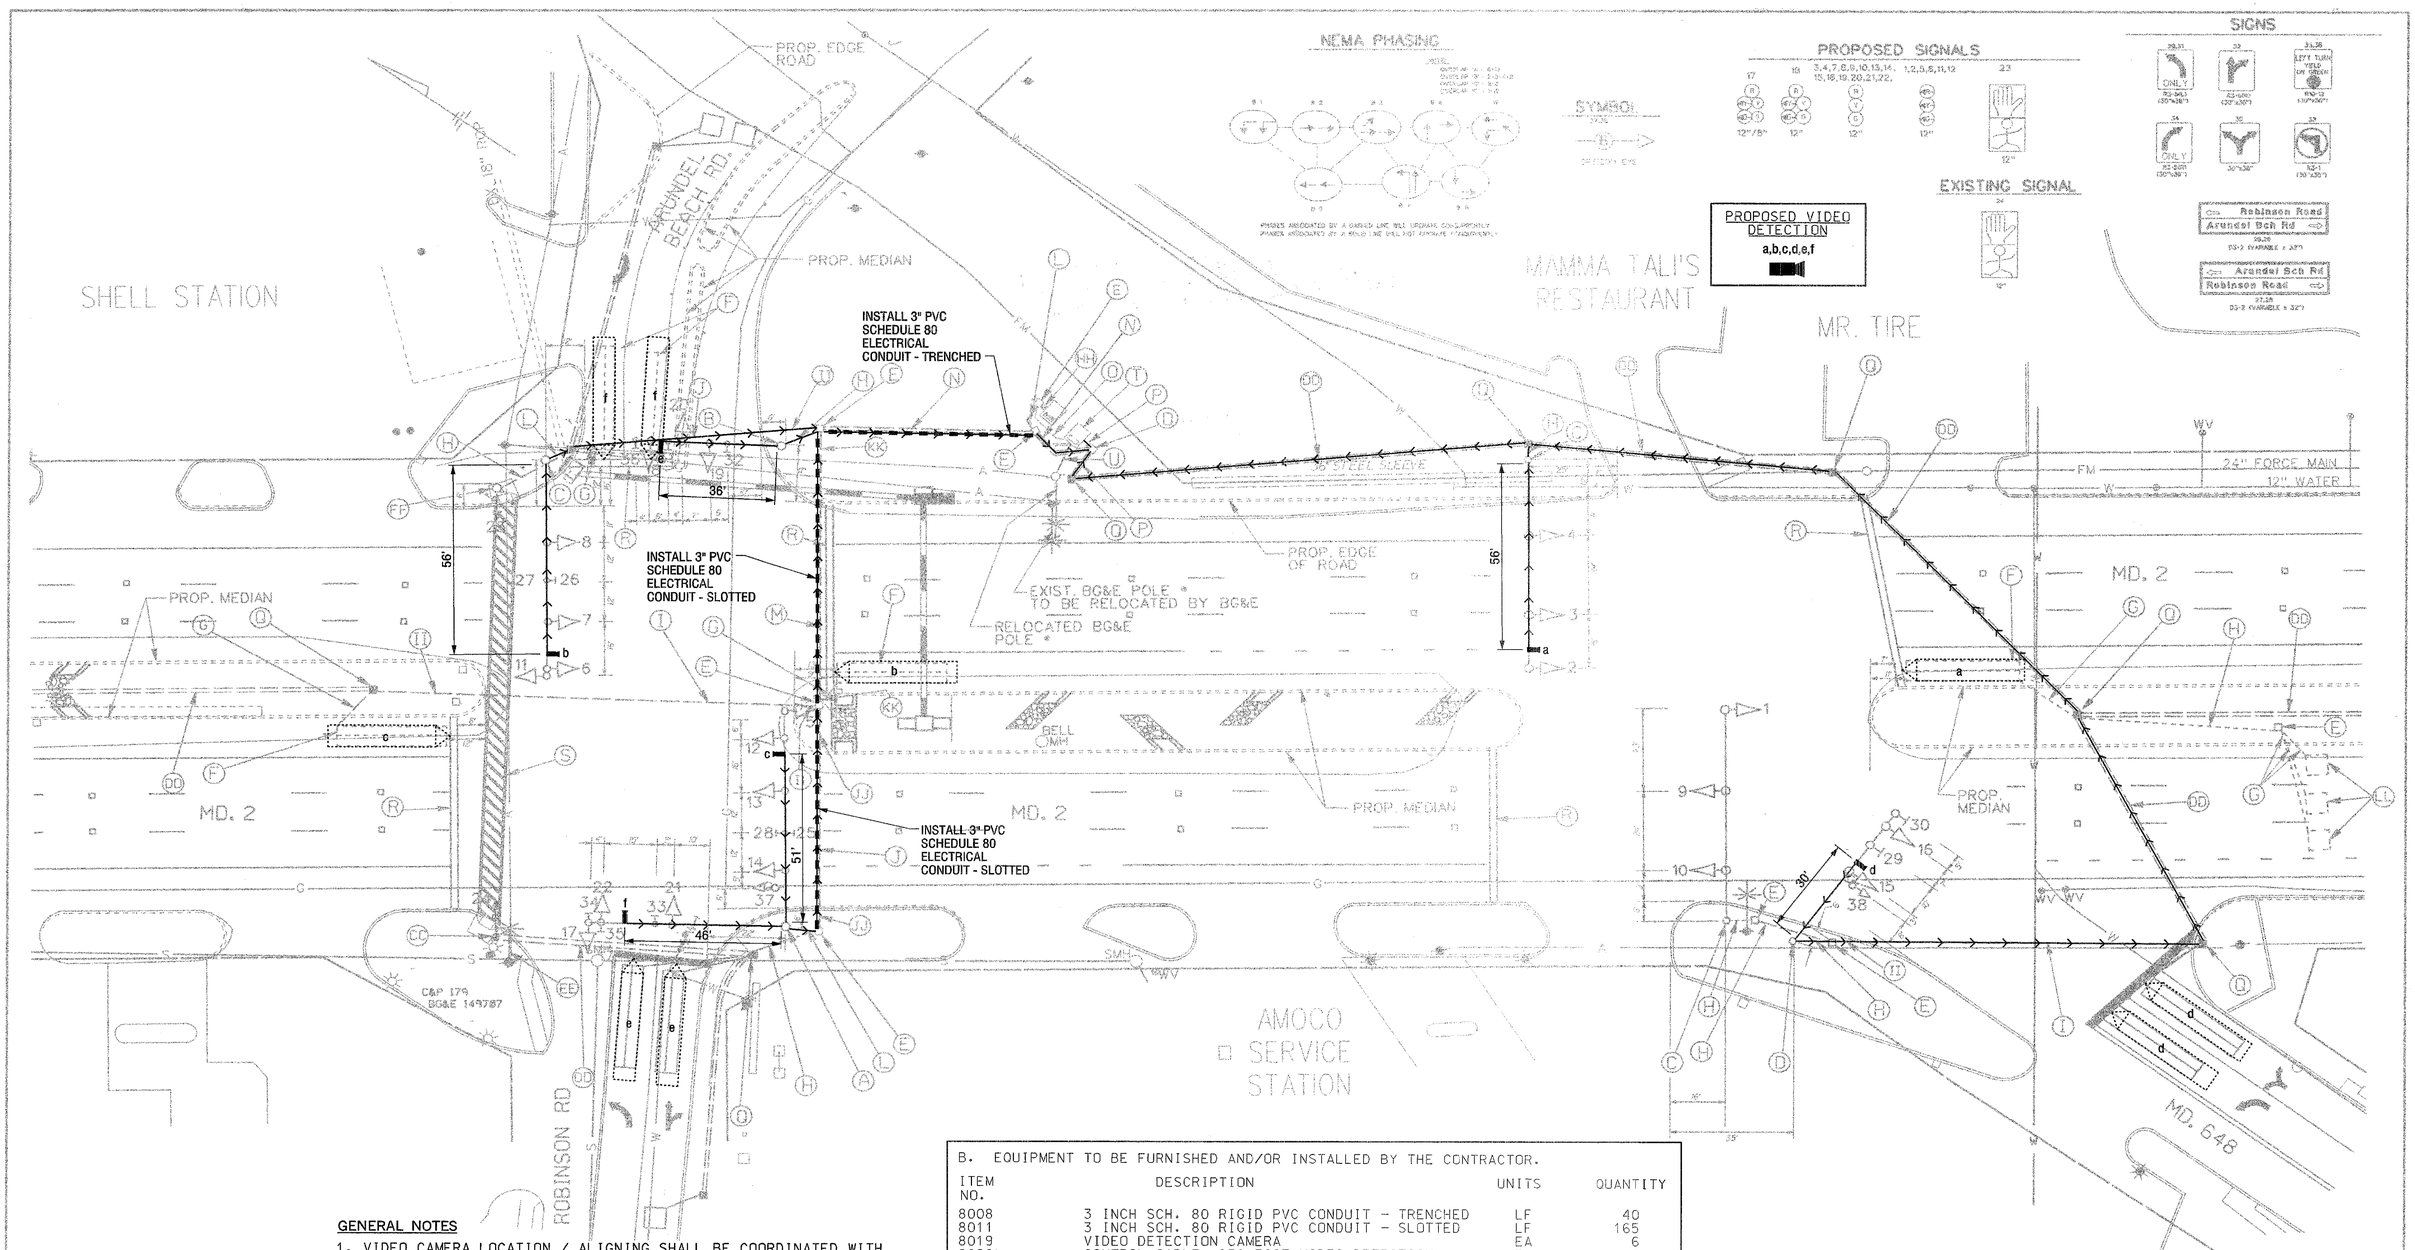

B. EQUIPMENT TO BE FURNISHED AND/OR INSTALLED BY THE CONTRACTOR.

ITEM NO.	DESCRIPTION	UNITS	QUANTITY
8008	3 INCH SCH. 80 RIGID PVC CONDUIT - TRENCHED	LF	40
8011	3 INCH SCH. 80 RIGID PVC CONDUIT - SLOTTED	LF	165
8019	VIDEO DETECTION CAMERA	EA	6
8020	CONTROL CABLE, 250 FOOT VIDEO DETECTION CAMERA TO CONTROLLER	EA	3
8021	CONTROL CABLE, 500 FOOT VIDEO DETECTION CAMERA TO CONTROLLER	EA	3

GENERAL NOTES

1. VIDEO CAMERA LOCATION / ALIGNING SHALL BE COORDINATED WITH THE SHA ENGINEER.
2. THE CONTRACTOR SHALL CONTACT SHA TO SCHEDULE RETROFITTING OF THE CONTROLLER EQUIPMENT IN ORDER TO OPERATE VIDEO DETECTION EQUIPMENT.
3. THE CONTRACTOR SHALL BE RESPONSIBLE FOR TERMINATING ALL VIDEO DETECTION CAMERA CABLES TO THE APPROPRIATE TERMINALS AND PROPERLY LABEL EACH CABLE SO THAT SHA FORCES CAN MAKE THE FINAL CONNECTIONS.
4. THE INSTALLATION OF PROPOSED VIDEO DETECTION EQUIPMENT SHALL NECESSITATE THE REMOVAL OF EXISTING CABLES ASSOCIATED WITH THE PRESENCE LOOP DETECTORS BEING REPLACED BY VIDEO DETECTION.
5. ALL EXISTING TRAFFIC SIGNAL EQUIPMENT REMOVED SHALL BECOME THE PROPERTY OF THE SIGNAL CONTRACTOR UPON COMPLETION OF THE SIGNAL MODIFICATIONS.
6. ALL UNUSED SIGNAL CABLES SHALL BE REMOVED AND DISPOSED.

VIDEO CAMERA LEGEND

= VIDEO CABLE (PATH TO CONTROLLER)

UTILITY LEGEND

C — G	GAS MAIN
W — W	WATER MAIN
S — S	SEWER MAIN
E — E	ELECTRIC CABLES
A — A	AERIAL CABLES
T — T	TELEPHONE CABLES

SABRA, WANG & ASSOCIATES, INC.
1504 JOH AVENUE
SUITE 160
BALTIMORE, MD 21227
(410) 737-6564
WWW.SABRA-WANG.COM

REVISION
3/ /04
INSTALL VIDEO DETECTION
SHA No. AT3085185
SWA
1 REDLINE REVISION No. 1
NEW SHEET
12/9/03 2:00 PM
REDESIGN FROM SPAN WIRE TO MAST ARM CONFIGURATION NO. 2 WIDENING SHA NO. AA 505-501-576
MM
E. 1/9/69 RELOCATED SIGNAL EQUIPMENT DUE TO ROADWAY GEOMETRICS SHA NO. AA 514-501-576

APPROVALS
ORIGINAL
CHIEF, SIGNAL DESIGN SECTION
ON
ASST. DISTRICT ENGINEER, TRAFFIC
FILE
CHIEF, TRAFFIC ENGINEERING DIVISION
DEPUTY CHIEF ENGINEER, OFFICE OF TRAFFIC

TOD#: AT308-05
1 ADDENDUM No. 1 02/ /94
SHA#: AA348453/853

THIS SHEET REPLACES SHEET 76
2 REDLINE REVISION No. 2

SHA
MDOT - STATE HIGHWAY ADMINISTRATION
OFFICE OF TRAFFIC & SAFETY
TRAFFIC ENGINEERING DESIGN DIVISION

DRAWN BY: F. DEBELIUS
DES. BY: BRADLEY
CHK. BY:

MD. 2 AND ARUNDEL BEACH RD./ ROBINSON ROAD/MD. 648
COUNTY: ANNE ARUNDEL

DATE: 4/9/73
SCALE: 1" = 20'
F.A.P. NO. N.A.
S.H.A. NO. 505-501-576
TS/STD. NO. TS 168XG
SHEET NO. 76A OF 106

02002029.62 - 29.67

FILE: r:\02-12 200\-12c\task 12\psa_2\dwg\anne arundel\md2amd648.dgn
DATE: 10-Mar-04 09:31