F.H.WA. REGION NO.	STATE	FED. AID PROJ. NO.	SHEET NO.	TOTAL SHEETS
3	MD.			

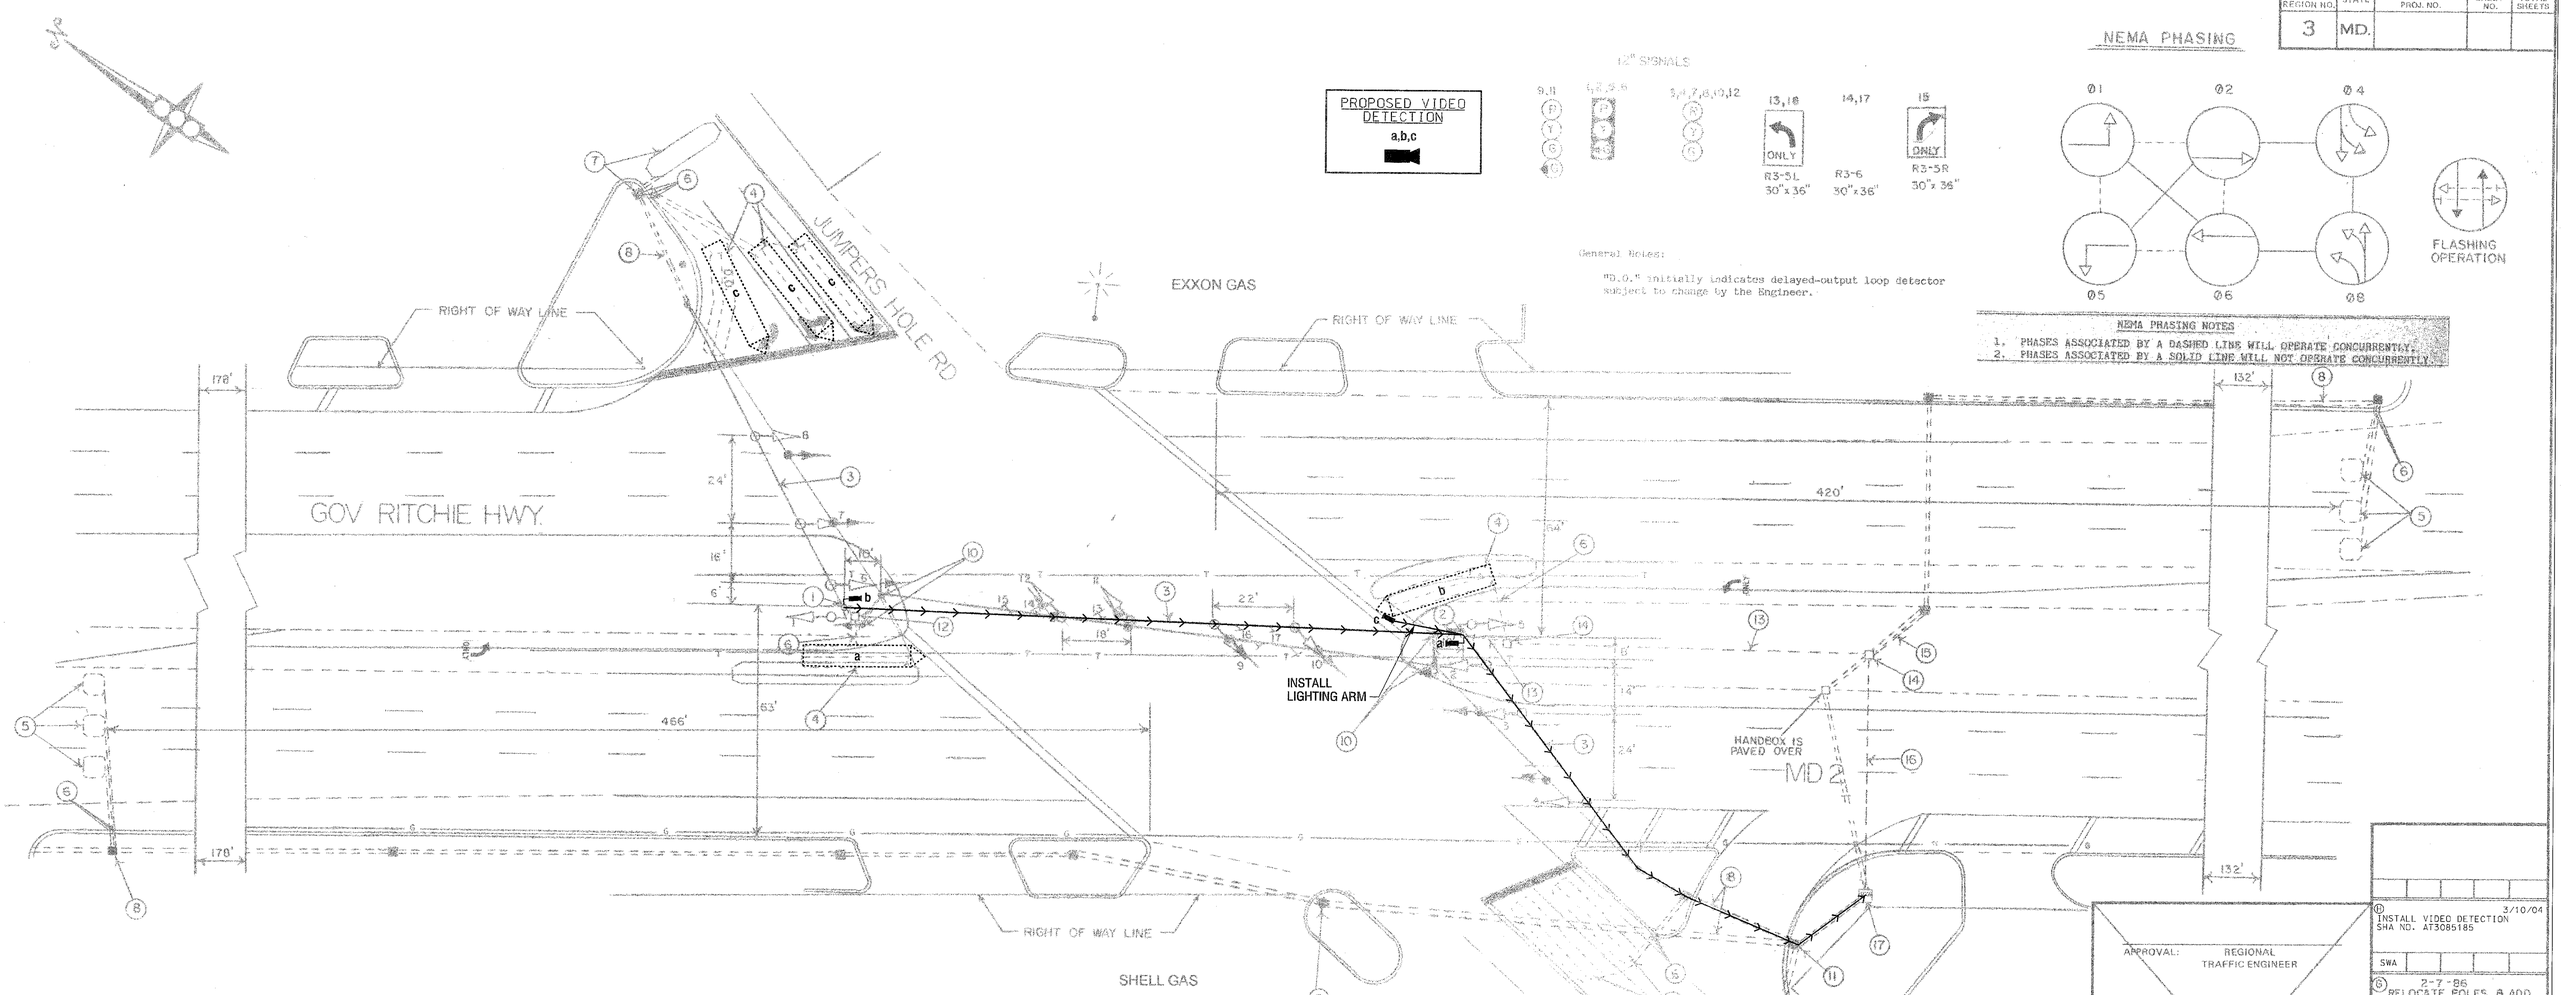

B. EQUIPMENT TO BE FURNISHED AND/OR INSTALLED BY THE CONTRACTOR.

ITEM NO.	DESCRIPTION	UNITS	QUANTITY
8019	VIDEO DETECTION CAMERA	EA	3
8020	CONTROL CABLE, 250 FOOT VIDEO DETECTION CAMERA TO CONTROLLER	EA	2
8021	CONTROL CABLE, 500 FOOT VIDEO DETECTION CAMERA TO CONTROLLER	EA	1
NEG.	20 FOOT LIGHTING ARM ON SIGNAL STRUCTURE	EA	1

GENERAL NOTES

1. VIDEO CAMERA LOCATION / ALIGNING SHALL BE COORDINATED WITH THE SHA ENGINEER.
2. THE CONTRACTOR SHALL CONTACT SHA TO SCHEDULE RETROFITTING OF THE CONTROLLER EQUIPMENT IN ORDER TO OPERATE VIDEO DETECTION EQUIPMENT.
3. THE CONTRACTOR SHALL BE RESPONSIBLE FOR TERMINATING ALL VIDEO DETECTION CAMERA CABLES TO THE APPROPRIATE TERMINALS AND PROPERLY LABEL EACH CABLE SO THAT SHA FORCES CAN MAKE THE FINAL CONNECTIONS.
4. THE INSTALLATION OF PROPOSED VIDEO DETECTION EQUIPMENT SHALL NECESSITATE THE REMOVAL OF EXISTING CABLES ASSOCIATED WITH THE PRESENCE LOOP DETECTORS BEING REPLACED BY VIDEO DETECTION.
5. ALL EXISTING TRAFFIC SIGNAL EQUIPMENT REMOVED SHALL BECOME THE PROPERTY OF THE SIGNAL CONTRACTOR UPON COMPLETION OF THE SIGNAL MODIFICATIONS.
6. ALL UNUSED SIGNAL CABLES SHALL BE REMOVED AND DISPOSED.

VIDEO CAMERA LEGEND

= VIDEO CABLE (PATH TO CONTROLLER)

LEGEND OF UNDERGROUND UTILITIES

GAS MAIN
WATER MAIN
SEWER MAIN
ELECTRIC CABLES
TELEPHONE CABLES
AERIAL CABLES

APPROVAL: REGIONAL TRAFFIC ENGINEER

APPROVAL: CHIEF-BUREAU OF TRAFFIC ENGINEERING

APPROVAL: ASS'T. CHIEF ENGINEER TRAFFIC

(H) 3/10/04 INSTALL VIDEO DETECTION SHA NO. AT3085185

SWA

(G) 2-7-86 RELOCATE POLES & ADD LOOP DETECTORS SHA NO 855-25005

JJD

F 6-2-83 ASBUILT

E 5-23-74 REDRAWN & ASBUILT

REVISIONS

SABRA, WANG & ASSOCIATES, INC.
1504 JOH AVENUE
SUITE 160
BALTIMORE, MD 21227
(410) 737-6564
WWW.SABRA-WANG.COM

SHA STATE OF MARYLAND
DEPARTMENT OF TRANSPORTATION
STATE HIGHWAY ADMINISTRATION

TRAFFIC DIVISION — BUREAU OF TRAFFIC ENGINEERING

MD 2 & JUMPERS HOLE RD

CHA #: AA348453/853 TOD #: AT308-05

SCALE 1"=20' DATE 4-4-73 CONTRACT NO. AA-810-2-576 T-8005(2)

DRAWN BY: F DEBELIUS COUNTY: ANNE ARUNDEL

DESIGNED BY: SIGNAL NO.: 02045

CHECKED BY:

DRAWING NO. TS-155XH