GENERAL NOTES

1. D.O. DENOTES DELAY OUTPUT LOOP DETECTOR
2. PAVEMENT MARKINGS ARE NOT TO BE INSTALLED UNTIL LOOP DETECTOR CONDUIT INSTALLATIONS ARE COMPLETE
3. THE PAVEMENT MARKINGS DETAILED ARE PROPOSED AND SHALL BE INSTALLED BY THE CONTRACTOR IN ACCORDANCE WITH S.H.A. STANDARDS
4. THE CONTRACTOR WILL CONFIRM THE LOCATION OF THE PROPOSED GEOMETRICS PRIOR TO INSTALLING EQUIPMENT.

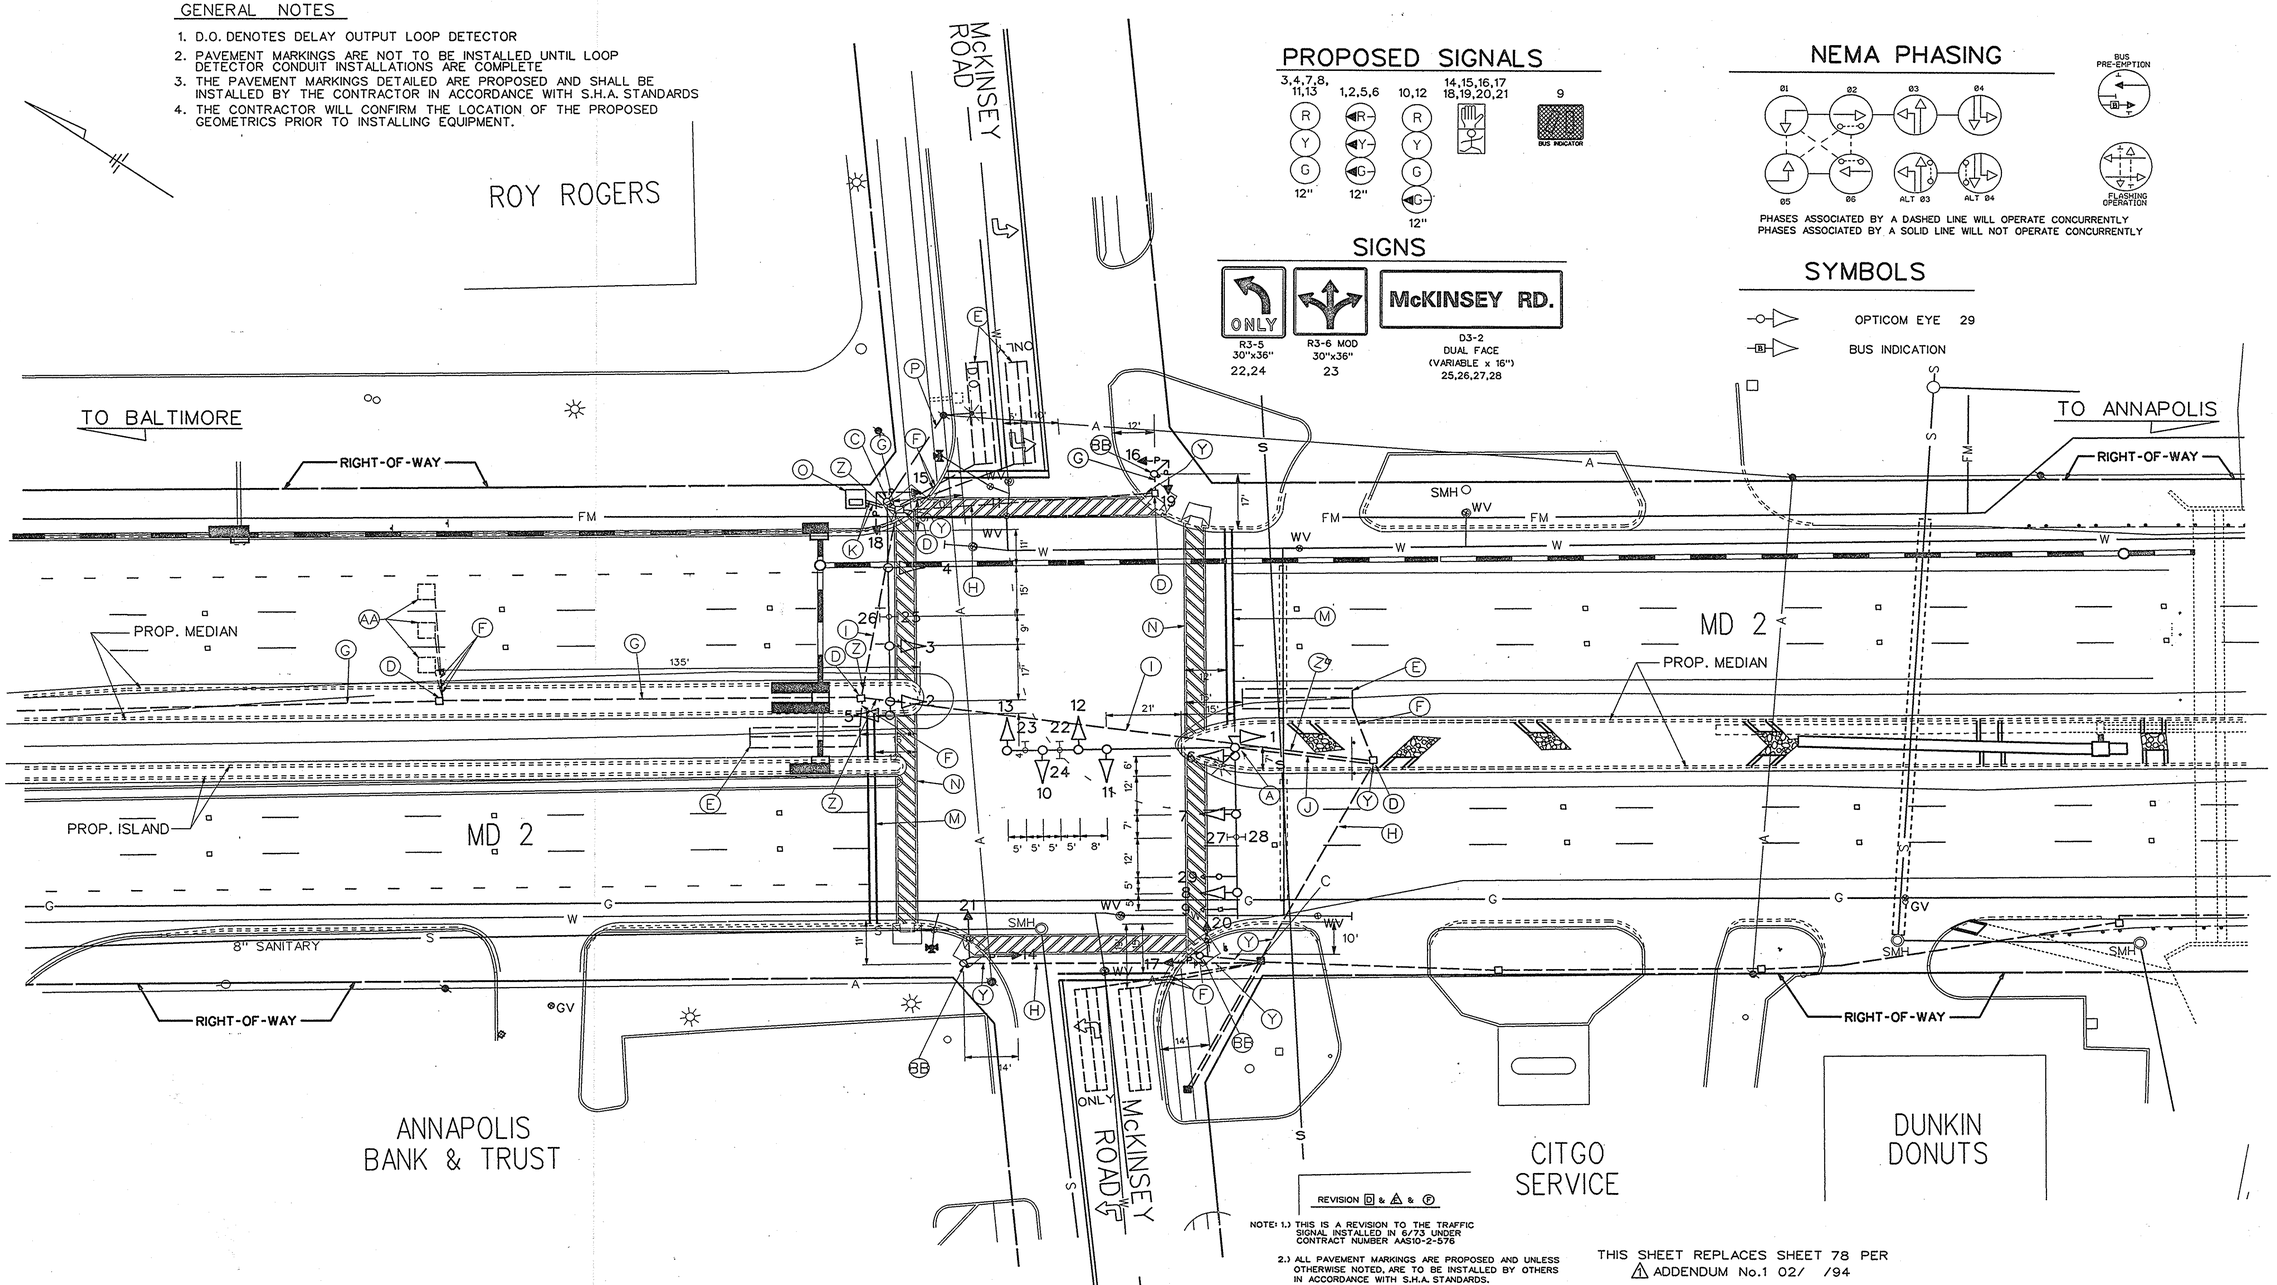

PROPOSED SIGNALS

3,4,7,8, 11,13 — R, Y, G — 12"
1,2,5,6 — R, Y, G — 12"
10,12 — R, Y, G — 12"
14,15,16,17 18,19,20,21
9 — BUS INDICATOR

SIGNS

ONLY — R3-5 30"x36" — 22,24
R3-6 MOD 30"x36" — 23
McKINSEY RD. — D3-2 DUAL FACE (VARIABLE x 16") — 25,26,27,28

NEMA PHASING

Ø1 Ø2 Ø3 Ø4 Ø5 Ø6 ALT Ø3 ALT Ø4

BUS PRE-EMPTION

FLASHING OPERATION

PHASES ASSOCIATED BY A DASHED LINE WILL OPERATE CONCURRENTLY
PHASES ASSOCIATED BY A SOLID LINE WILL NOT OPERATE CONCURRENTLY

SYMBOLS

OPTICOM EYE 29

BUS INDICATION

REVISION D & △ & F

NOTE: 1.) THIS IS A REVISION TO THE TRAFFIC SIGNAL INSTALLED IN 6/73 UNDER CONTRACT NUMBER AAS10-2-576

2.) ALL PAVEMENT MARKINGS ARE PROPOSED AND UNLESS OTHERWISE NOTED, ARE TO BE INSTALLED BY OTHERS IN ACCORDANCE WITH S.H.A. STANDARDS.

THIS SHEET REPLACES SHEET 78 PER △ ADDENDUM No.1 02/ /94

UTILITY LEGEND

G	GAS MAIN
W	WATER MAIN
S	SEWER MAIN
E	ELECTRIC CABLES
A	AERIAL CABLES
T	TELEPHONE CABLES

DANA P. KNIGHT P.E. 15553 DATE

KCI TECHNOLOGIES
KCI TECHNOLOGIES INC.
ENGINEERS AND PLANNERS
10 NORTH PARK DRIVE
HUNT VALLEY, MARYLAND
21030-1888
(410) 316-7800

REVISION
6 REDLINE REVISION No. 6 NEW SHEET 5- -96
REVISION
4 REDLINE REVISION No. 4 NEW SHEET 7- -95
REVISION
3 REDLINE REVISION No. 3 NEW SHEET 11-02-94
F 12-93 REDESIGN FROM SPAN WIRE TO MAST ARM CONFIGURATION DUE TO MD. 2 WIDENING

REVISION
△ 1-27-87 REVISE DESIGN TO ACCOMMODATE NEW LEFT TURN BAY SHA NO. BW-936-801-512
D 5-21-86 ADD 4 SEC. SIGNALS FOR SIDE STREET SPLIT PHASE SHA NO. 855-26000
C 11-20-84 ADD PEDESTRIAN SIGNALS ACROSS THE SOUTH SIDE OF NO. 2 SHA NO. 855-25002
B 4-17-74 ASBUILT & REDRAWN

APPROVALS

ORIGINAL
CHIEF, SIGNAL DESIGN SECTION

ON
ASST. DISTRICT ENGINEER, TRAFFIC

FILE
CHIEF, TRAFFIC ENGINEERING DESIGN DIVISION

DIRECTOR, OFFICE OF TRAFFIC & SAFETY

MDOT - STATE HIGHWAY ADMINISTRATION
OFFICE OF TRAFFIC & SAFETY
TRAFFIC ENGINEERING DESIGN DIVISION

DRAWN BY: F DEBELIUS
DES. BY: W. RICHARDSON
CHK. BY: W. FITCH

MD. 2 AND McKINSEY ROAD

COUNTY: ANNE ARUNDEL

DATE: 4/2/73 F.A.P. NO. T 8005 (2)
SCALE: 1" = 20' S.H.A. NO. AA810-2-576

TS/STD. NO. TS-303 F

SHEET NO. 78C OF 106

Tue May 14 11:50:24 1996 G:\PLOTTING\PS7\QCF/XEROX.qcf Rick Briggs M:\0192056\T-MC.PRF