GENERAL NOTES

1. D.O. DENOTES DELAY OUTPUT LOOP DETECTOR
2. PAVEMENT MARKINGS ARE NOT TO BE INSTALLED UNTIL LOOP DETECTORS CONDUIT INSTALLATIONS ARE COMPLETE.
3. THE PAVEMENT MARKINGS DETAILED ARE PROPOSED AND SHALL BE INSTALLED BY THE CONTRACTOR IN ACCORDANCE WITH S.H.A. STANDARDS.
4. REVISION "D" IDS A REVISION TO THE TRAFFIC CONTROL SIGNAL BUILT IN 4/73 UNDER CONTRACT No. AA 810-2-576.
5. THE CONTRACTOR SHALL CONFIRM THE LOCATION OF PROPOSED GEOMETRICS PRIOR TO INSTALLING EQUIPMENT.

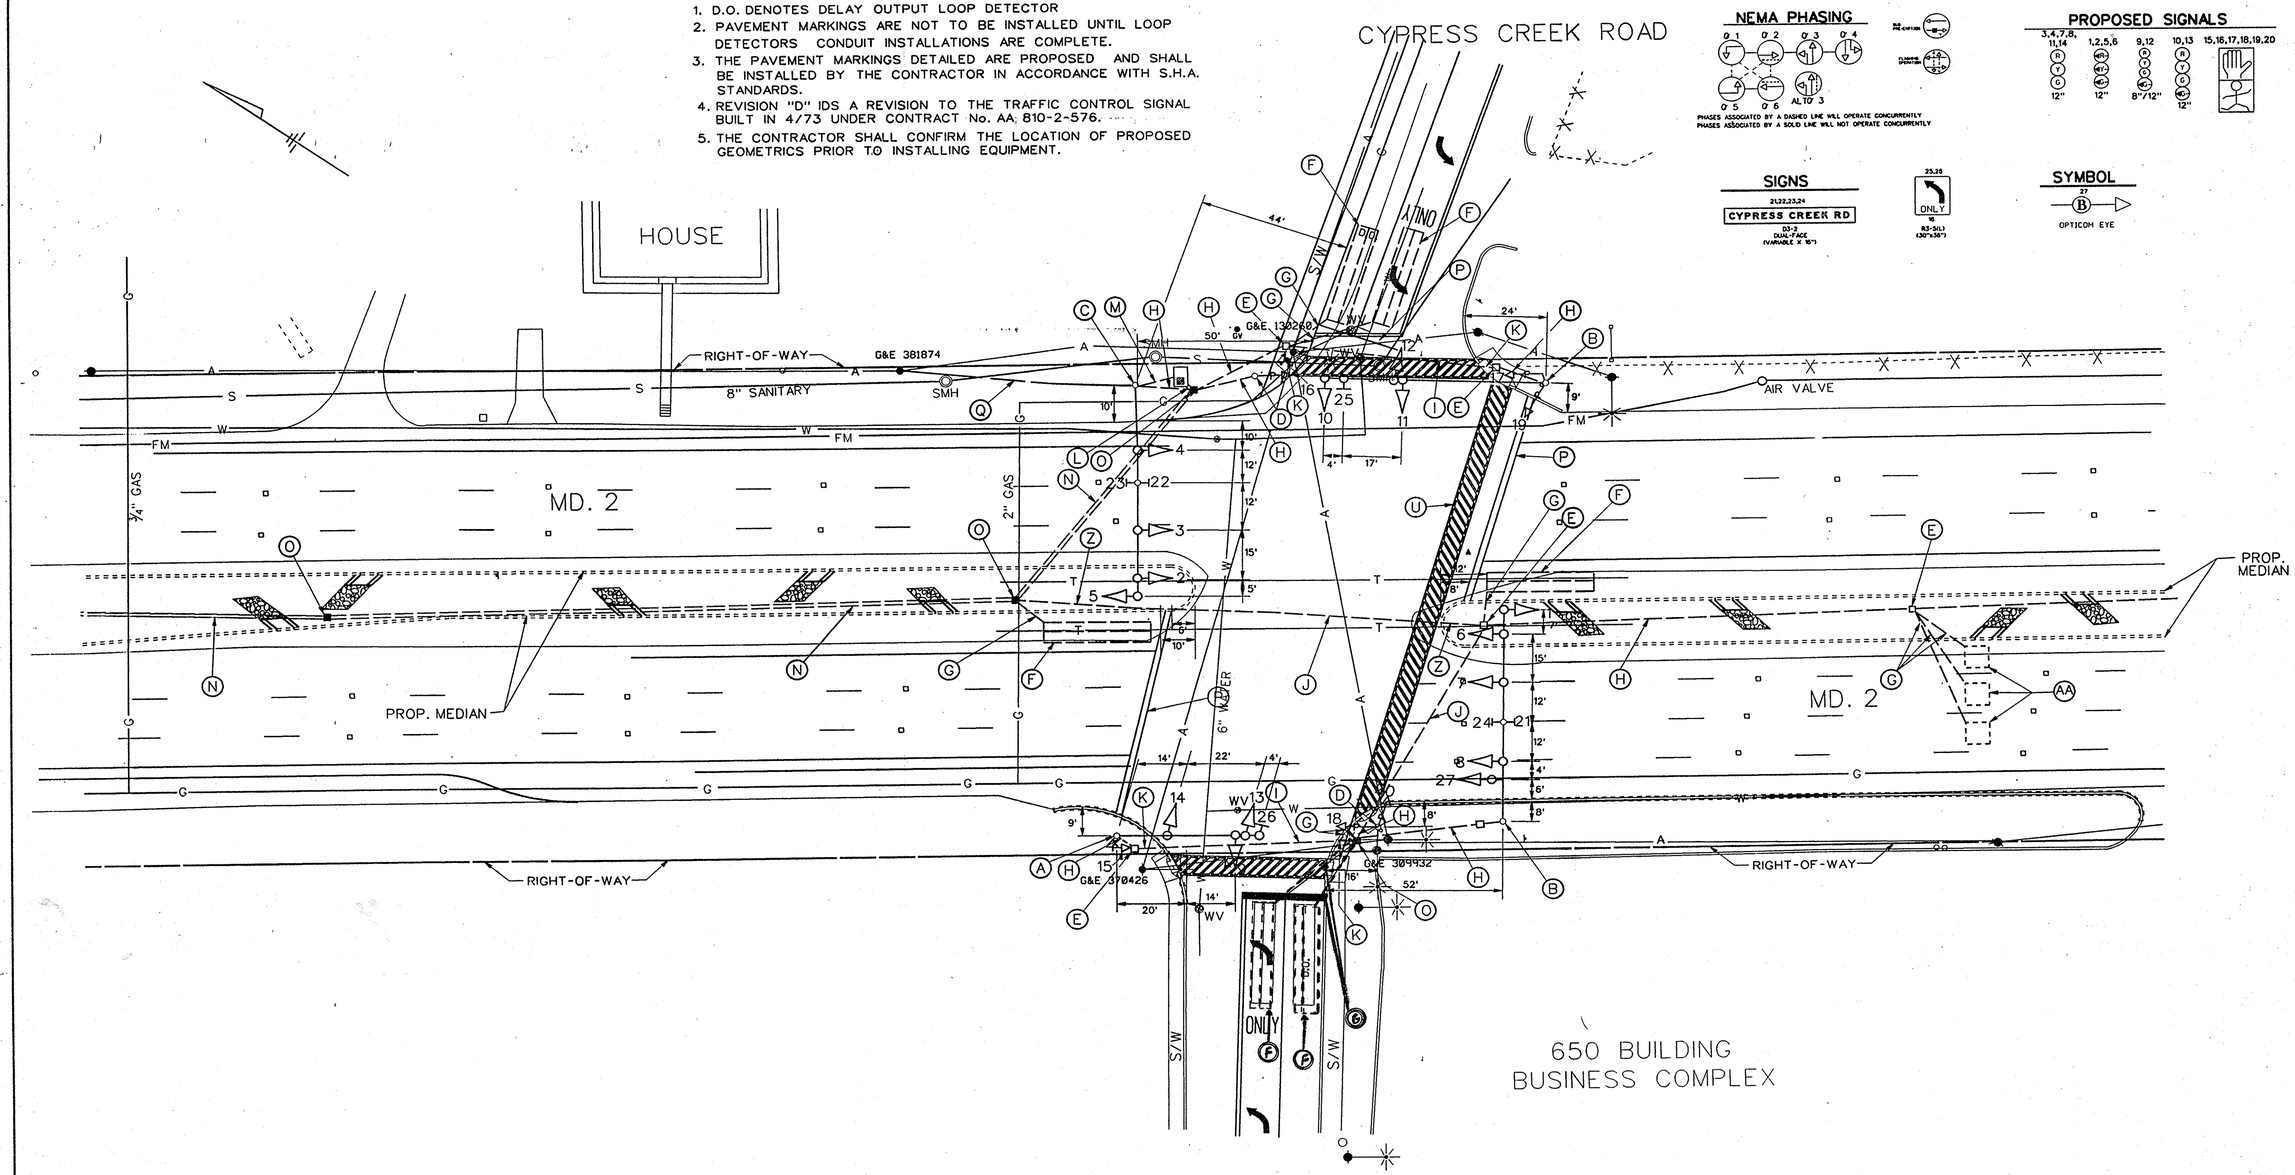

2 REDLINE REVISION No. 2
NEW SHEET
E Install loops for EB Cypress Creek 11/18/94

THIS SHEET REPLACES SHEET 80 PER
1 ADDENDUM No. 1 02/ /94

UTILITY LEGEND

—G—G—	GAS MAIN
—W—W—	WATER MAIN
—S—S—	SEWER MAIN
—E—E—	ELECTRIC CABLES
—A—A—	AERIAL CABLES
—T—T—	TELEPHONE CABLES

DANA P. KNIGHT P.E. 15553 DATE

KCI TECHNOLOGIES
KCI TECHNOLOGIES INC.
ENGINEERS AND PLANNERS
10 NORTH PARK DRIVE
HUNT VALLEY, MARYLAND
21030-1888
(410) 316-7800

REVISION

D	12-93 Redline Revision R REDESIGN FROM SPAN WIRE TO MAST ARM DESIGN DUE TO MD. 2 WIDENING SHA No. AA 505-501-576
MM	
C	5-21-74 AS BUILT
HJK	
B	6-9-73 REVISED SIGNAL DISPLAY DUE TO RECENT GEOMETRIC CHANGES
JS	JS
A	4-16-73 ADJUSTED SIGNAL DESIGN DUE TO UNDERGROUND UTILITY & REVISED GEOMETRICS
JS	JS AB TH

APPROVALS

ORIGINAL
CHIEF, SIGNAL DESIGN SECTION
ON
ASST. DISTRICT ENGINEER, TRAFFIC
FILE
CHIEF, TRAFFIC ENGINEERING DESIGN DIVISON
DIRECTOR, OFFICE OF TRAFFIC & SAFETY

MDOT - STATE HIGHWAY ADMINISTRATION
OFFICE OF TRAFFIC & SAFETY
TRAFFIC ENGINEERING DESIGN DIVISION

DRAWN BY:	F. DEBELIUS	MD. 2 AND CYPRESS CREEK ROAD	
DES. BY:	W. RICHARDSON		
CHK. BY:	W. FITCH	SIGNAL NO. 02042	COUNTY: ANNE ARUNDEL
DATE:	4-5-73	F.A.P. NO. T-8005(2)	TS/STD. NO. TS-309D
SCALE:	1" = 20'	S.H.A. NO. AA 810-2-576	SHEET NO. 80A OF 106

Jul 28 14:33:26 1994 G:/PLOTTING/PS7/OCF/KCI.dcf Eric Siess tcypres.prf