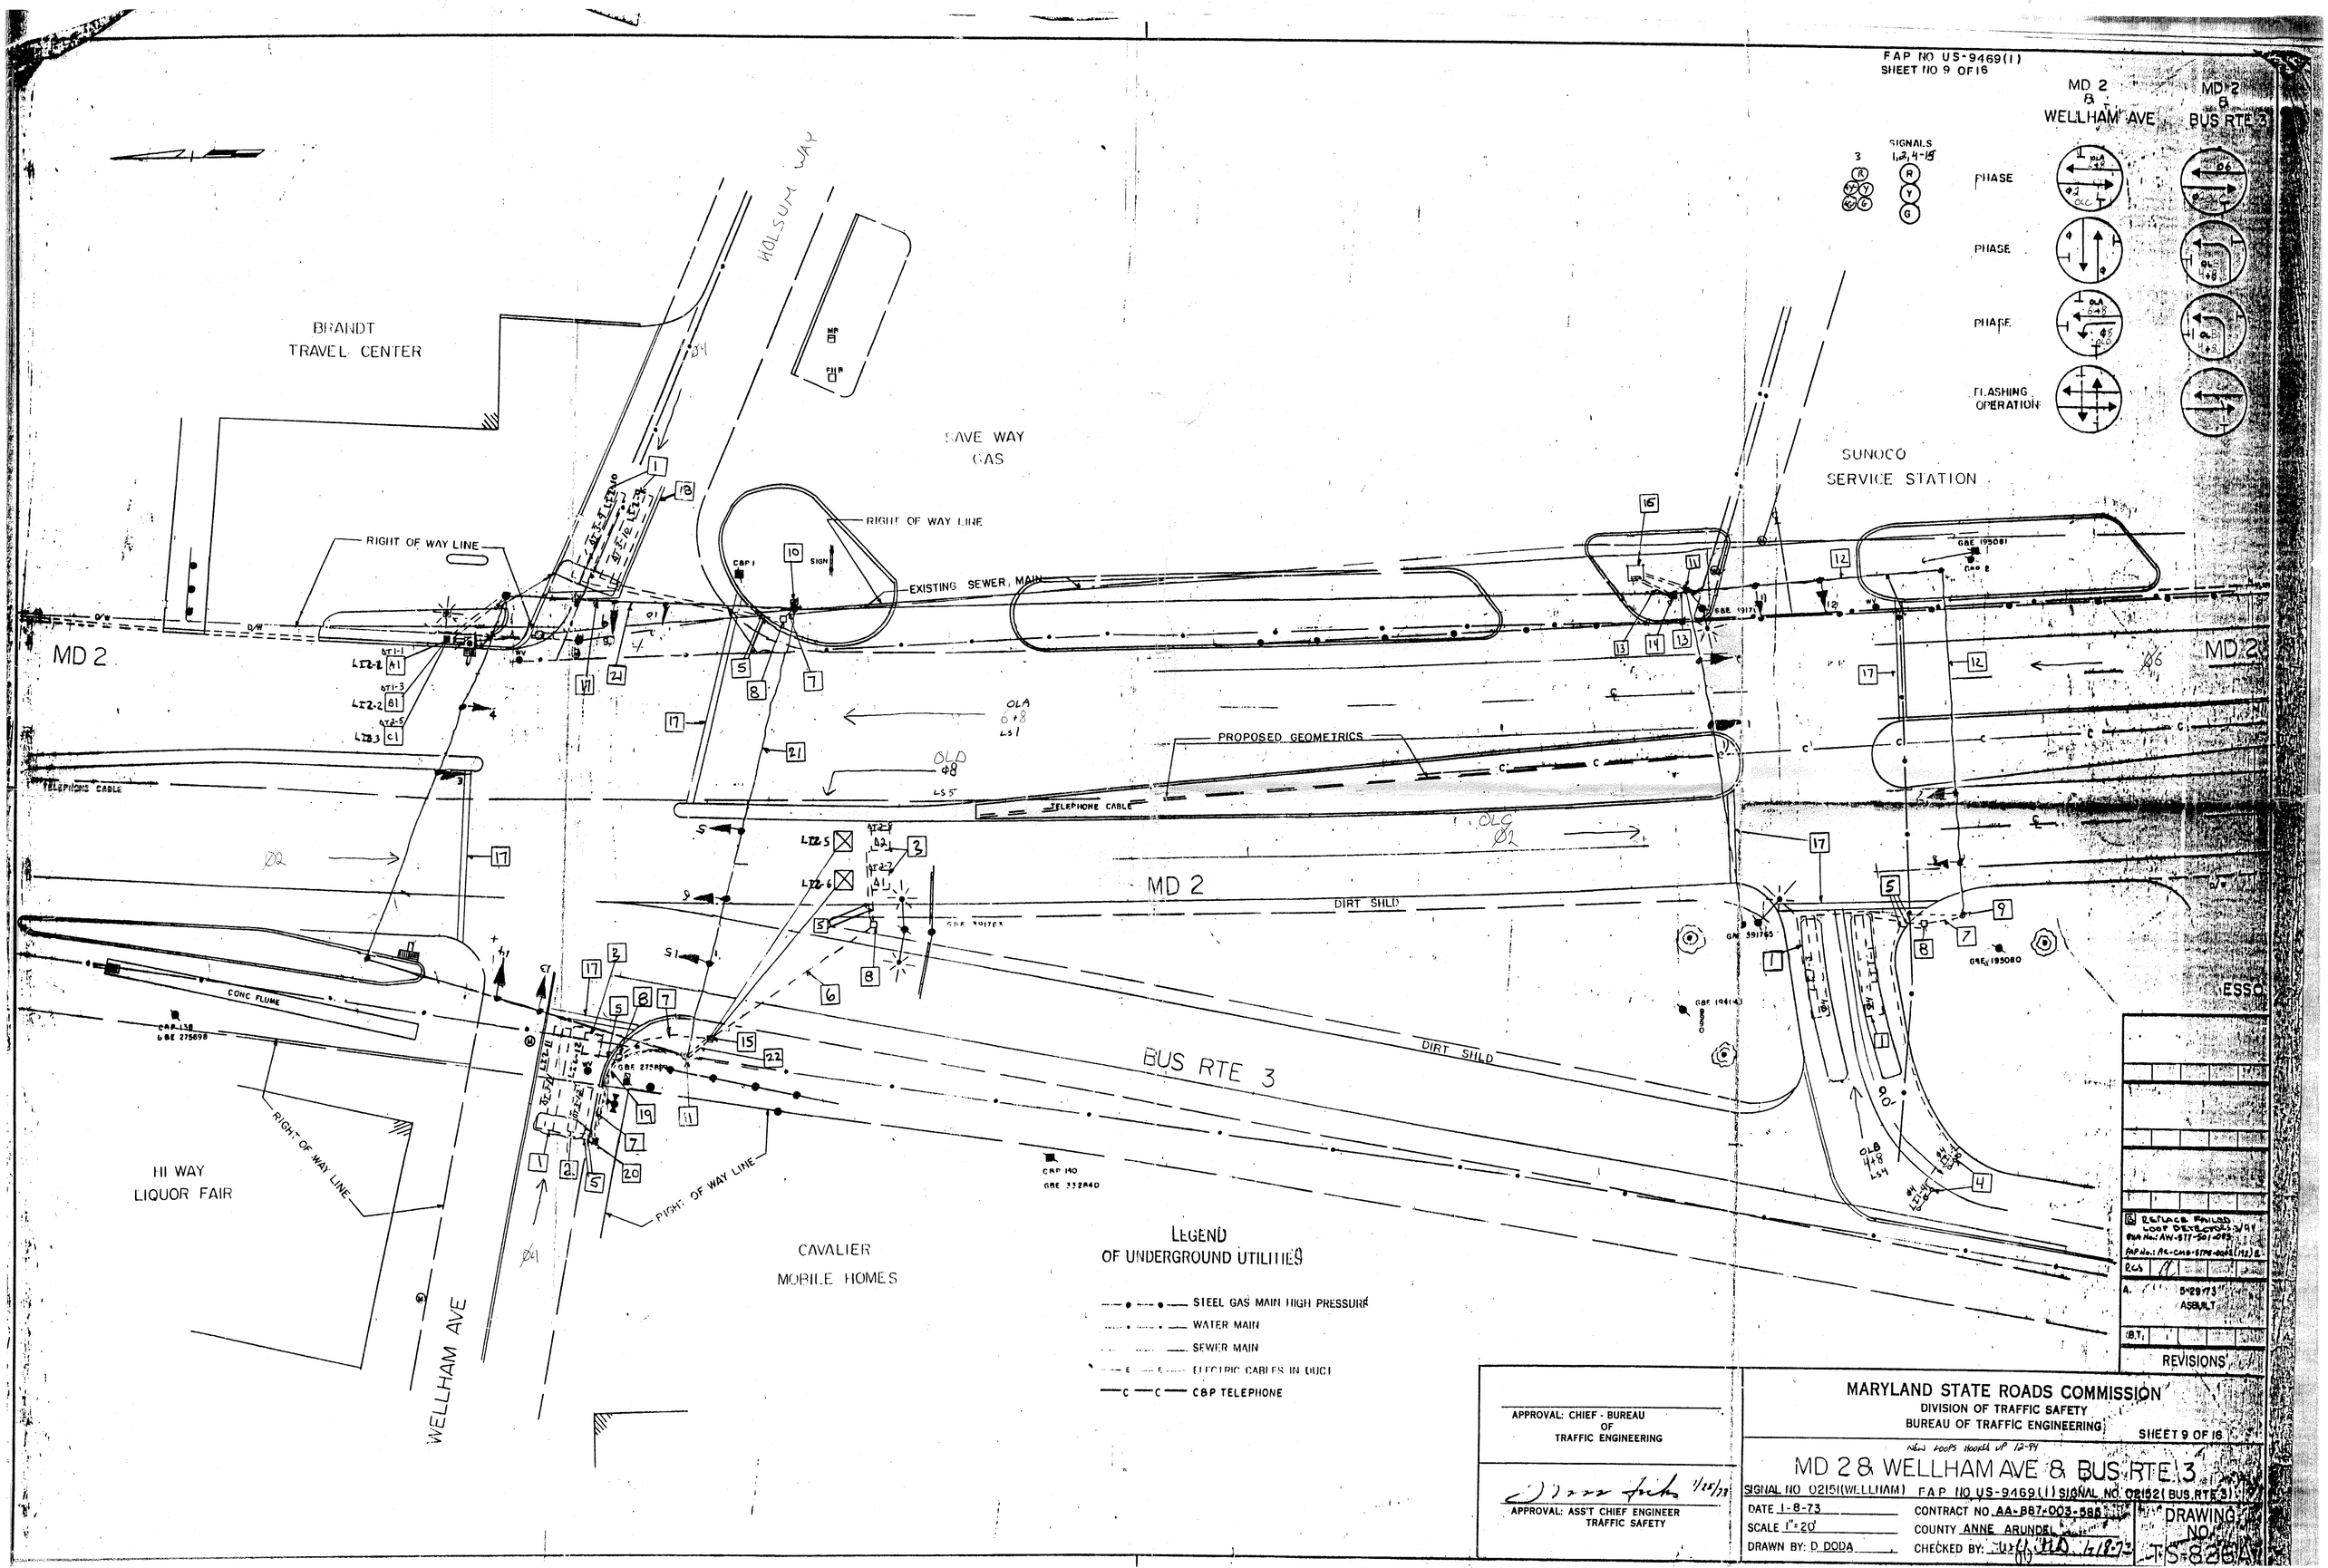
FAP NO US-9469(1)
SHEET NO 9 OF 16
MD 2 & WELLHAM AVE
MD 2 & BUS RTE 3
SIGNALS 1,2,4-15
PHASE
PHASE
PHASE
FLASHING OPERATION
BRANDT TRAVEL CENTER
HOLSUM WAY
SAVE WAY GAS
SUNOCO SERVICE STATION
RIGHT OF WAY LINE
EXISTING SEWER MAIN
MD 2
PROPOSED GEOMETRICS
TELEPHONE CABLE
DIRT SHLD
BUS RTE 3
CONC FLUME
HI WAY LIQUOR FAIR
CAVALIER MOBILE HOMES
WELLHAM AVE
LEGEND OF UNDERGROUND UTILITIES
STEEL GAS MAIN HIGH PRESSURE
WATER MAIN
SEWER MAIN
ELECTRIC CABLES IN DUCT
C&P TELEPHONE
REPLACE FAILED LOOP DETECTORS 3/94
5-29-73 ASBUILT
REVISIONS
APPROVAL: CHIEF - BUREAU OF TRAFFIC ENGINEERING
APPROVAL: ASS'T CHIEF ENGINEER TRAFFIC SAFETY
MARYLAND STATE ROADS COMMISSION
DIVISION OF TRAFFIC SAFETY
BUREAU OF TRAFFIC ENGINEERING
SHEET 9 OF 16
NEW LOOPS HOOKED UP 12-94
MD 2 & WELLHAM AVE & BUS RTE 3
SIGNAL NO 02151(WELLHAM) FAP NO US-9469(1) SIGNAL NO 02152(BUS RTE 3)
DATE 1-8-73
SCALE 1"=20'
DRAWN BY: D DODA
CONTRACT NO AA-887-003-585
COUNTY ANNE ARUNDEL
CHECKED BY:
DRAWING NO. TS-828A