F.H.W.A. REGION NO.	STATE	FED. AID PROJ. NO.	SHEET NO.	TOTAL SHEETS
3	MD.	US-9469(1)	4	16

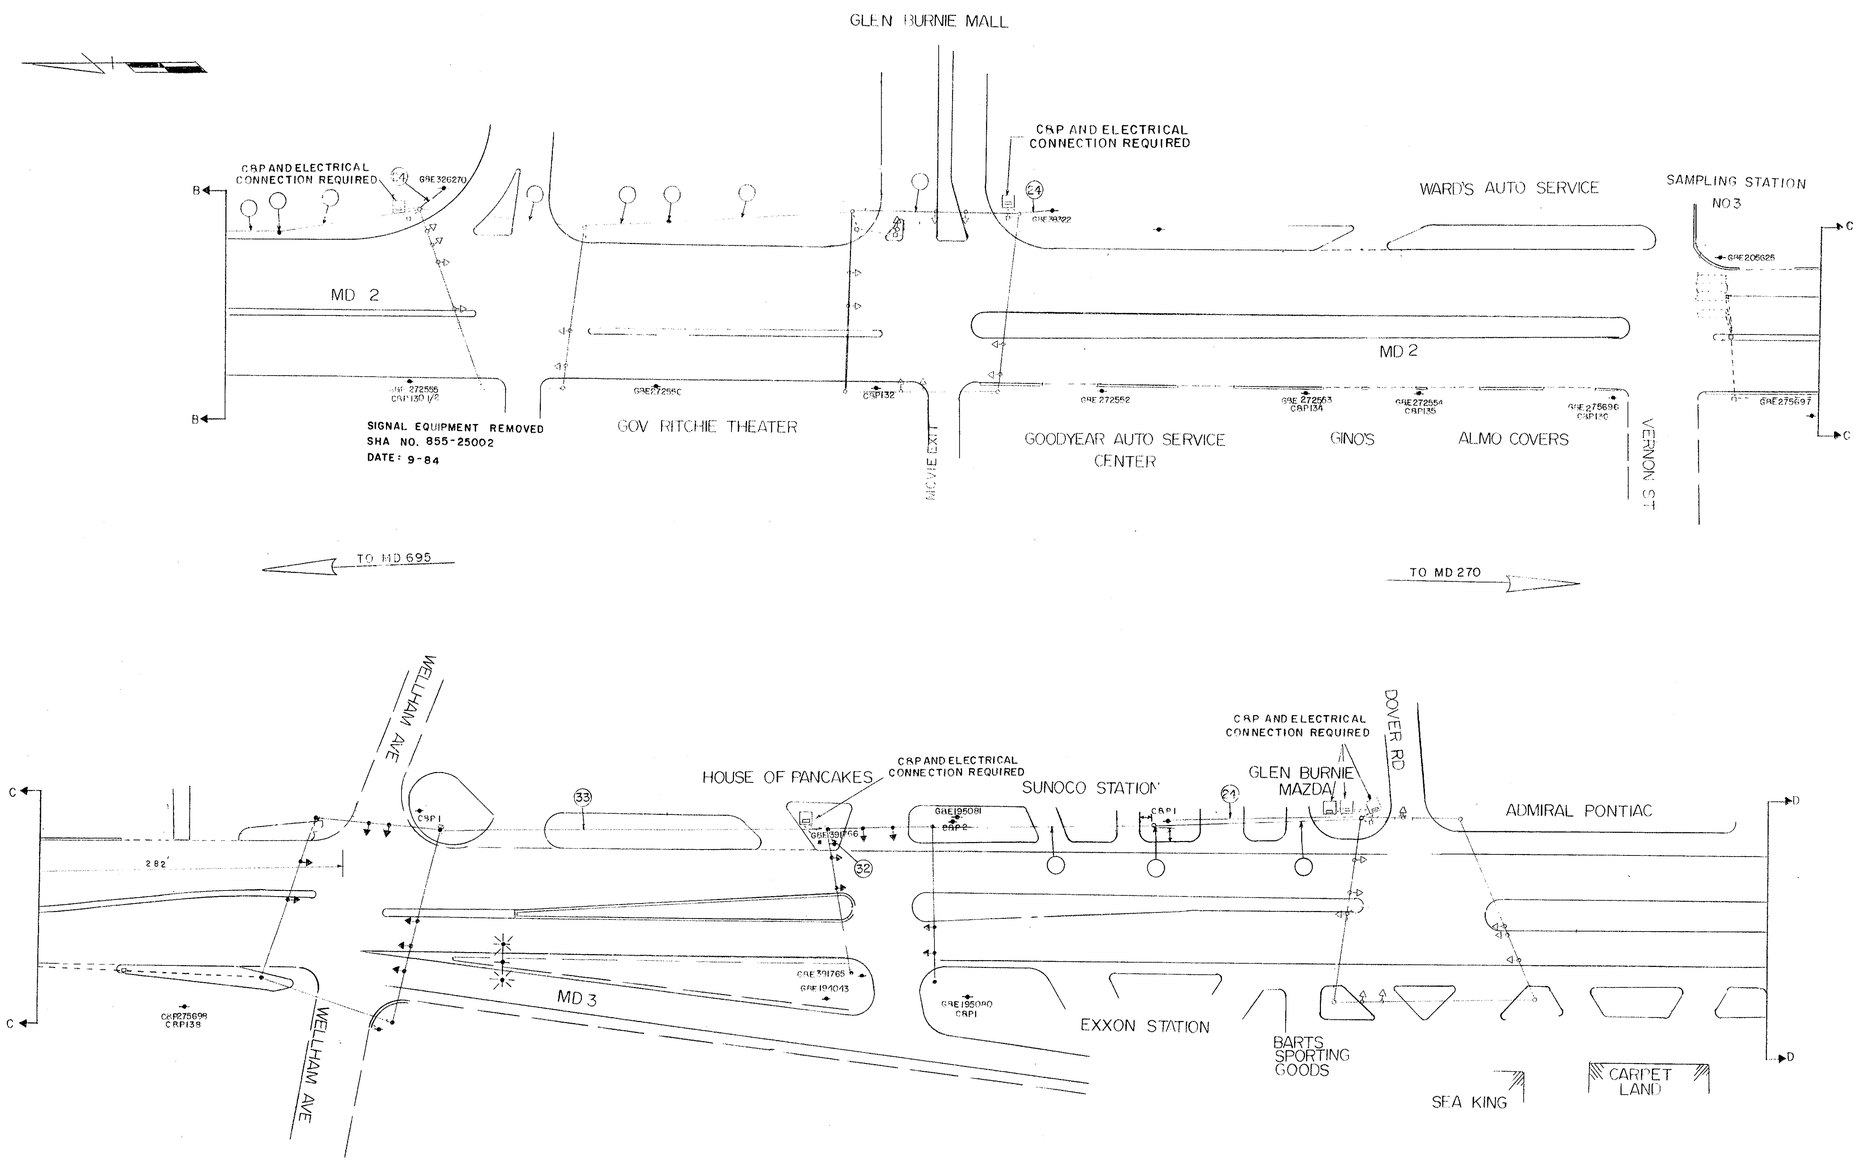

APPROVAL: REGIONAL TRAFFIC ENGINEER

APPROVAL: CHIEF-BUREAU OF TRAFFIC ENGINEERING

APPROVAL: ASS'T. CHIEF ENGINEER TRAFFIC

REVISIONS

STATE OF MARYLAND
DEPARTMENT OF TRANSPORTATION
STATE HIGHWAY ADMINISTRATION

TRAFFIC DIVISION – BUREAU OF TRAFFIC ENGINEERING

MD 2 FROM MD 270 TO MD 695

SHEET 4 OF 16

SCALE 1"=50' DATE 8-31-73 CONTRACT NO. AA-887-003-585
F.A.P. NO. US-9469(1)

DRAWN BY: BT & JG COUNTY: ANNE ARUNDEL

DESIGNED BY: William Richardson SIGNAL NO.:

CHECKED BY:

DRAWING NO. TS-105IXIA

39.10

BRUNING 44-511 19927