F.H.W.A. REGION NO.	STATE	FED. AID PROJ. NO.	SHEET NO.	TOTAL SHEETS
3	MD.			

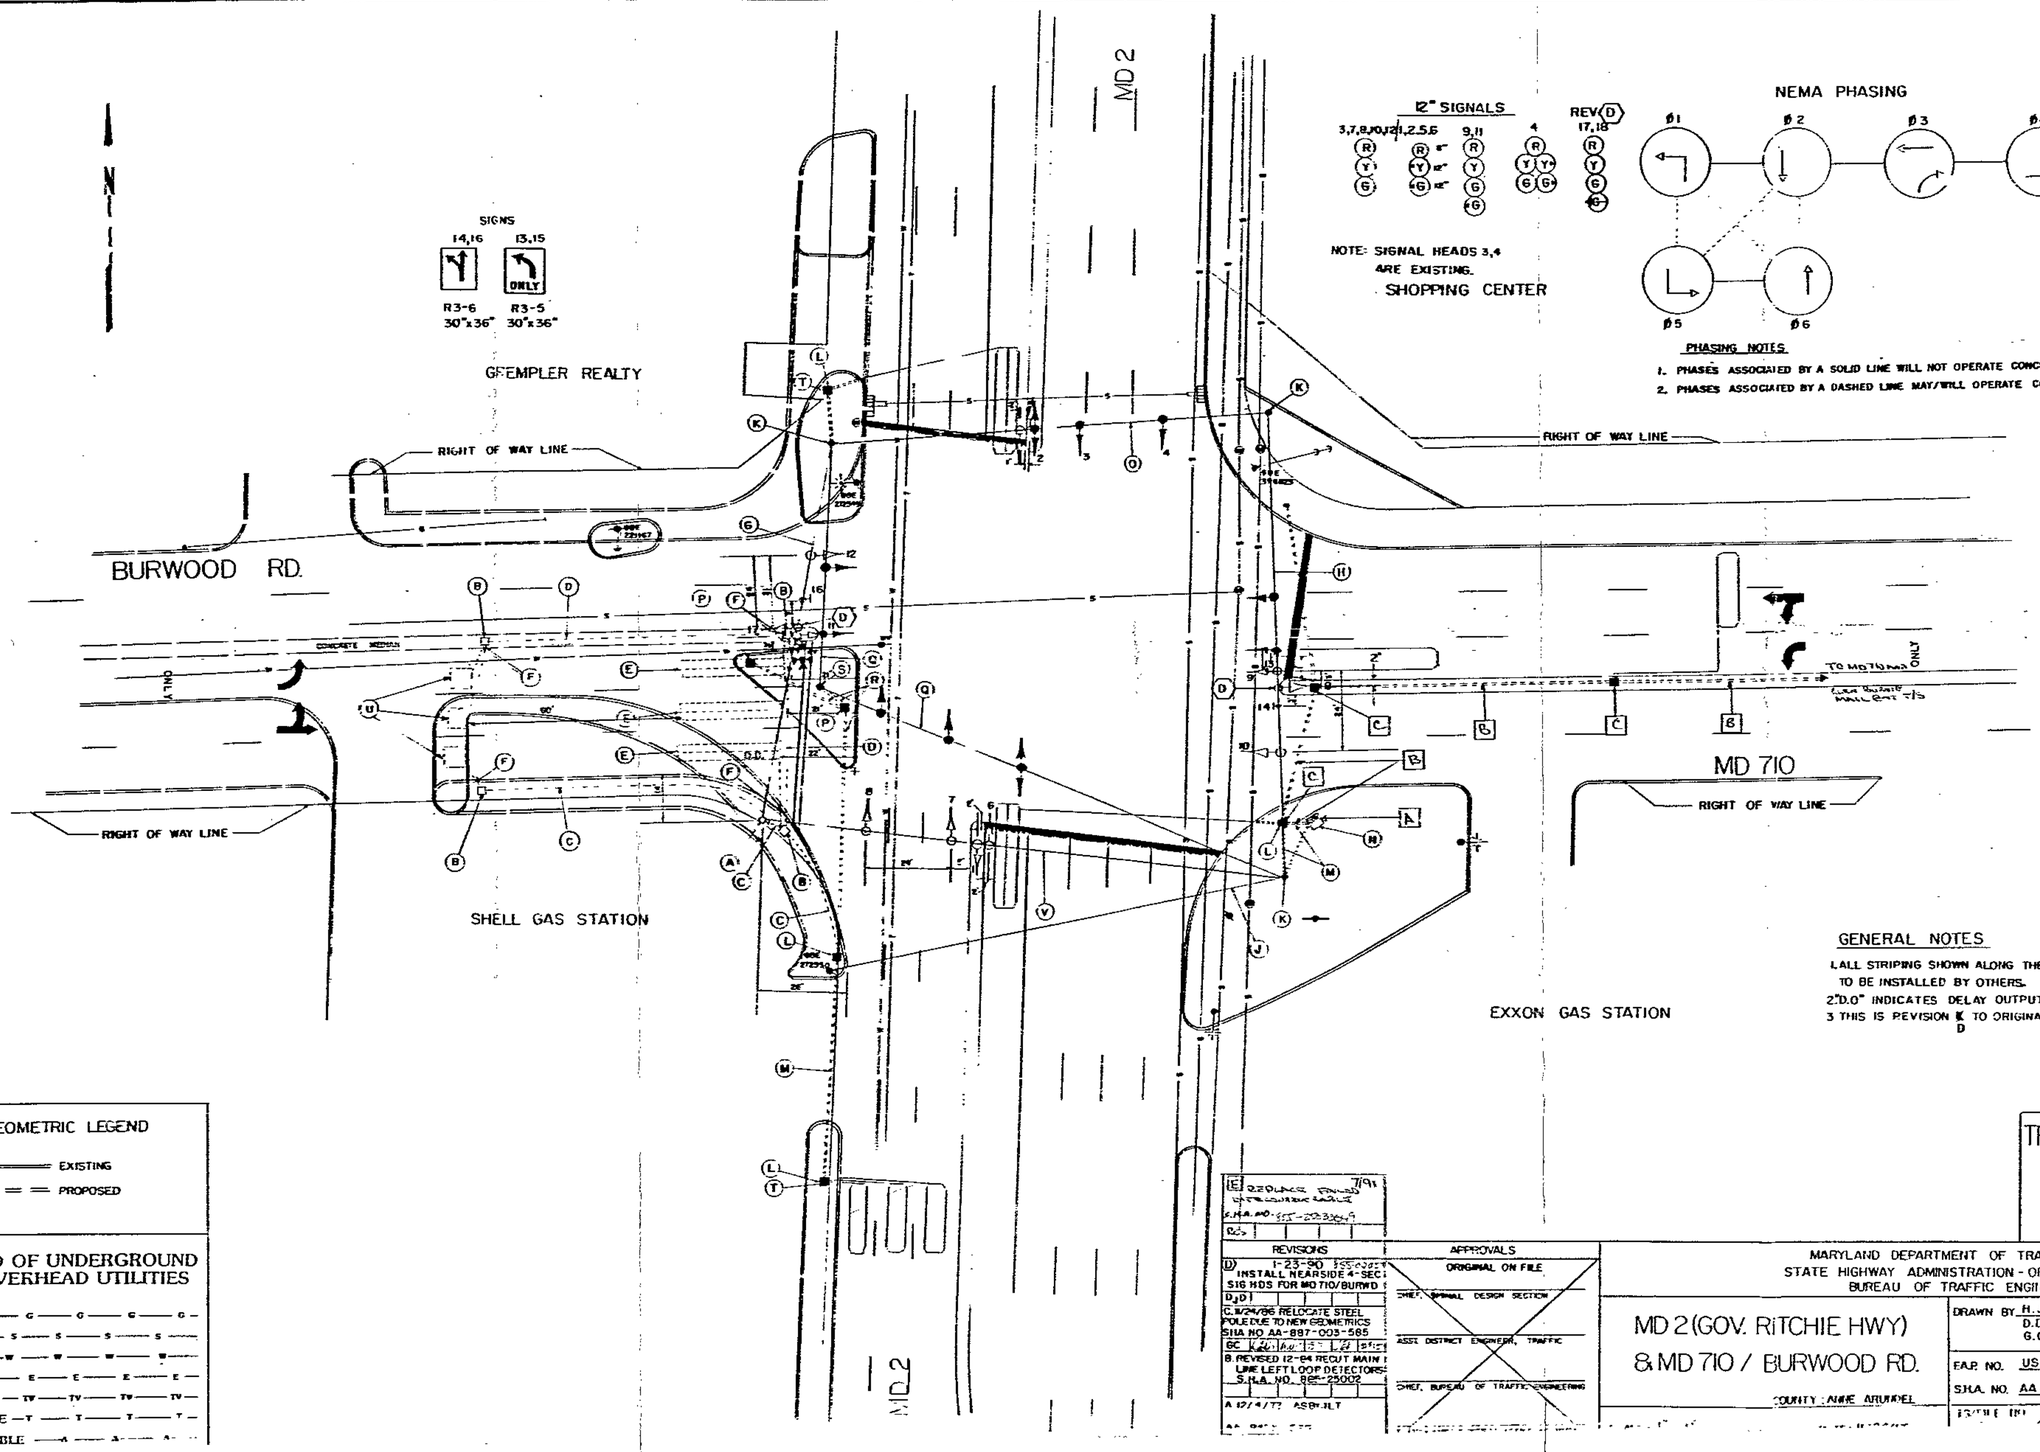

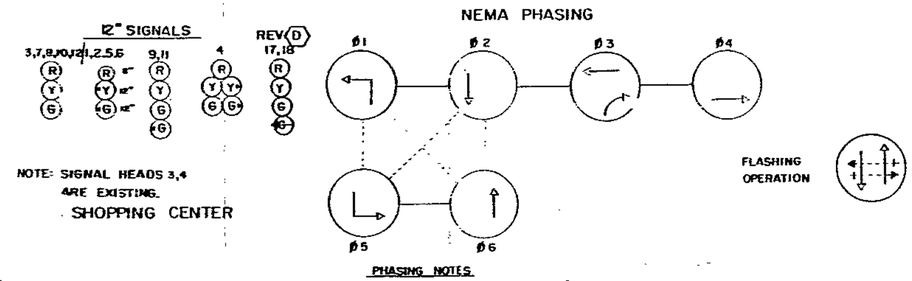

PHASING NOTES

1. PHASES ASSOCIATED BY A SOLID LINE WILL NOT OPERATE CONCURRENTLY.
2. PHASES ASSOCIATED BY A DASHED LINE MAY/WILL OPERATE CONCURRENTLY.

GENERAL NOTES

1. ALL STRIPING SHOWN ALONG THE WEST APPROACH IS PROPOSED AND TO BE INSTALLED BY OTHERS.
2. "D.O" INDICATES DELAY OUTPUT LOOP DETECTOR.
3. THIS IS REVISION ~~K~~ D TO ORIGINAL CONTRACT AA-887-003-585

GEOMETRIC LEGEND

EXISTING

PROPOSED

LEGEND OF UNDERGROUND AND OVERHEAD UTILITIES

GAS — G — G — G — G — G —
SEWER — S — S — S — S —
WATER — W — W — W — W —
ELECTRIC — E — E — E — E —
CABLE TV — TV — TV — TV — TV —
TELEPHONE — T — T — T — T —
AERIAL CABLE — A — A — A —

THE TRAFFIC GROUP, INC.
Suite 220, Greenspring Station
2360 W. Joppa Road
Lutherville, Maryland 21093
Telephone 301-583-8405

REVISIONS	APPROVALS
D) 1-23-90 INSTALL NEARSIDE 4-SEC SIG HDS FOR MD 710/BURWD	ORIGINAL ON FILE
C. 11/24/86 RELOCATE STEEL POLE DUE TO NEW GEOMETRICS SHA NO AA-887-003-585	CHIEF, SIGNAL DESIGN SECTION
B. REVISED 12-84 RECUT MAIN LINE LEFT LOOP DETECTORS S.H.A. NO. 885-25002	ASST. DISTRICT ENGINEER, TRAFFIC
A 12/4/77 ASBUILT	CHIEF, BUREAU OF TRAFFIC ENGINEERING

MARYLAND DEPARTMENT OF TRANSPORTATION
STATE HIGHWAY ADMINISTRATION - OFFICE OF TRAFFIC
BUREAU OF TRAFFIC ENGINEERING

MD 2 (GOV. RITCHIE HWY) & MD 710 / BURWOOD RD.

COUNTY: ANNE ARUNDEL

DRAWN BY H.J. REINHARDT, D.DODA, G.COOK

DES. BY:

CHK. BY:

F.A.P. NO. US-9469(1)

S.H.A. NO. AA-887-003-585

SHEET NO. TS 25/8

0 2000238.89