DIMENSION DIAGRAM

SCALE: 1" = 10'

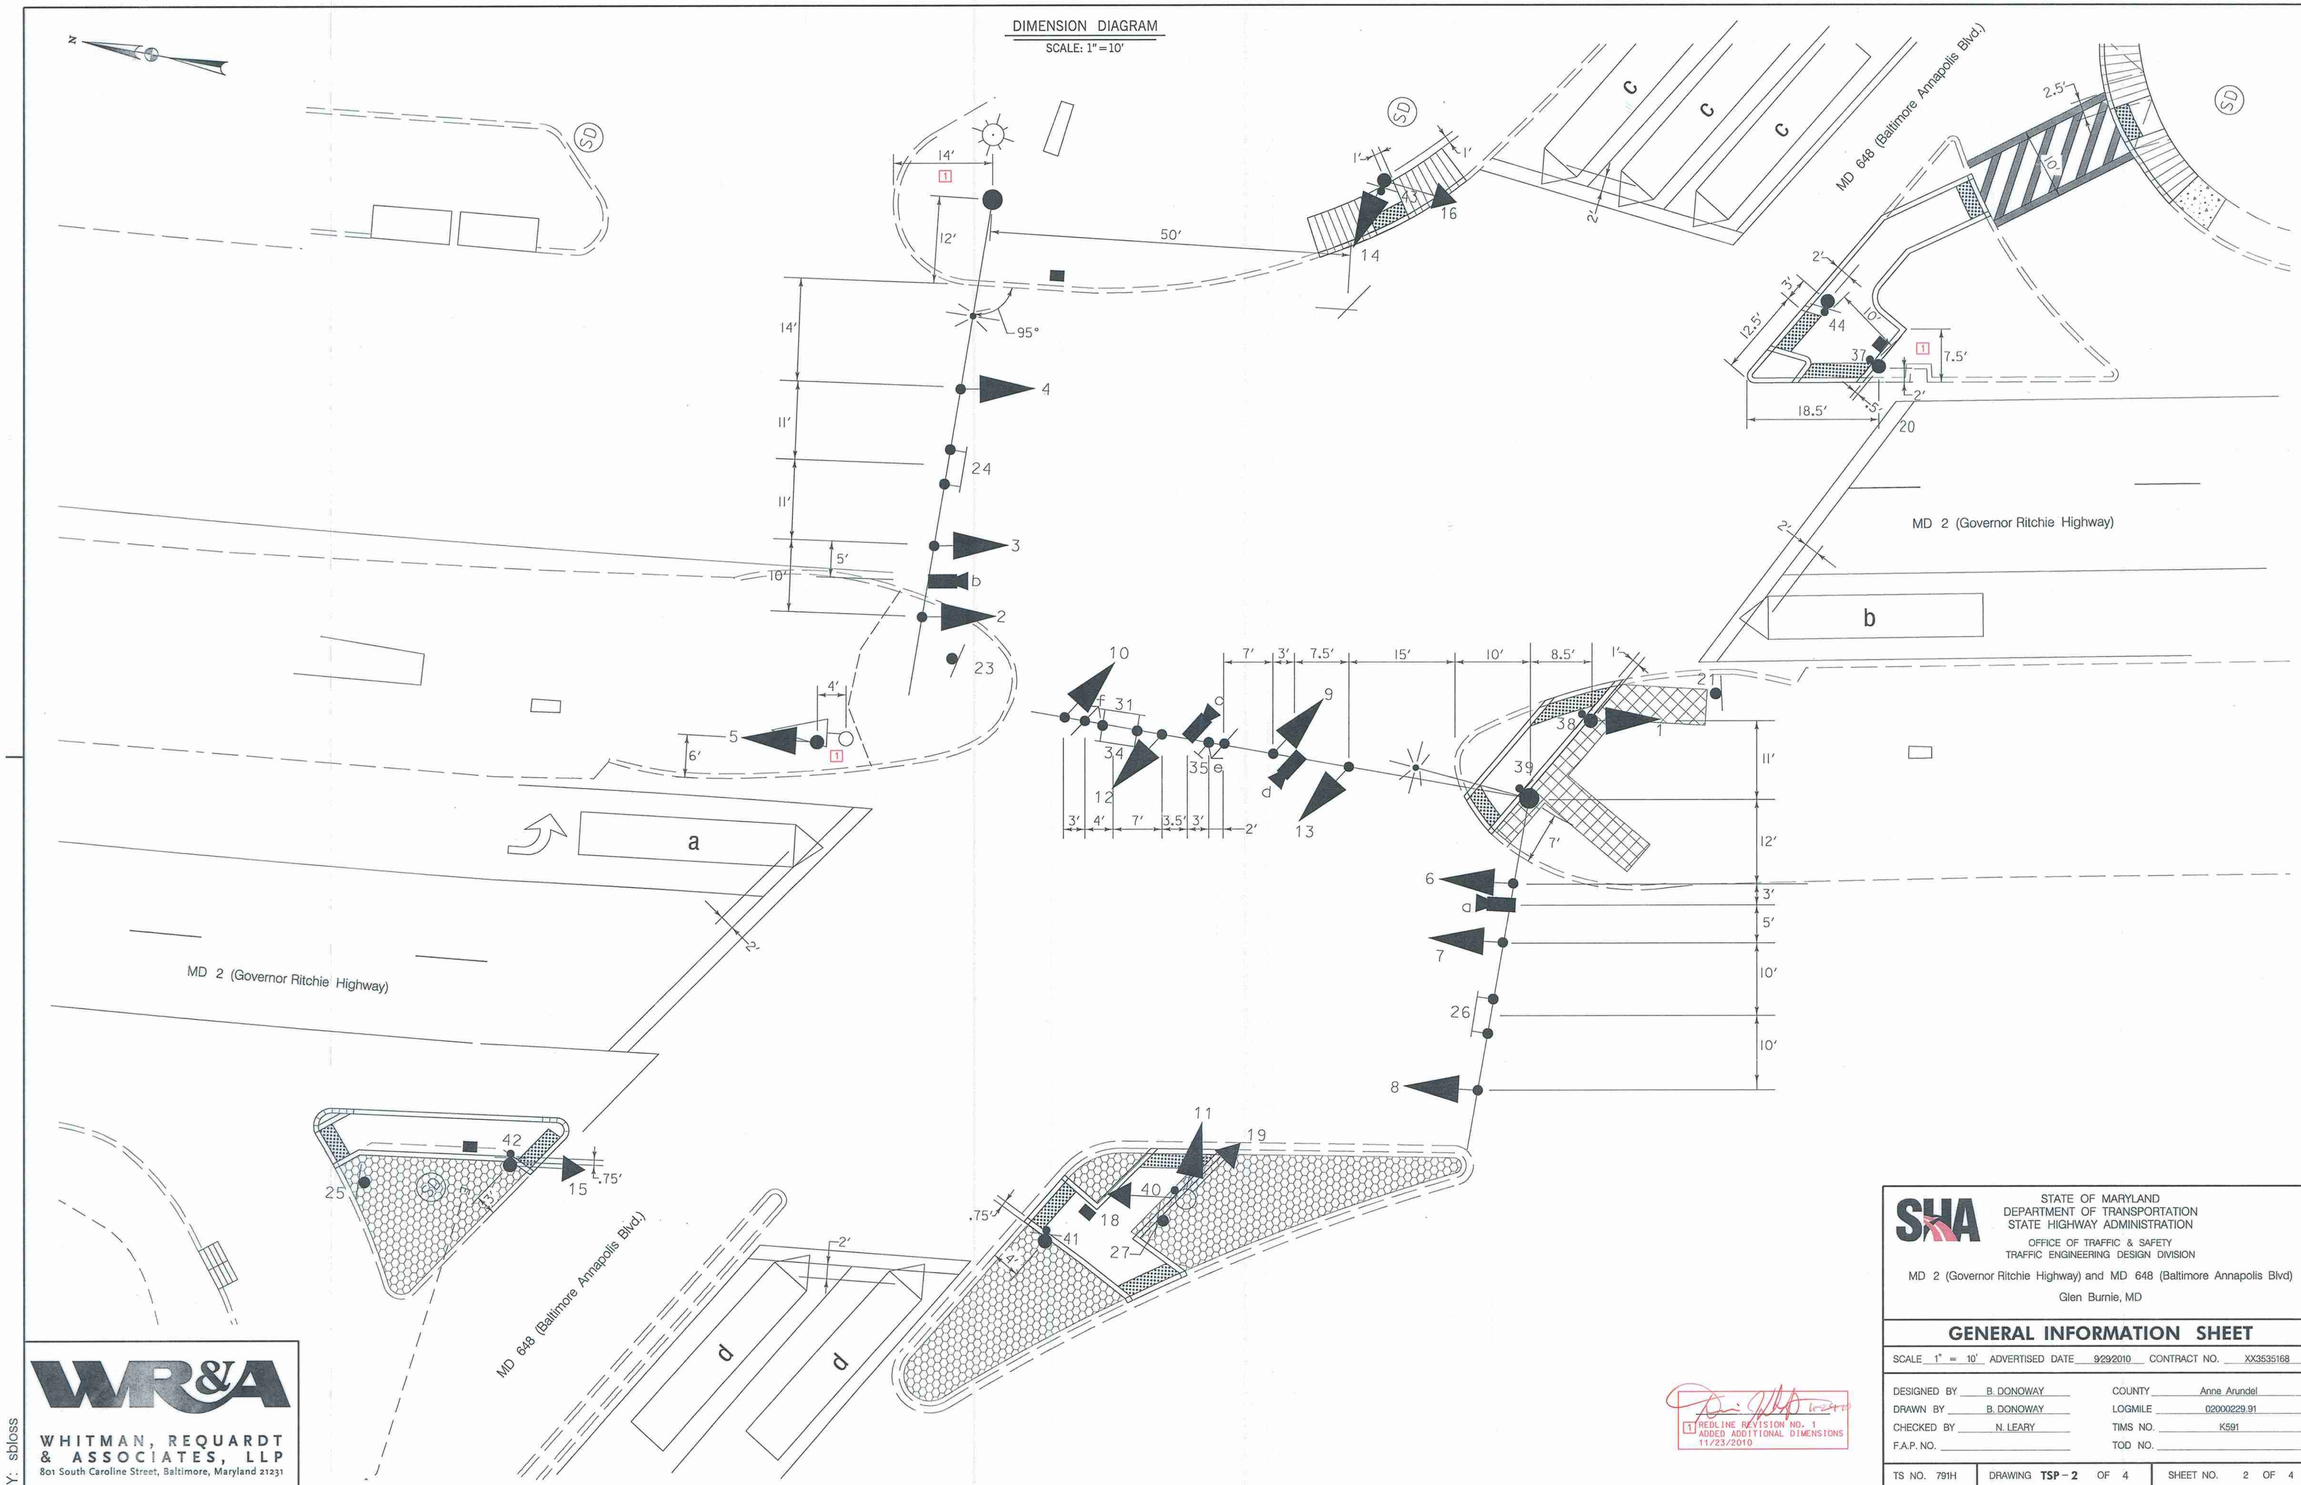

WR&A

WHITMAN, REQUARDT & ASSOCIATES, LLP

801 South Caroline Street, Baltimore, Maryland 21231

BY: sbloss

1 REDLINE REVISION NO. 1
ADDED ADDITIONAL DIMENSIONS
11/23/2010

PLOTTED: 11-23-2010
FILE: N:\31689-081\CADD\µSG-N002_md648.dgn

SHA

STATE OF MARYLAND
DEPARTMENT OF TRANSPORTATION
STATE HIGHWAY ADMINISTRATION

OFFICE OF TRAFFIC & SAFETY
TRAFFIC ENGINEERING DESIGN DIVISION

MD 2 (Governor Ritchie Highway) and MD 648 (Baltimore Annapolis Blvd)

Glen Burnie, MD

GENERAL INFORMATION SHEET

SCALE 1" = 10' ADVERTISED DATE 9/29/2010 CONTRACT NO. XX3535168

DESIGNED BY	B. DONOWAY	COUNTY	Anne Arundel
DRAWN BY	B. DONOWAY	LOGMILE	02000229.91
CHECKED BY	N. LEARY	TIMS NO.	K591
F.A.P. NO.		TOD NO.	

TS NO. 791H	DRAWING TSP – 2 OF 4	SHEET NO. 2 OF 4