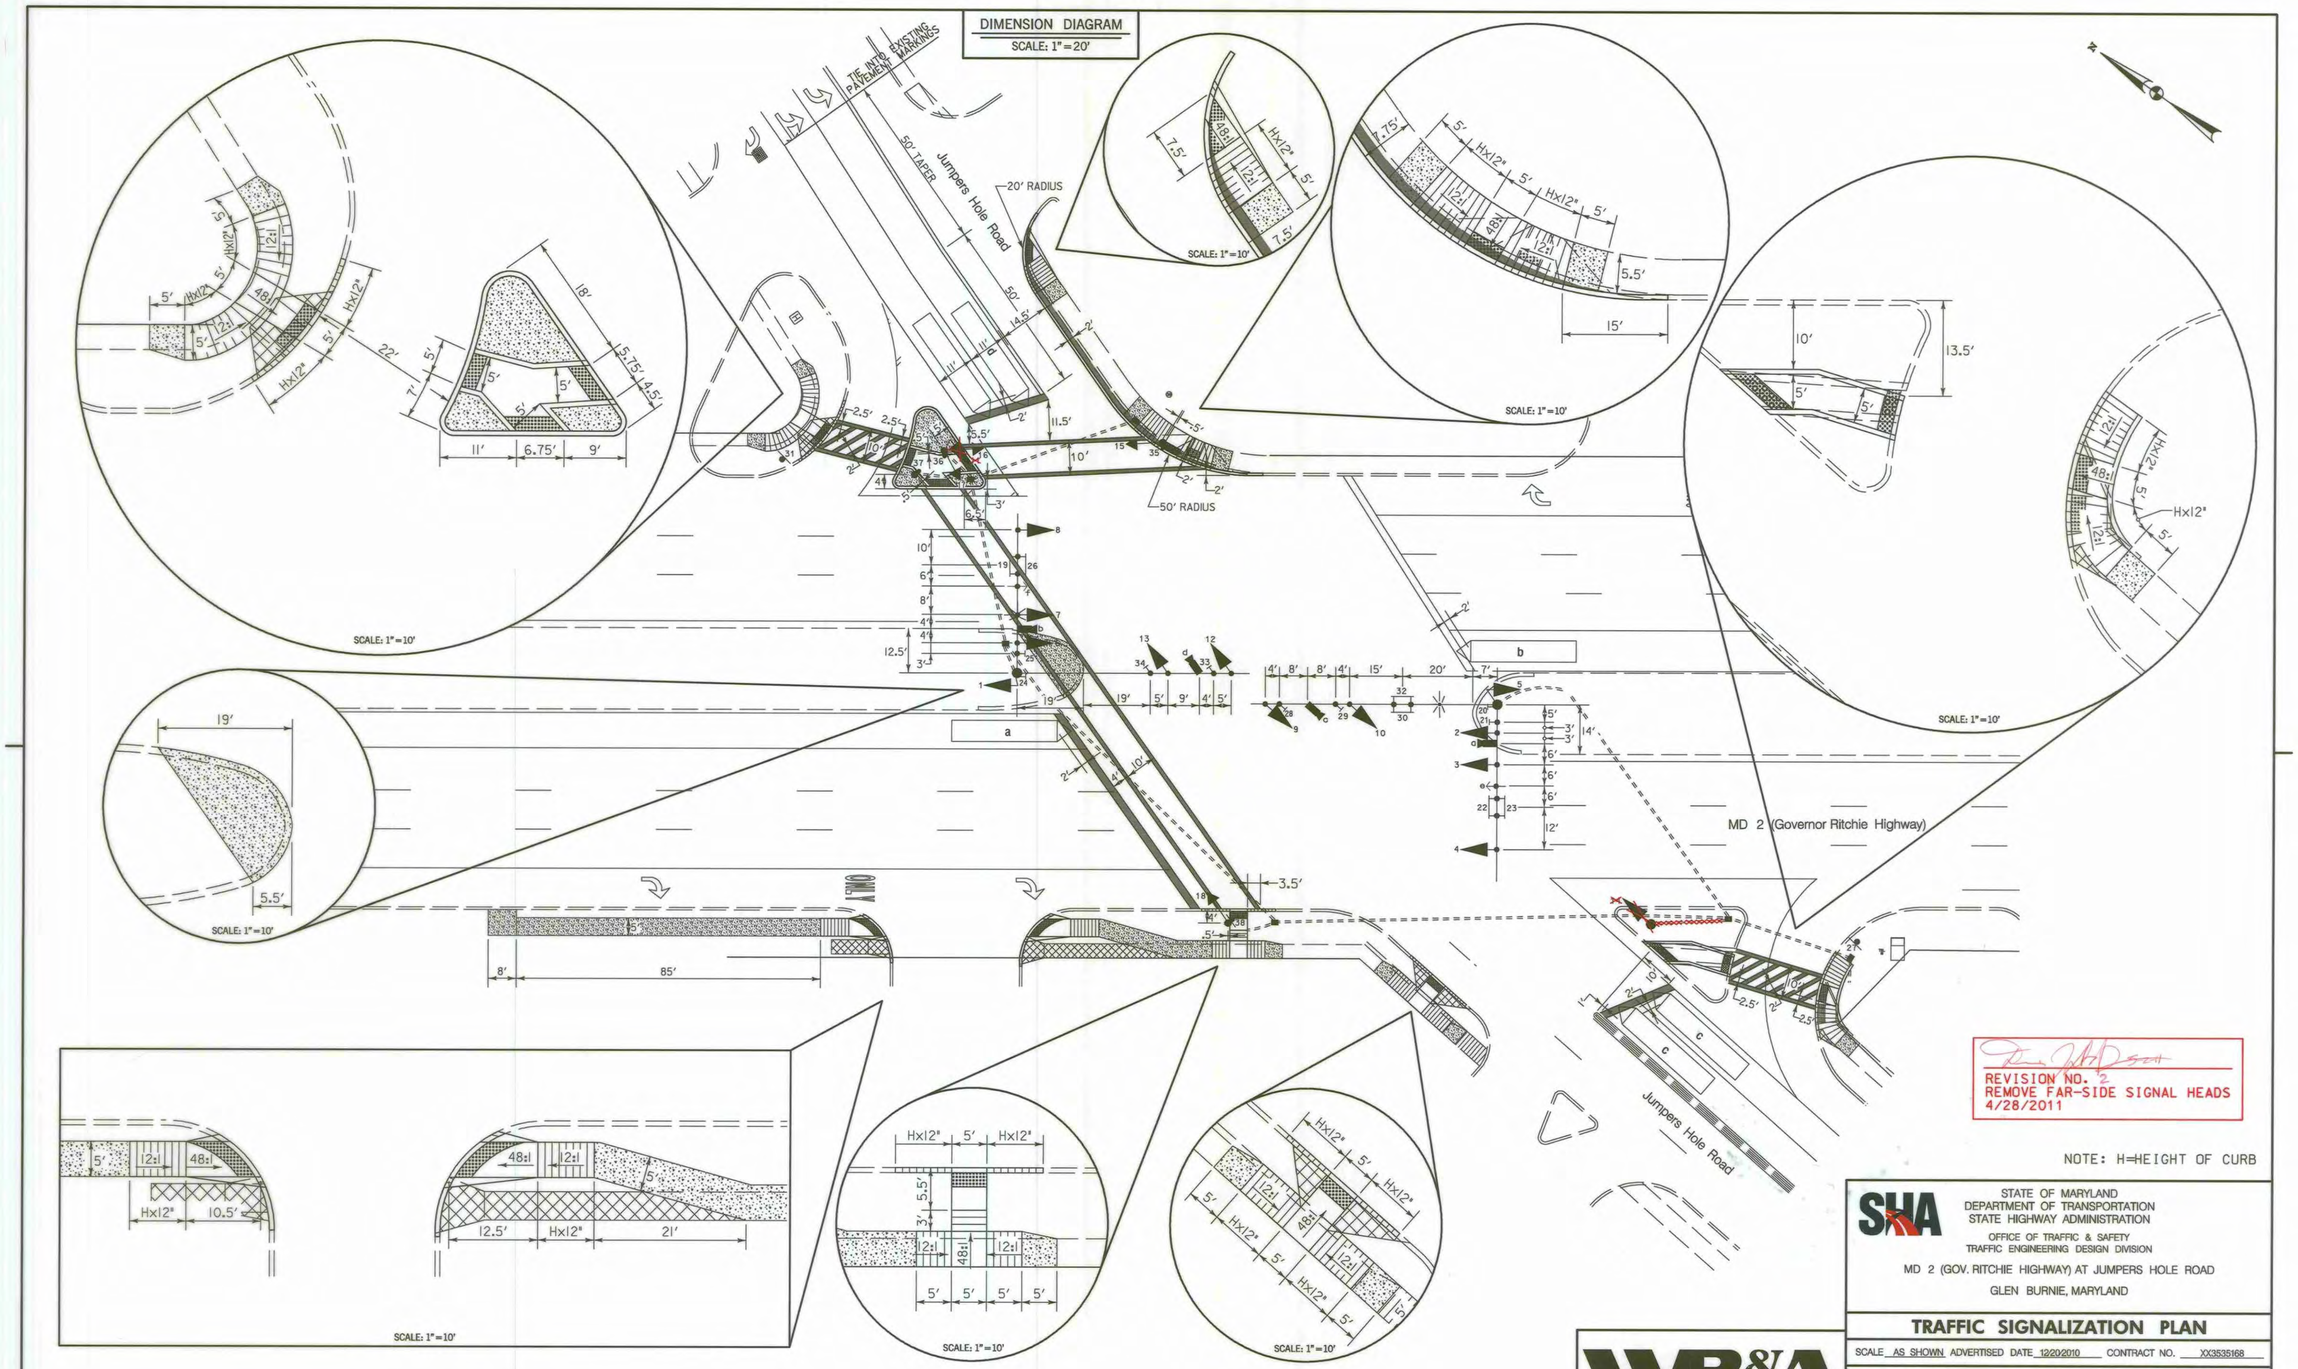

REVISION NO. 2
REMOVE FAR-SIDE SIGNAL HEADS
4/28/2011

NOTE: H=HEIGHT OF CURB

STATE OF MARYLAND
DEPARTMENT OF TRANSPORTATION
STATE HIGHWAY ADMINISTRATION

OFFICE OF TRAFFIC & SAFETY
TRAFFIC ENGINEERING DESIGN DIVISION

MD 2 (GOV. RITCHIE HIGHWAY) AT JUMPERS HOLE ROAD

GLEN BURNIE, MARYLAND

TRAFFIC SIGNALIZATION PLAN

SCALE AS SHOWN ADVERTISED DATE 12/2/2010 CONTRACT NO. XX3535168

DESIGNED BY S. Bloss
DRAWN BY S. Bloss
CHECKED BY N. Leary
F.A.P. NO.

COUNTY ANNE ARUNDEL
LOGMILE 02000233.27
TIMS NO. K594
TOD NO.

TS NO. 155K | DRAWING TSP-2 OF 3 | SHEET NO. 2 OF 3

WHITMAN, REQUARDT & ASSOCIATES, LLP
801 South Caroline Street, Baltimore, Maryland 21231

PLOTTED: 04-29-2011
FILE: n:\31669-091\cadd\redline1\RL1_pSG-N002_K176.dgn

BY: Iwaesche