F.H.W.A. REGION NO.	STATE	FED. AID PROJ. NO.	SHEET NO.	TOTAL SHEETS
3	MD.	T-8005(2)	9	17

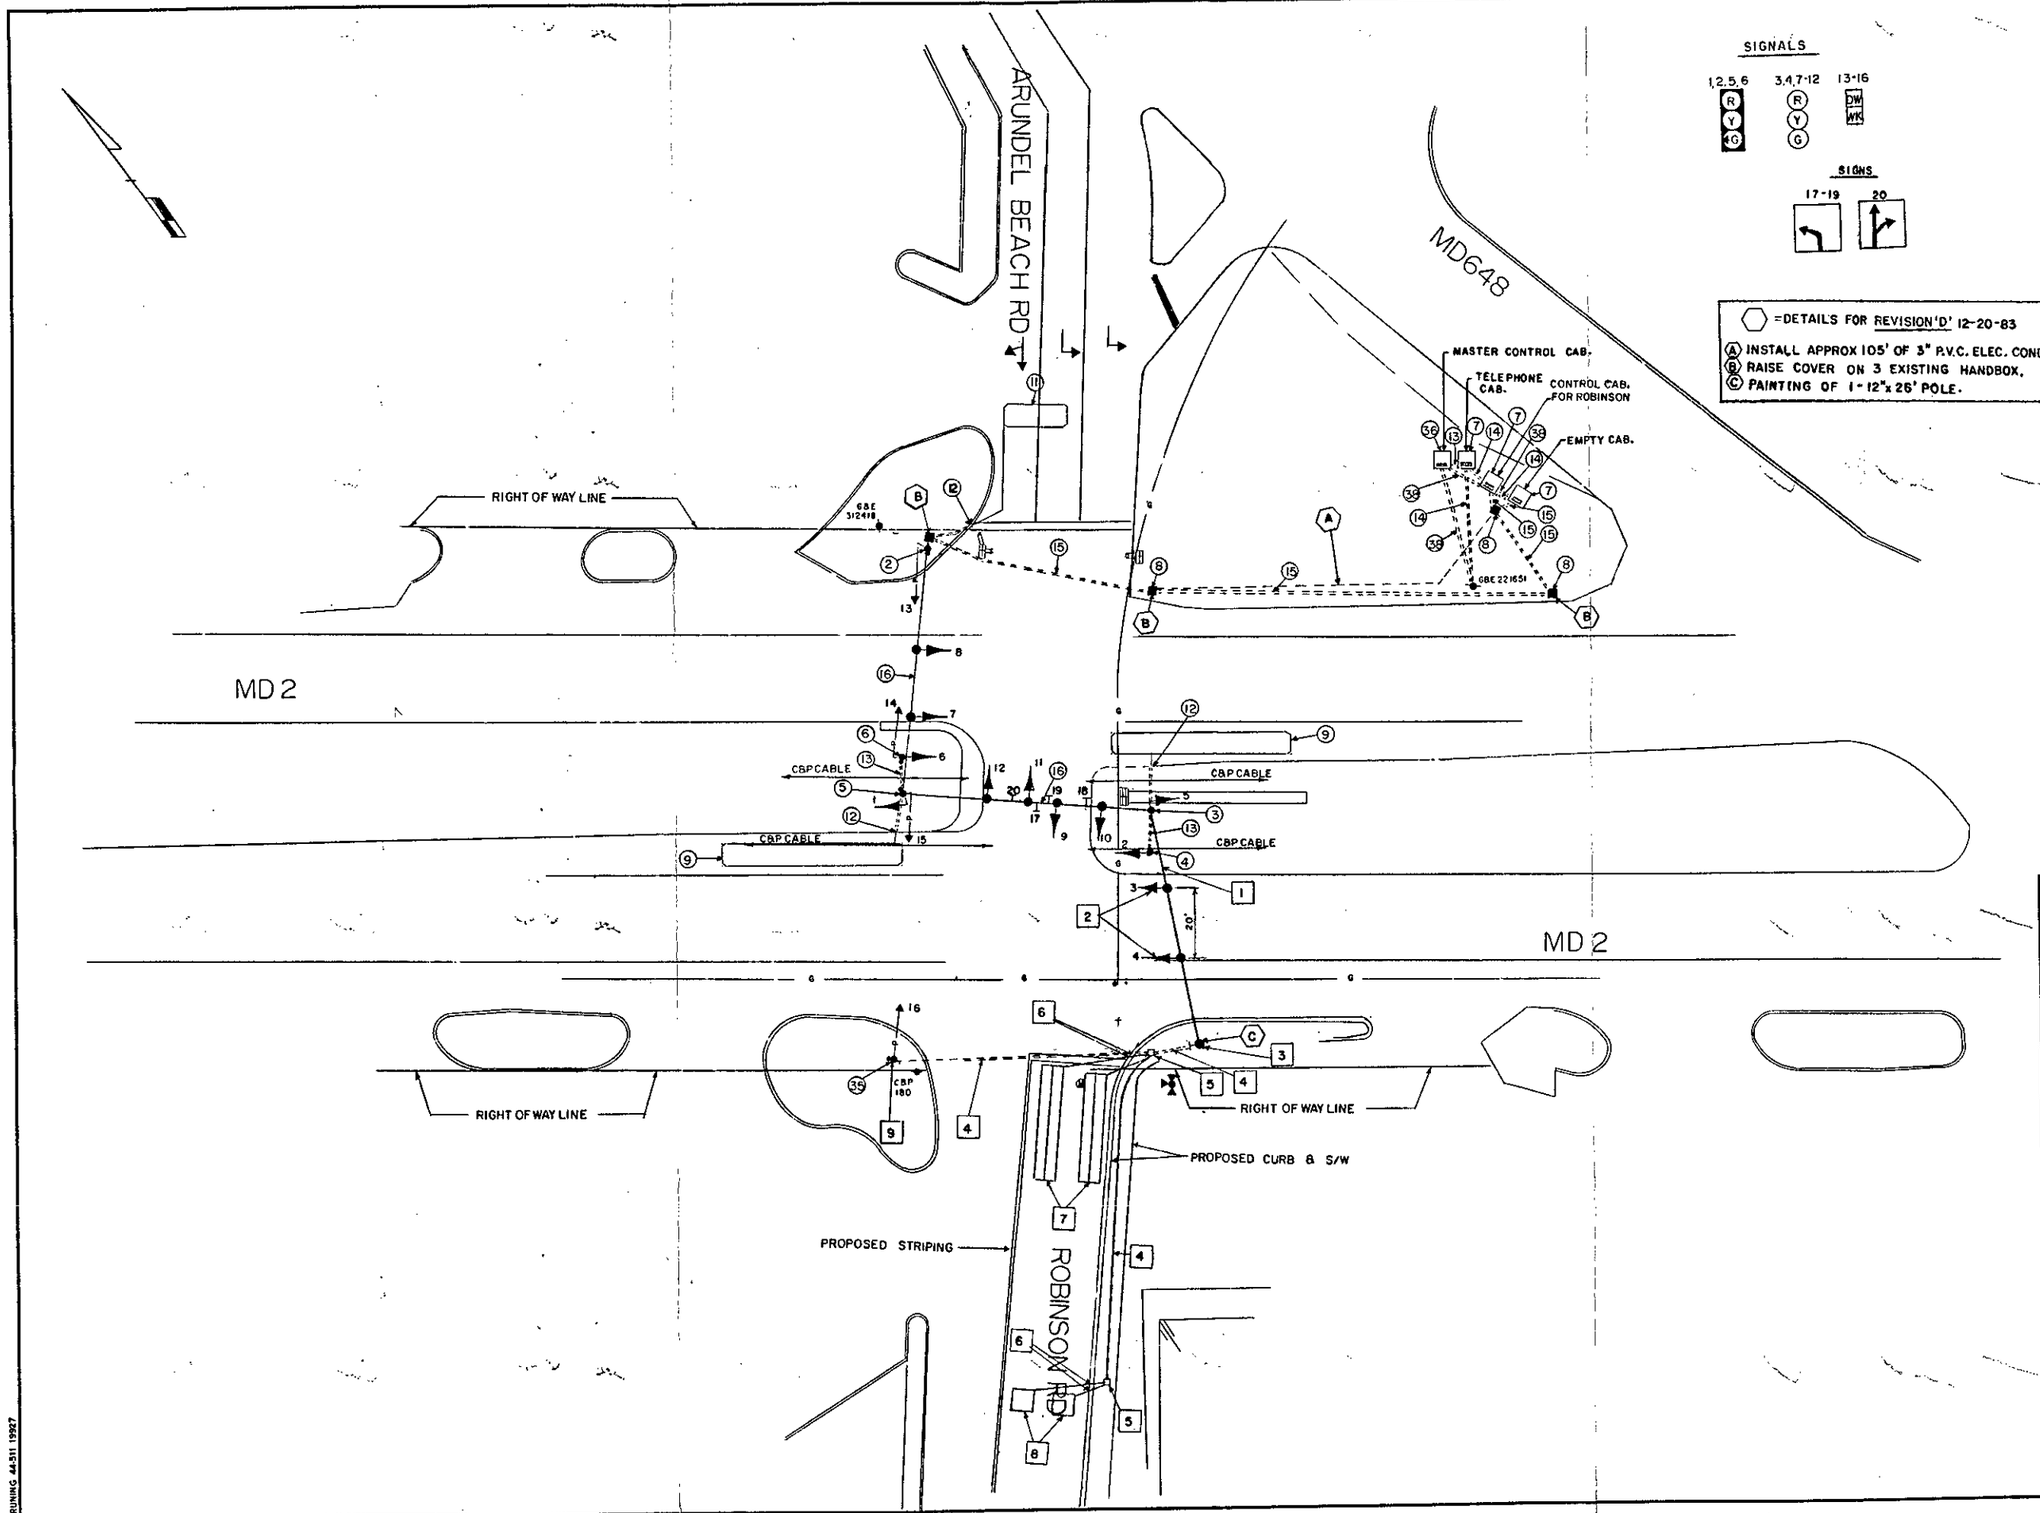

SIGNALS

1,2,5,6 — R Y 4G

3,4,7-12 — R Y G

13-16 — DW WK

SIGNS

17-19

20

⬡ = DETAILS FOR REVISION 'D' 12-20-83

(A) INSTALL APPROX 105' OF 3" P.V.C. ELEC. CONDUIT.
(B) RAISE COVER ON 3 EXISTING HANDBOX.
(C) PAINTING OF 1-12"x 26' POLE.

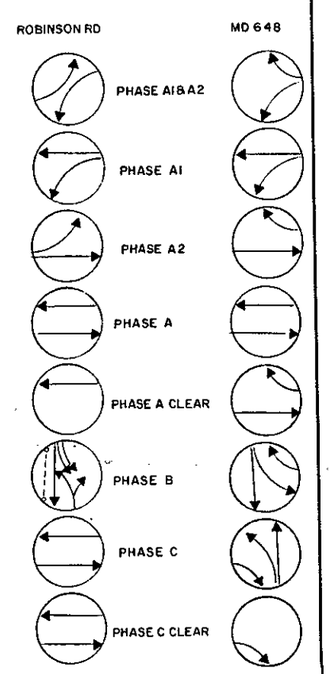

APPROVAL: REGIONAL TRAFFIC ENGINEER

APPROVAL: CHIEF-BUREAU OF TRAFFIC ENGINEERING

APPROVAL: ASS'T. CHIEF ENGINEER TRAFFIC

D	REVISION 12-83 SEE DETAILS-COUNTY CONTRACT BW-677-801-512
C	9-26-83 NEW LOOPS & POLE DUE TO A.A. Co. PROPOSED GEOMETRICS SAR
B	4/19/74 ASBUILT & REDRAWN
WR	

REVISIONS

STATE OF MARYLAND
DEPARTMENT OF TRANSPORTATION
STATE HIGHWAY ADMINISTRATION

TRAFFIC DIVISION – BUREAU OF TRAFFIC ENGINEERING

MD 2 & ROBINSON, ARUNDEL BEACH RD

FAP NO. T-8005(2)

SCALE 1" = 20' | DATE 4/9/73 | CONTRACT NO. AA810-2-576

DRAWN BY: F DEBELIUS | COUNTY: ANNE ARUNDEL

DESIGNED BY: | SIGNAL NO.:

CHECKED BY:

DRAWING NO. TS-168 D

02000229.6
167

BRUNING 44-511 19927