FINAL REGION NO	STATE	FED AID PROJ NO	SHEET NO	TOTAL SHEETS
3	MD.	US-9469(1)	8	16

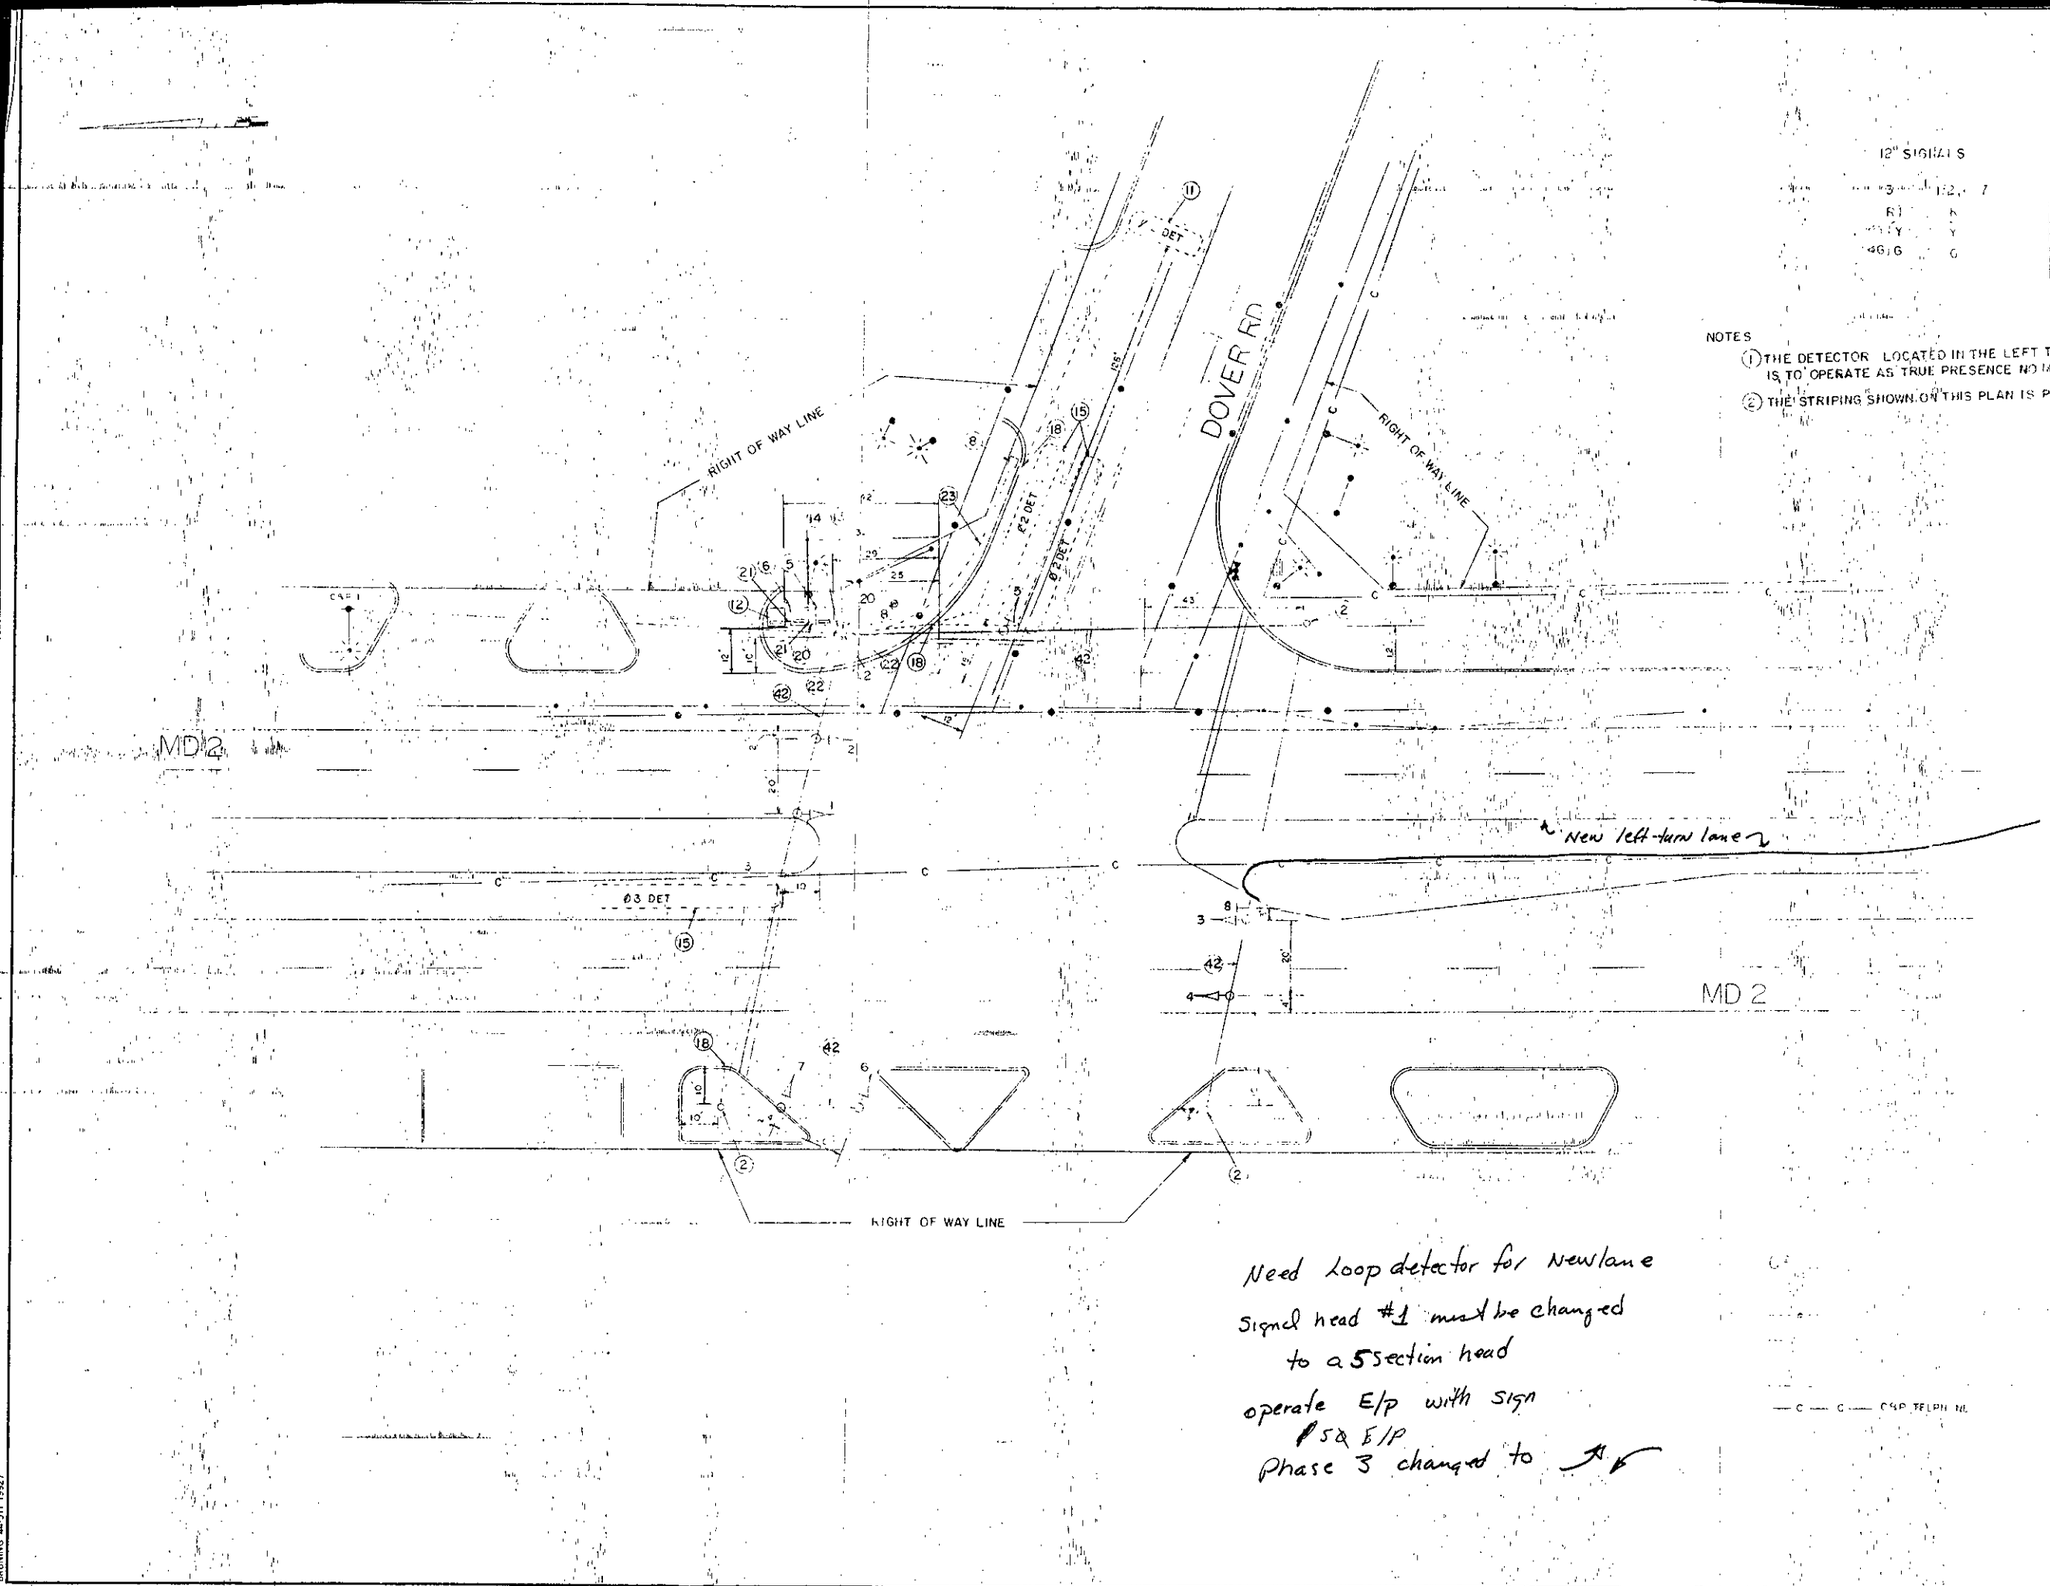

PHASE 1

PHASE 2

PHASE 3

FLASHING OPERATION

APPROVAL REGIONAL TRAFFIC ENGINEER

APPROVAL. CHIEF BUREAU OF TRAFFIC ENGINEERING

APPROVAL: ASS'T. CHIEF ENGINEER TRAFFIC

REVISIONS

STATE OF MARYLAND
DEPARTMENT OF TRANSPORTATION
STATE HIGHWAY ADMINISTRATION

TRAFFIC DIVISION – BUREAU OF TRAFFIC ENGINEERING

MD 2 & DOVER RD

SHEET 8 OF 16

SCALE 1" = 20' DATE 5/13/73 CONTRACT NO. AA-887-003-585 FAP NO US-9469(1)

DRAWN BY W.F. W.H. COUNTY: ANNE ARUNDEL

02000238.42

DESIGNED BY: SIGNAL NO.: 02181

CHECKED BY:

DRAWING NO. TS-241