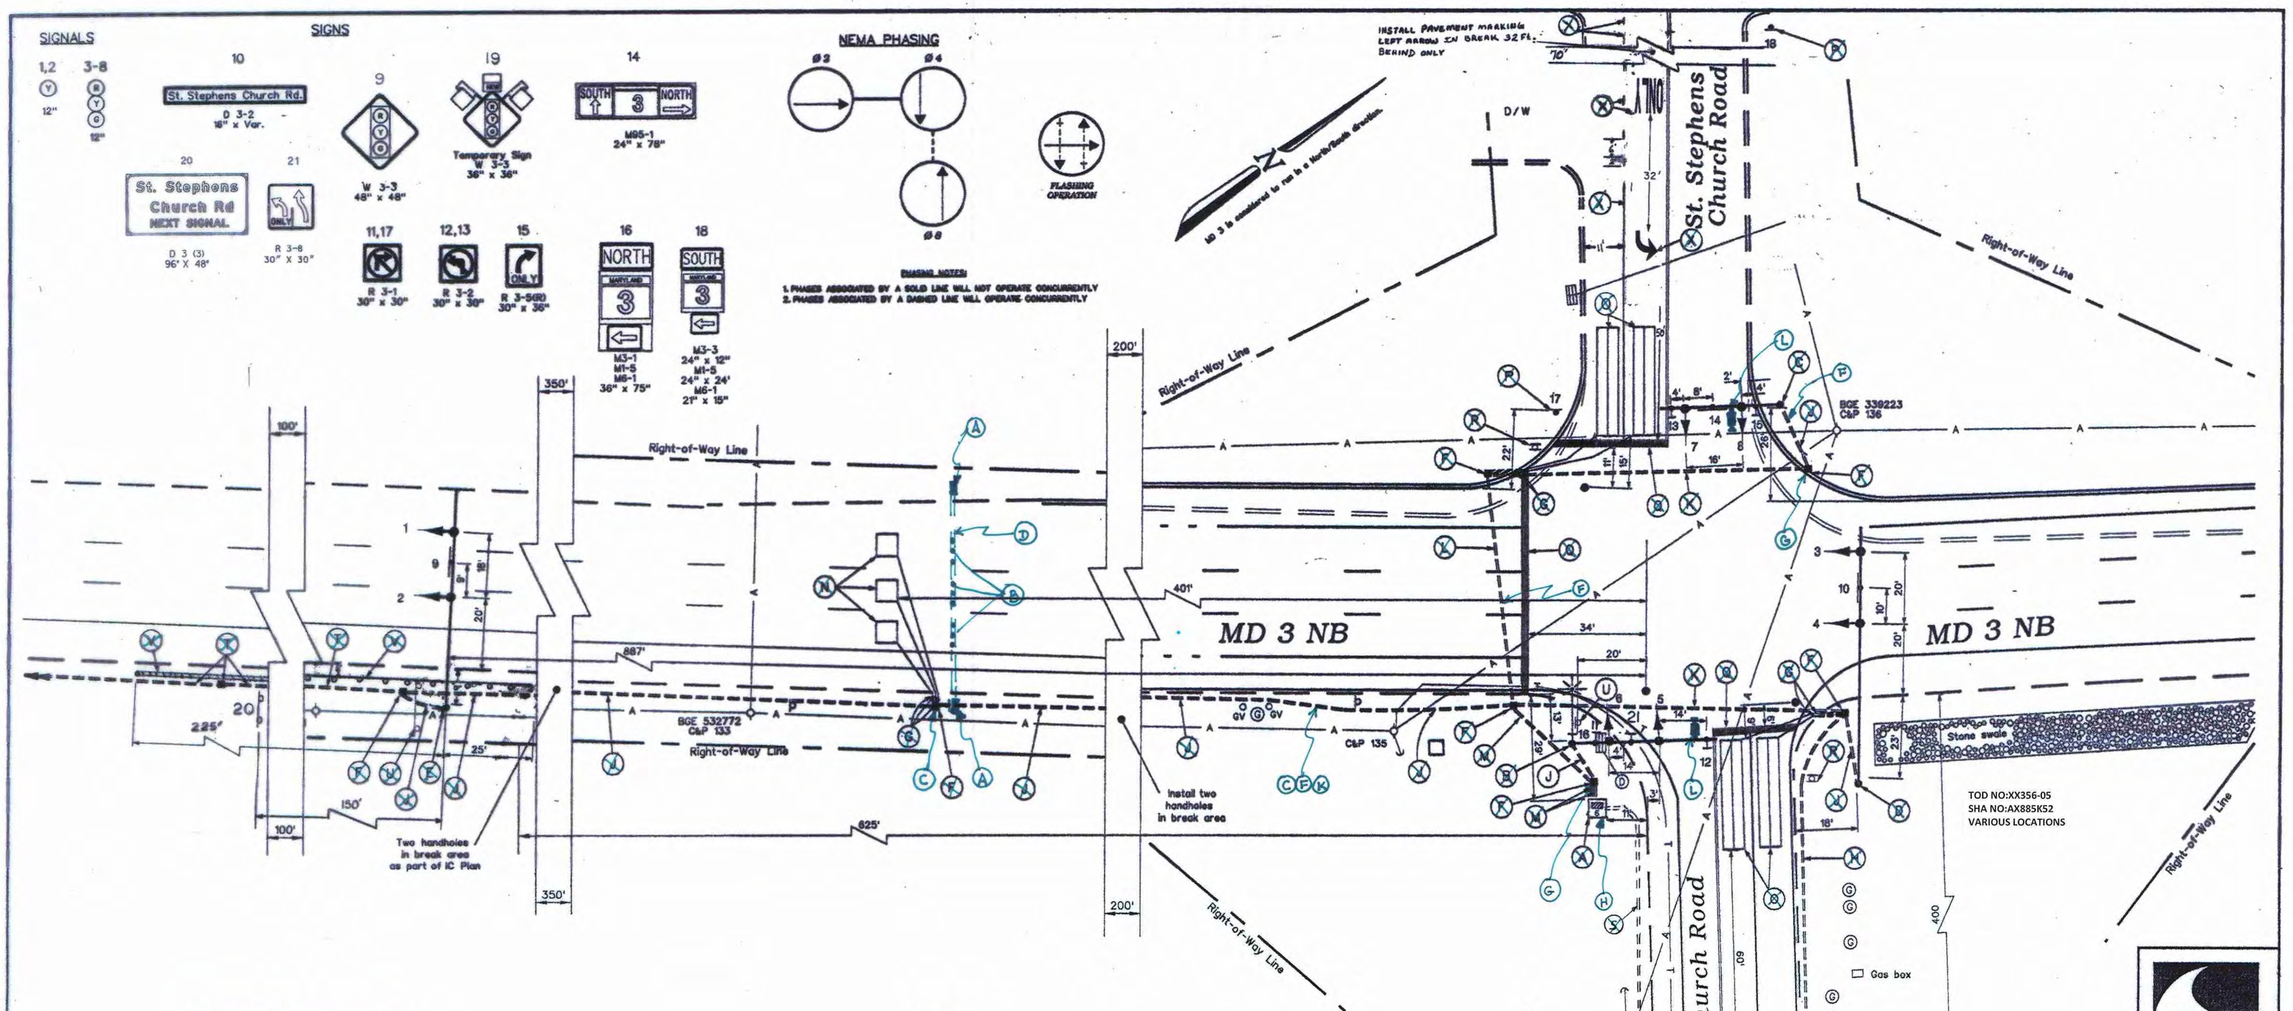

CONSTRUCTION DETAIL

A. INSTALL PRAPOSED HANDHOLE
B. INSTALL PROPOSED NON-INVASIVE PROBE SET
C. PULL BACK AND REROUTE THE CABLES
D. INSTALL 3"PVC. CONDUIT BORE
E. USE EXISTING SPAN WIRE.
F. USE EXISTING CONDUIT.
G. USE EXISTING HANDHOLE.
H. USE EXISTING BASE-MOUNTED CABINET.
J. REMOVE ABANDONED LOOPWIRE FROM EXISTING HANDHOLE.
K. REMOVE ABANDONED LOOPWIRE FROM EXISTING CONDUIT.

NOTES

1. Geometrics shall be confirmed prior to the installation of signal equipment. All signal equipment shall be installed at final grade.
2. Loop detectors and conduits shall be installed prior to the installation of pavement markings.
3. Pavement markings detailed are proposed and are to be installed by the Contractor in accordance with S.H.A. standards. All other pavement markings will be installed as part of the highway contract.
4. All underground and overhead utilities shown on these plans are schematic and are not to be considered complete. The Contractor shall be responsible for notifying all utility companies prior to construction so that all utilities may be located in the field. If the Contractor perceives that a conflict between the utilities and the traffic signal equipment will occur, the Contractor shall notify the appropriate Project Engineer immediately.

175' 25' Trail End Anchorage

GEOMETRIC LEGEND	REVISIONS	APPROVALS
EXISTING GEOMETRICS		ASST. TRAFFIC ENGINEERING DESIGN DIVISION 042
PROPOSED GEOMETRICS		ASST. DISTRICT ENGINEER - TRAFFIC 9-1-99
UTILITY LEGEND		CHIEF, TRAFFIC ENGINEERING DESIGN DIVISION 9/8/99
G — GAS MAIN	A TRAFFIC SIGNAL DETECTION UPGRADE J630 09-30-2009 XX3565168	DIRECTOR, OFFICE OF TRAFFIC & SAFETY
W — WATER MAIN		
S — SEWER MAIN		
E — ELECTRIC CABLES		
D — STORM DRAIN		
A — AERIAL CABLES		
T — TELEPHONE CABLES		

MDOT - STATE HIGHWAY ADMINISTRATION
Office of Traffic & Safety
TRAFFIC ENGINEERING DESIGN DIVISION
(Traffic Signal Plan)

MD 3 NB at St. Stephens Church Road

DATE: August 27, 1999 LOG MILE • 02000304.21

DRAWN BY:	FJH	F.A.P. NO.	N/A	PLAN SHEET NO.:	SHEET NO.
CHK. BY:		S.H.A. NO.	XX100.5585	3922A	1 of 3
SCALE:	1" = 20'	COUNTY:	Anne Arundel		

f:\970727\035\dss\sigplan.dgn 27 AUG 199