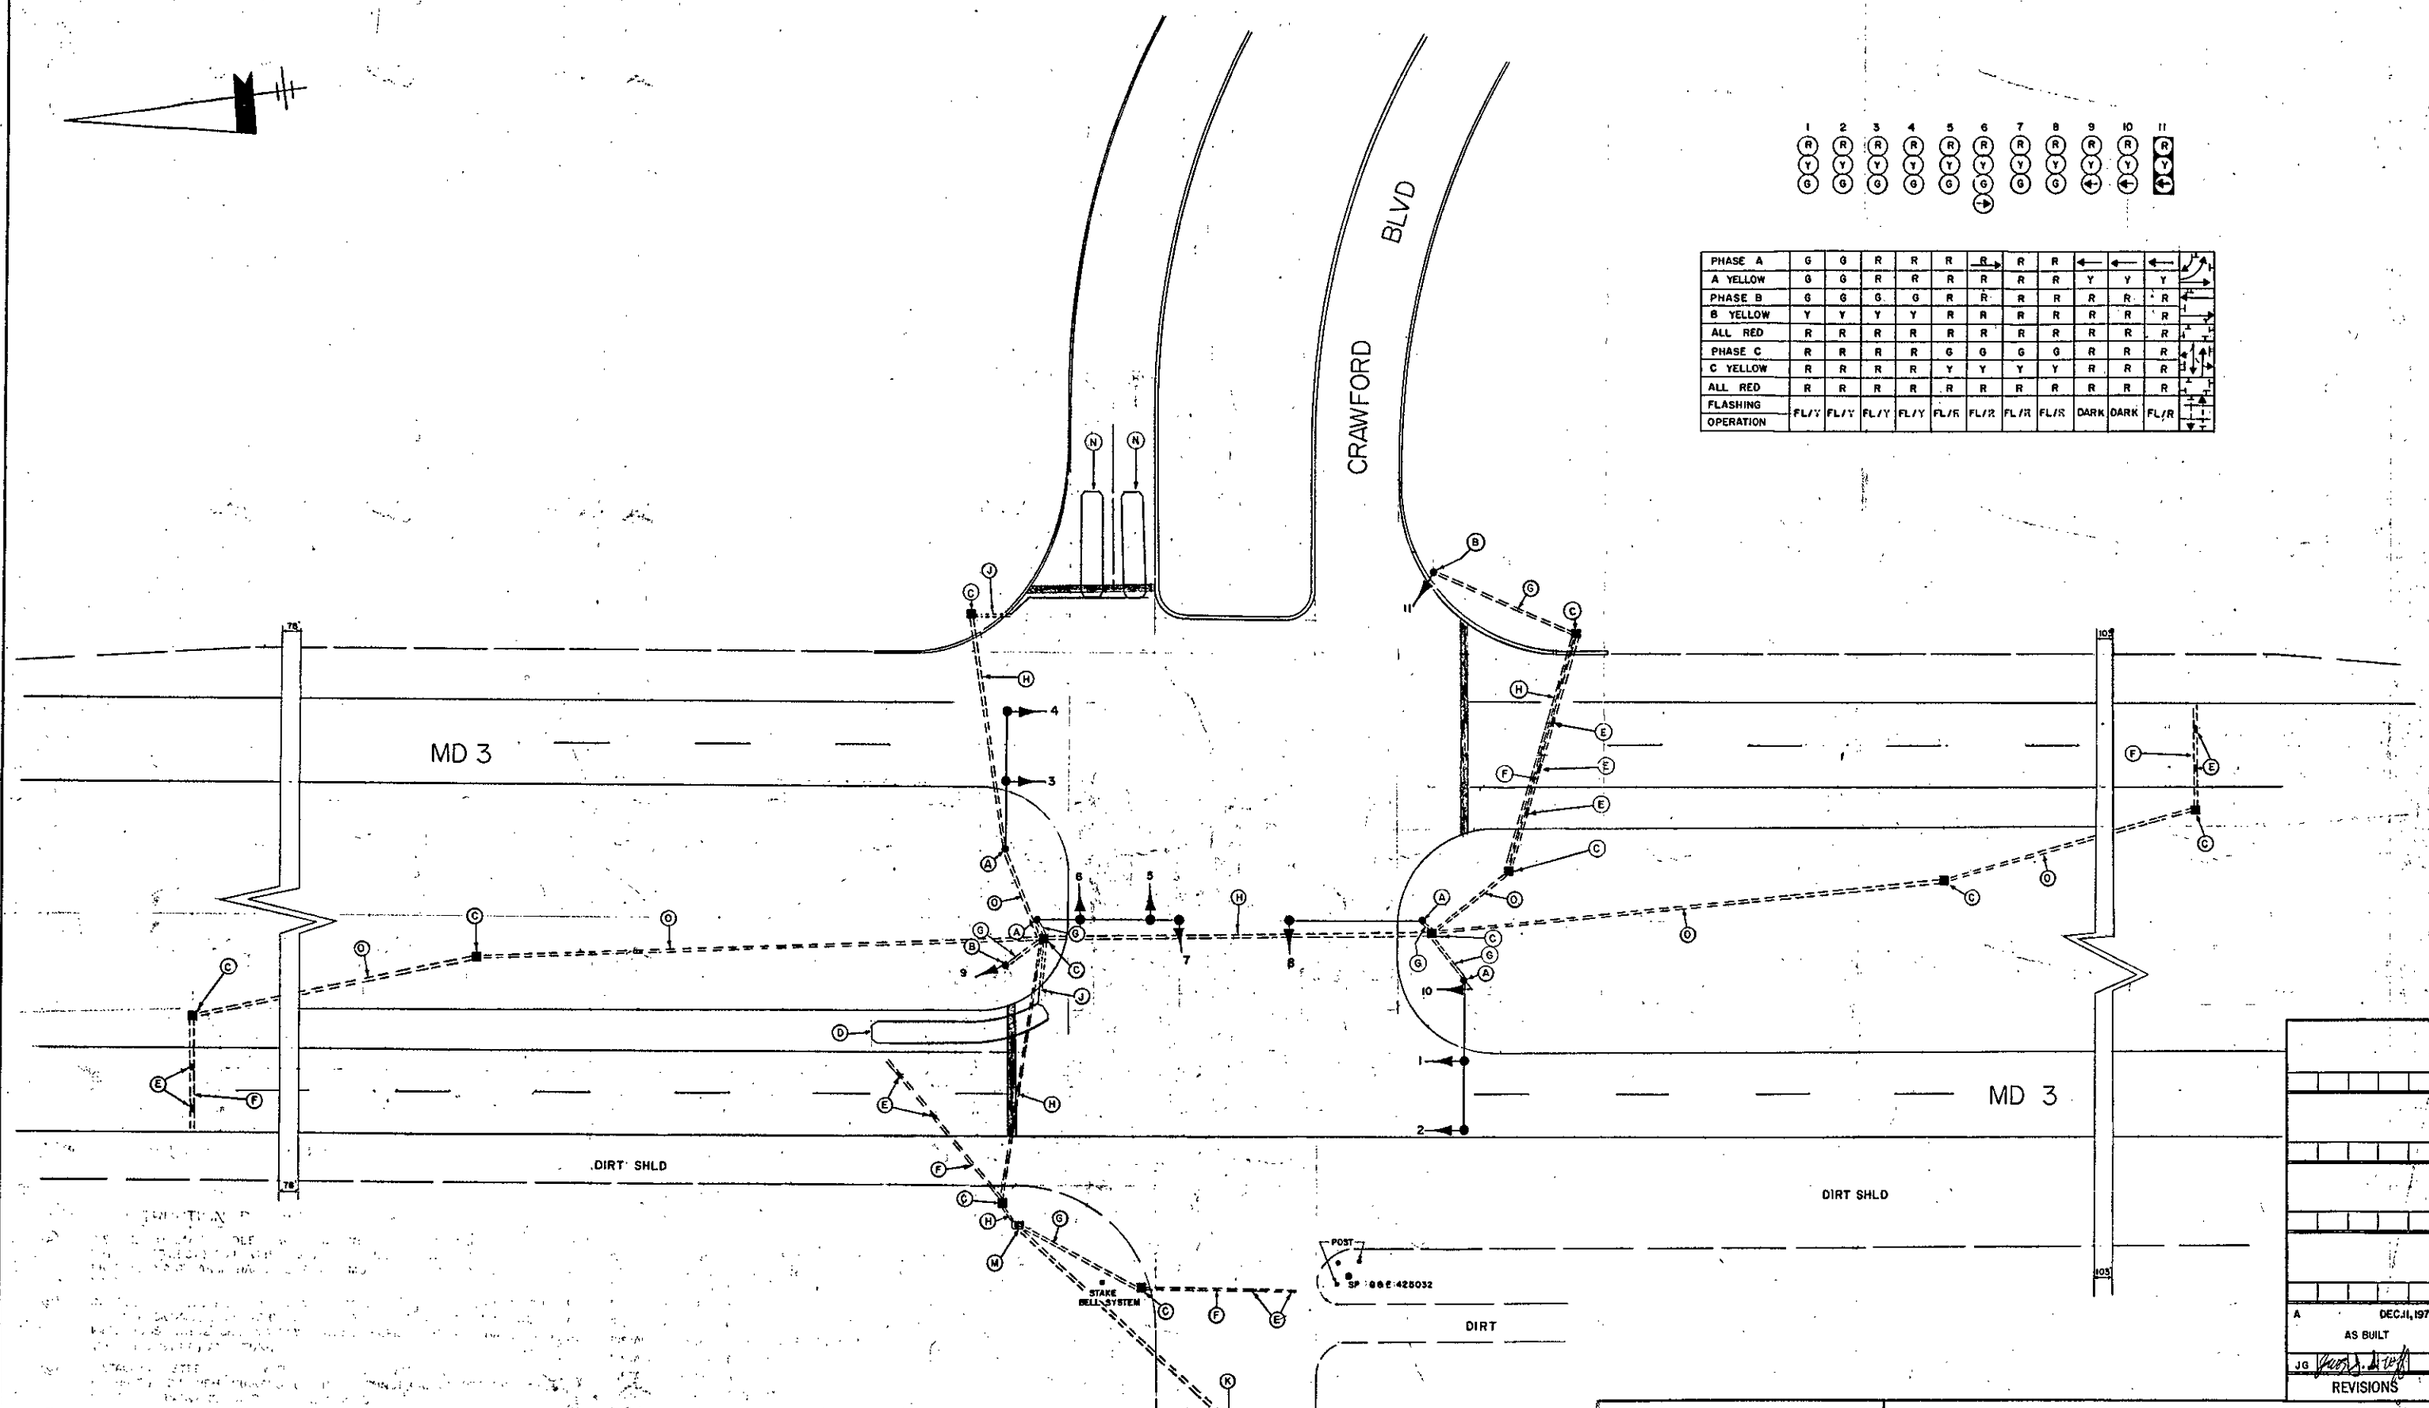

	1	2	3	4	5	6	7	8	9	10	11
PHASE A	G	G	R	R	R	R →	R	R	←	←	↙ ↑ ↓
A YELLOW	G	G	R	R	R	R	R	R	Y	Y	Y →
PHASE B	G	G	G	G	R	R	R	R	R	R	R ←
B YELLOW	Y	Y	Y	Y	R	R	R	R	R	R	R →
ALL RED	R	R	R	R	R	R	R	R	R	R	R
PHASE C	R	R	R	R	G	G	G	G	R	R	R ↙ ↑ ↓
C YELLOW	R	R	R	R	Y	Y	Y	Y	R	R	R ↙ ↑ ↓
ALL RED	R	R	R	R	R	R	R	R	R	R	R ↙ ↑ ↓
FLASHING OPERATION	FL/Y	FL/Y	FL/Y	FL/Y	FL/R	FL/R	FL/R	FL/R	DARK	DARK	FL/R ↙ ↑ ↓

REVISIONS		
A	DEC.11, 1972	AS BUILT
JG		

APPROVAL: CHIEF - BUREAU OF TRAFFIC ENGINEERING

APPROVAL: ASS'T CHIEF ENGINEER TRAFFIC SAFETY

MARYLAND STATE ROADS COMMISSION
DIVISION OF TRAFFIC SAFETY
BUREAU OF TRAFFIC ENGINEERING

MD 3 & CRAWFORD BLVD

SIGNAL NO. 02127

DATE 4/26/71
SCALE 1" = 20'
DRAWN BY: J SPENCE
CONTRACT NO. AA-801X-575
COUNTY ANNE ARUNDEL
CHECKED BY:

DRAWING NO. TS-23 A

02000301.54