FHWA REGION NO.	STATE	FED. AID PROJ. NO.	SHEET NO.	TOTAL SHEETS
3	MD			

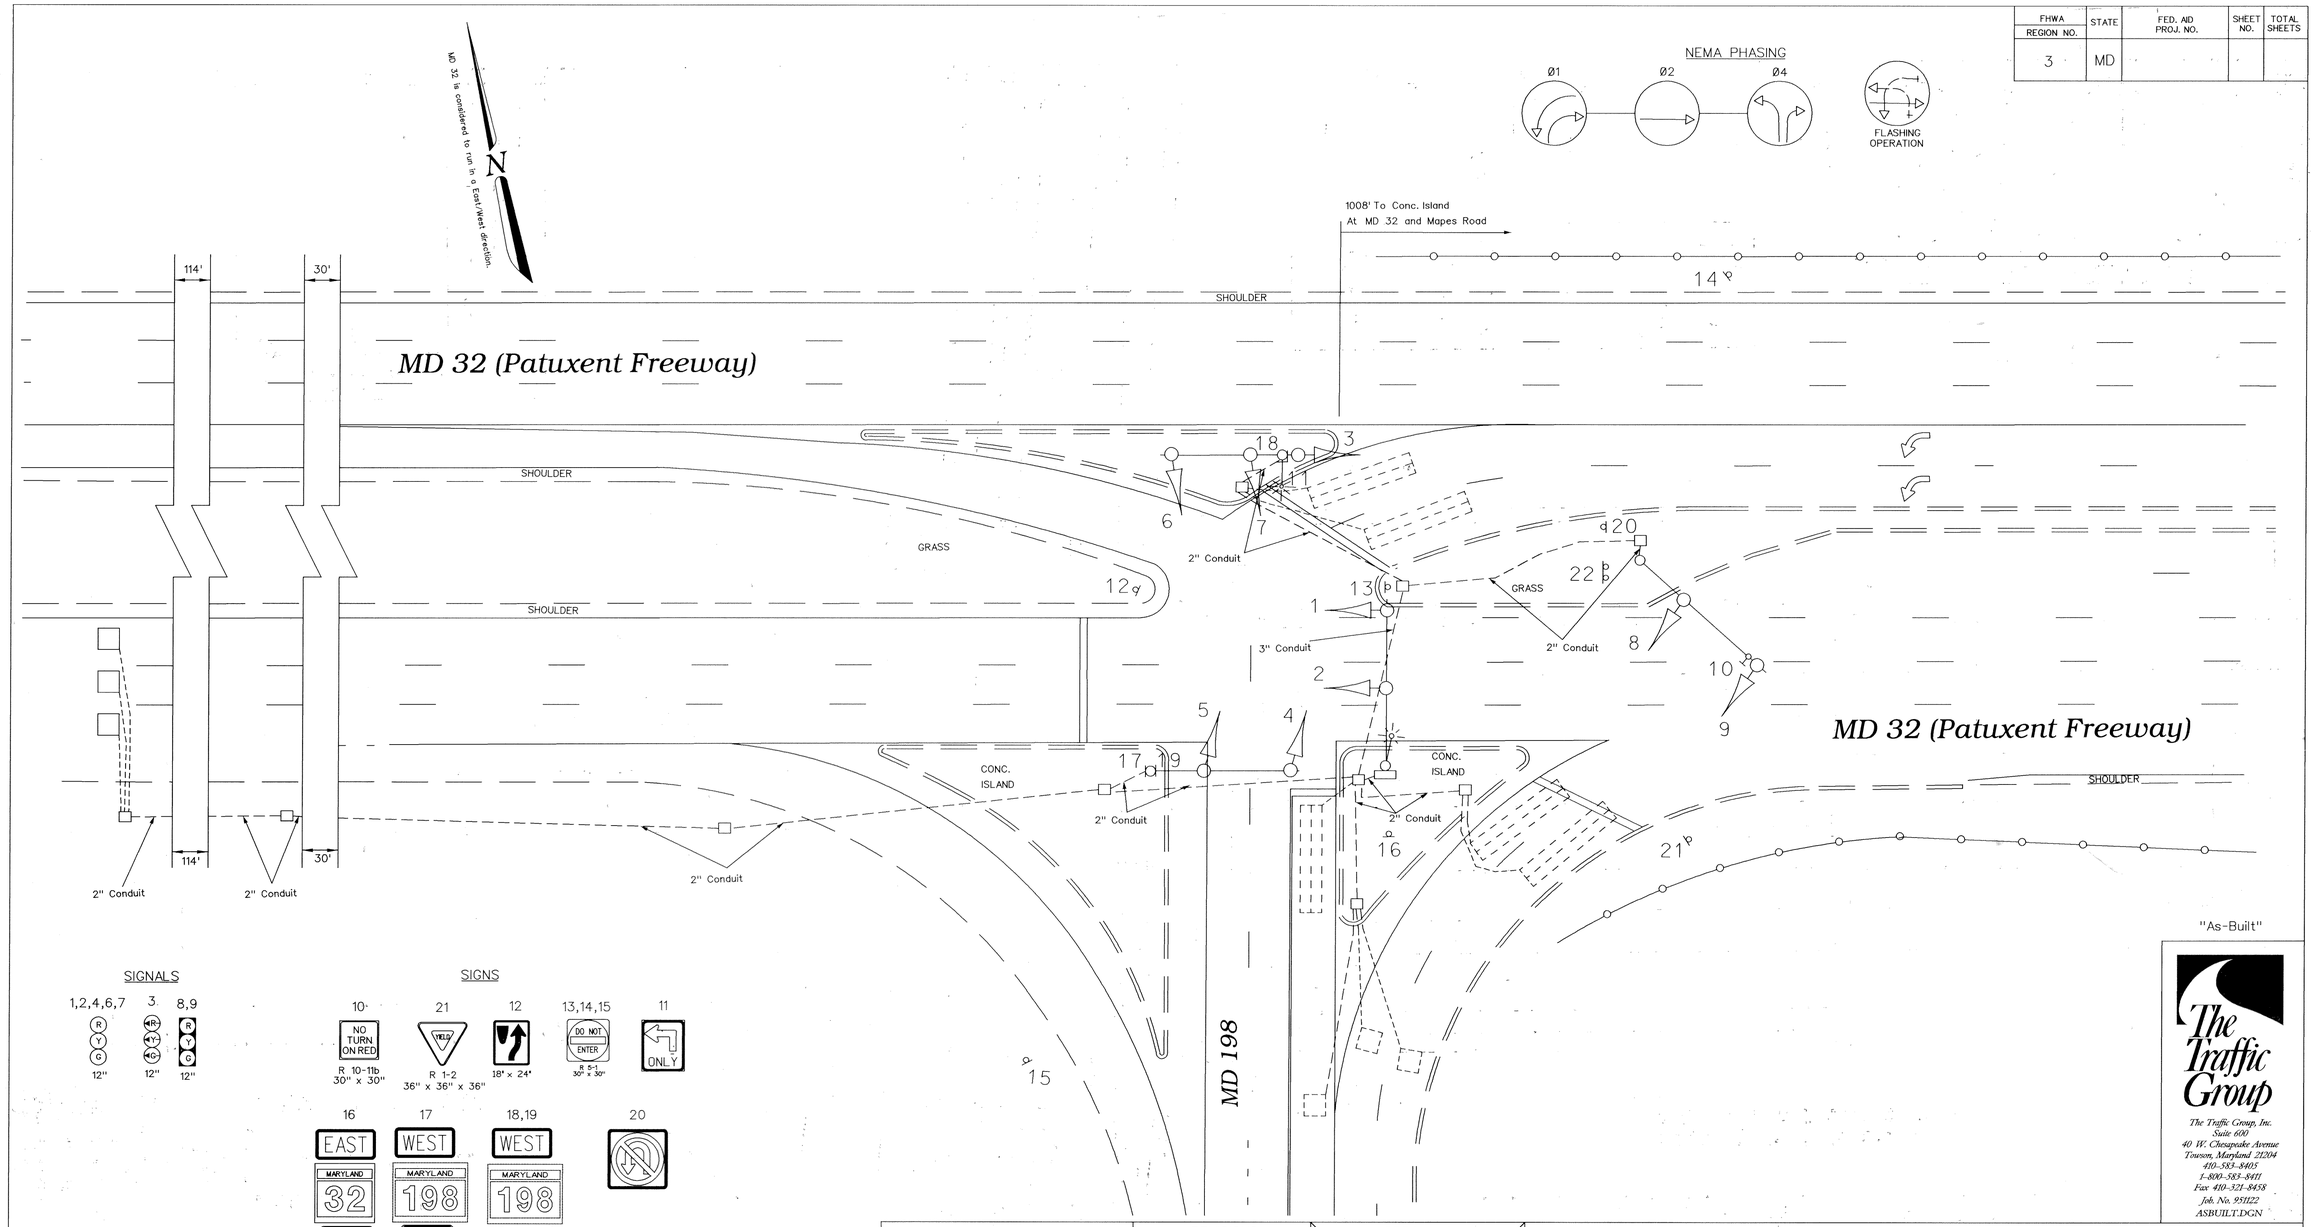

"As-Built"

The Traffic Group

The Traffic Group, Inc.
Suite 600
40 W. Chesapeake Avenue
Towson, Maryland 21204
410-583-8405
1-800-583-8411
Fax 410-321-8458
Job. No. 951122
ASBUILT.DGN

GEOMETRIC LEGEND

EXISTING GEOMETRICS
PROPOSED GEOMETRICS

UTILITY LEGEND

G — G	GAS MAIN
W — W	WATER MAIN
S — S	SEWER MAIN
E — E	ELECTRIC CABLES
D — D	STORM DRAIN
A — A	AERIAL CABLES
T — T	TELEPHONE CABLES

REVISIONS

(B) June 18, 1996
AS-BUILT
S.H.A. No.: AA-571-501-576
FTH

APPROVALS

ASST. DIVISION CHIEF TRAFFIC ENGINEERING DESIGN DIVISION

CHIEF, TRAFFIC ENGINEERING DESIGN DIVISION

ASST. DISTRICT ENGINEER - TRAFFIC

DIRECTOR, OFFICE OF TRAFFIC & SAFETY

ORIGINAL ONLY

MDOT – STATE HIGHWAY ADMINISTRATION
Office of Traffic & Safety
TRAFFIC ENGINEERING DESIGN DIVISION

DRAWN BY: GENE SIMMERS
DES. BY: GENE SIMMERS
CHK. BY: STEVE RENZI

(Traffic Signal Plan)

MD 32 at MD 198

COUNTY: ANNE ARUNDEL
LOG MILE • 02000320847

DATE: 9-20-86
SCALE: 1" = 20'
F.A.P. NO. N/A
S.H.A. NO. AA-739-504-570
TS/STD. NO. 2225B-P
SHEET NO. 1 of 1