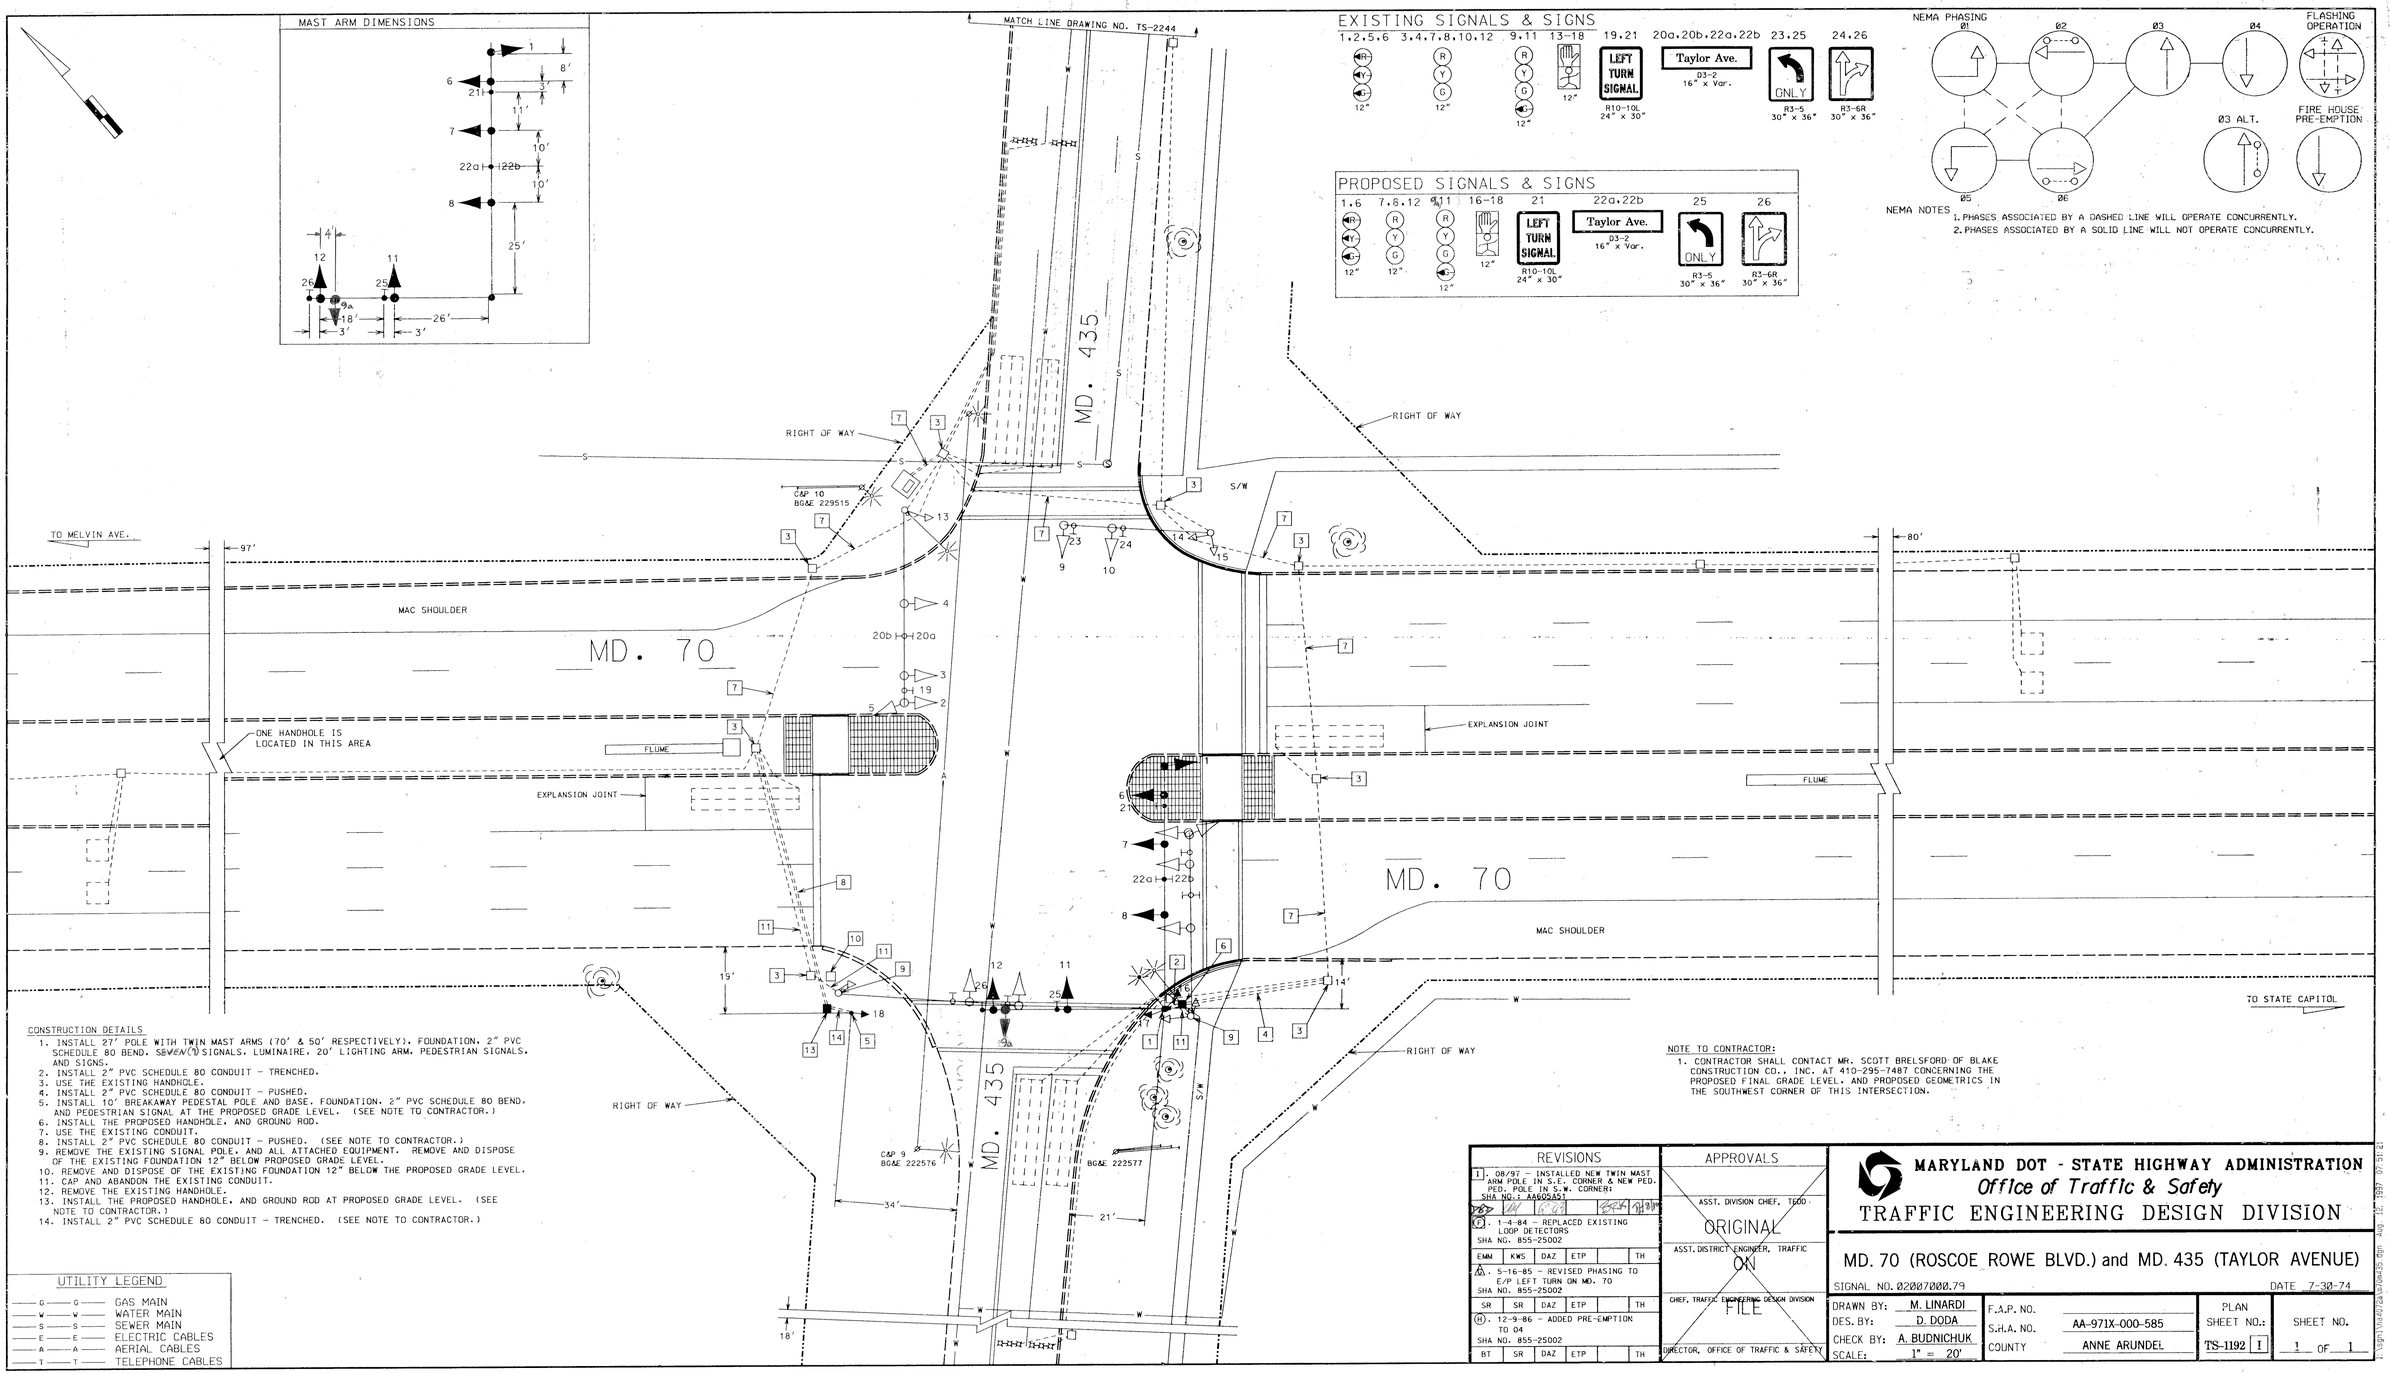

CONSTRUCTION DETAILS

1. INSTALL 27' POLE WITH TWIN MAST ARMS (70' & 50' RESPECTIVELY). FOUNDATION. 2" PVC SCHEDULE 80 BEND. SEWER/(N) SIGNALS. LUMINAIRE. 20' LIGHTING ARM. PEDESTRIAN SIGNALS. AND SIGNS.
2. INSTALL 2" PVC SCHEDULE 80 CONDUIT - TRENCHED.
3. USE THE EXISTING HANDHOLE.
4. INSTALL 2" PVC SCHEDULE 80 CONDUIT - PUSHED.
5. INSTALL 10' BREAKAWAY PEDESTAL POLE AND BASE. FOUNDATION. 2" PVC SCHEDULE 80 BEND. AND PEDESTRIAN SIGNAL AT THE PROPOSED GRADE LEVEL. (SEE NOTE TO CONTRACTOR.)
6. INSTALL THE PROPOSED HANDHOLE. AND GROUND ROD.
7. USE THE EXISTING CONDUIT.
8. INSTALL 2" PVC SCHEDULE 80 CONDUIT - PUSHED. (SEE NOTE TO CONTRACTOR.)
9. REMOVE THE EXISTING SIGNAL POLE. AND ALL ATTACHED EQUIPMENT. REMOVE AND DISPOSE OF THE EXISTING FOUNDATION 12" BELOW PROPOSED GRADE LEVEL.
10. REMOVE AND DISPOSE OF THE EXISTING FOUNDATION 12" BELOW THE PROPOSED GRADE LEVEL.
11. CAP AND ABANDON THE EXISTING CONDUIT.
12. REMOVE THE EXISTING HANDHOLE.
13. INSTALL THE PROPOSED HANDHOLE. AND GROUND ROD AT PROPOSED GRADE LEVEL. (SEE NOTE TO CONTRACTOR.)
14. INSTALL 2" PVC SCHEDULE 80 CONDUIT - TRENCHED. (SEE NOTE TO CONTRACTOR.)

UTILITY LEGEND

—G—G—	GAS MAIN
—W—W—	WATER MAIN
—S—S—	SEWER MAIN
—E—E—	ELECTRIC CABLES
—A—A—	AERIAL CABLES
—T—T—	TELEPHONE CABLES

NOTE TO CONTRACTOR:

1. CONTRACTOR SHALL CONTACT MR. SCOTT BRELSFORD OF BLAKE CONSTRUCTION CO.. INC. AT 410-295-7487 CONCERNING THE PROPOSED FINAL GRADE LEVEL. AND PROPOSED GEOMETRICS IN THE SOUTHWEST CORNER OF THIS INTERSECTION.

REVISIONS

I. 08/97 - INSTALLED NEW TWIN MAST ARM POLE IN S.E. CORNER & NEW PED. PED. POLE IN S.W. CORNER SHA NO.: AA60A51					
BT					
K. 1-4-84 - REPLACED EXISTING LOOP DETECTORS SHA NO. 855-25002					
EMM	KWS	DAZ	ETP		TH
J. 5-16-85 - REVISED PHASING TO E/P LEFT TURN ON MD. 70 SHA NO. 855-25002					
SR	SR	DAZ	ETP		TH
H. 12-9-86 - ADDED PRE-EMPTION TO 04 SHA NO. 855-25002					
BT	SR	DAZ	ETP		TH

APPROVALS

ASST. DIVISION CHIEF, TSOD

ORIGINAL ON FILE

ASST. DISTRICT ENGINEER, TRAFFIC

CHIEF, TRAFFIC ENGINEERING DESIGN DIVISION

DIRECTOR, OFFICE OF TRAFFIC & SAFETY

MARYLAND DOT - STATE HIGHWAY ADMINISTRATION

Office of Traffic & Safety

TRAFFIC ENGINEERING DESIGN DIVISION

MD. 70 (ROSCOE ROWE BLVD.) and MD. 435 (TAYLOR AVENUE)

SIGNAL NO. 02007000.79 DATE 7-30-74

DRAWN BY:	M. LINARDI	F.A.P. NO.		PLAN SHEET NO.:	SHEET NO.
DES. BY:	D. DODA	S.H.A. NO.	AA-971X-000-585	TS-1192 I	1 OF 1
CHECK BY:	A. BUDNICHUK	COUNTY	ANNE ARUNDEL		
SCALE:	1" = 20'				

02007000.79