FHWA REGION NO.	STATE	FED. AID PROJ. NO.	SHEET NO.	TOTAL SHEETS
3	MD			

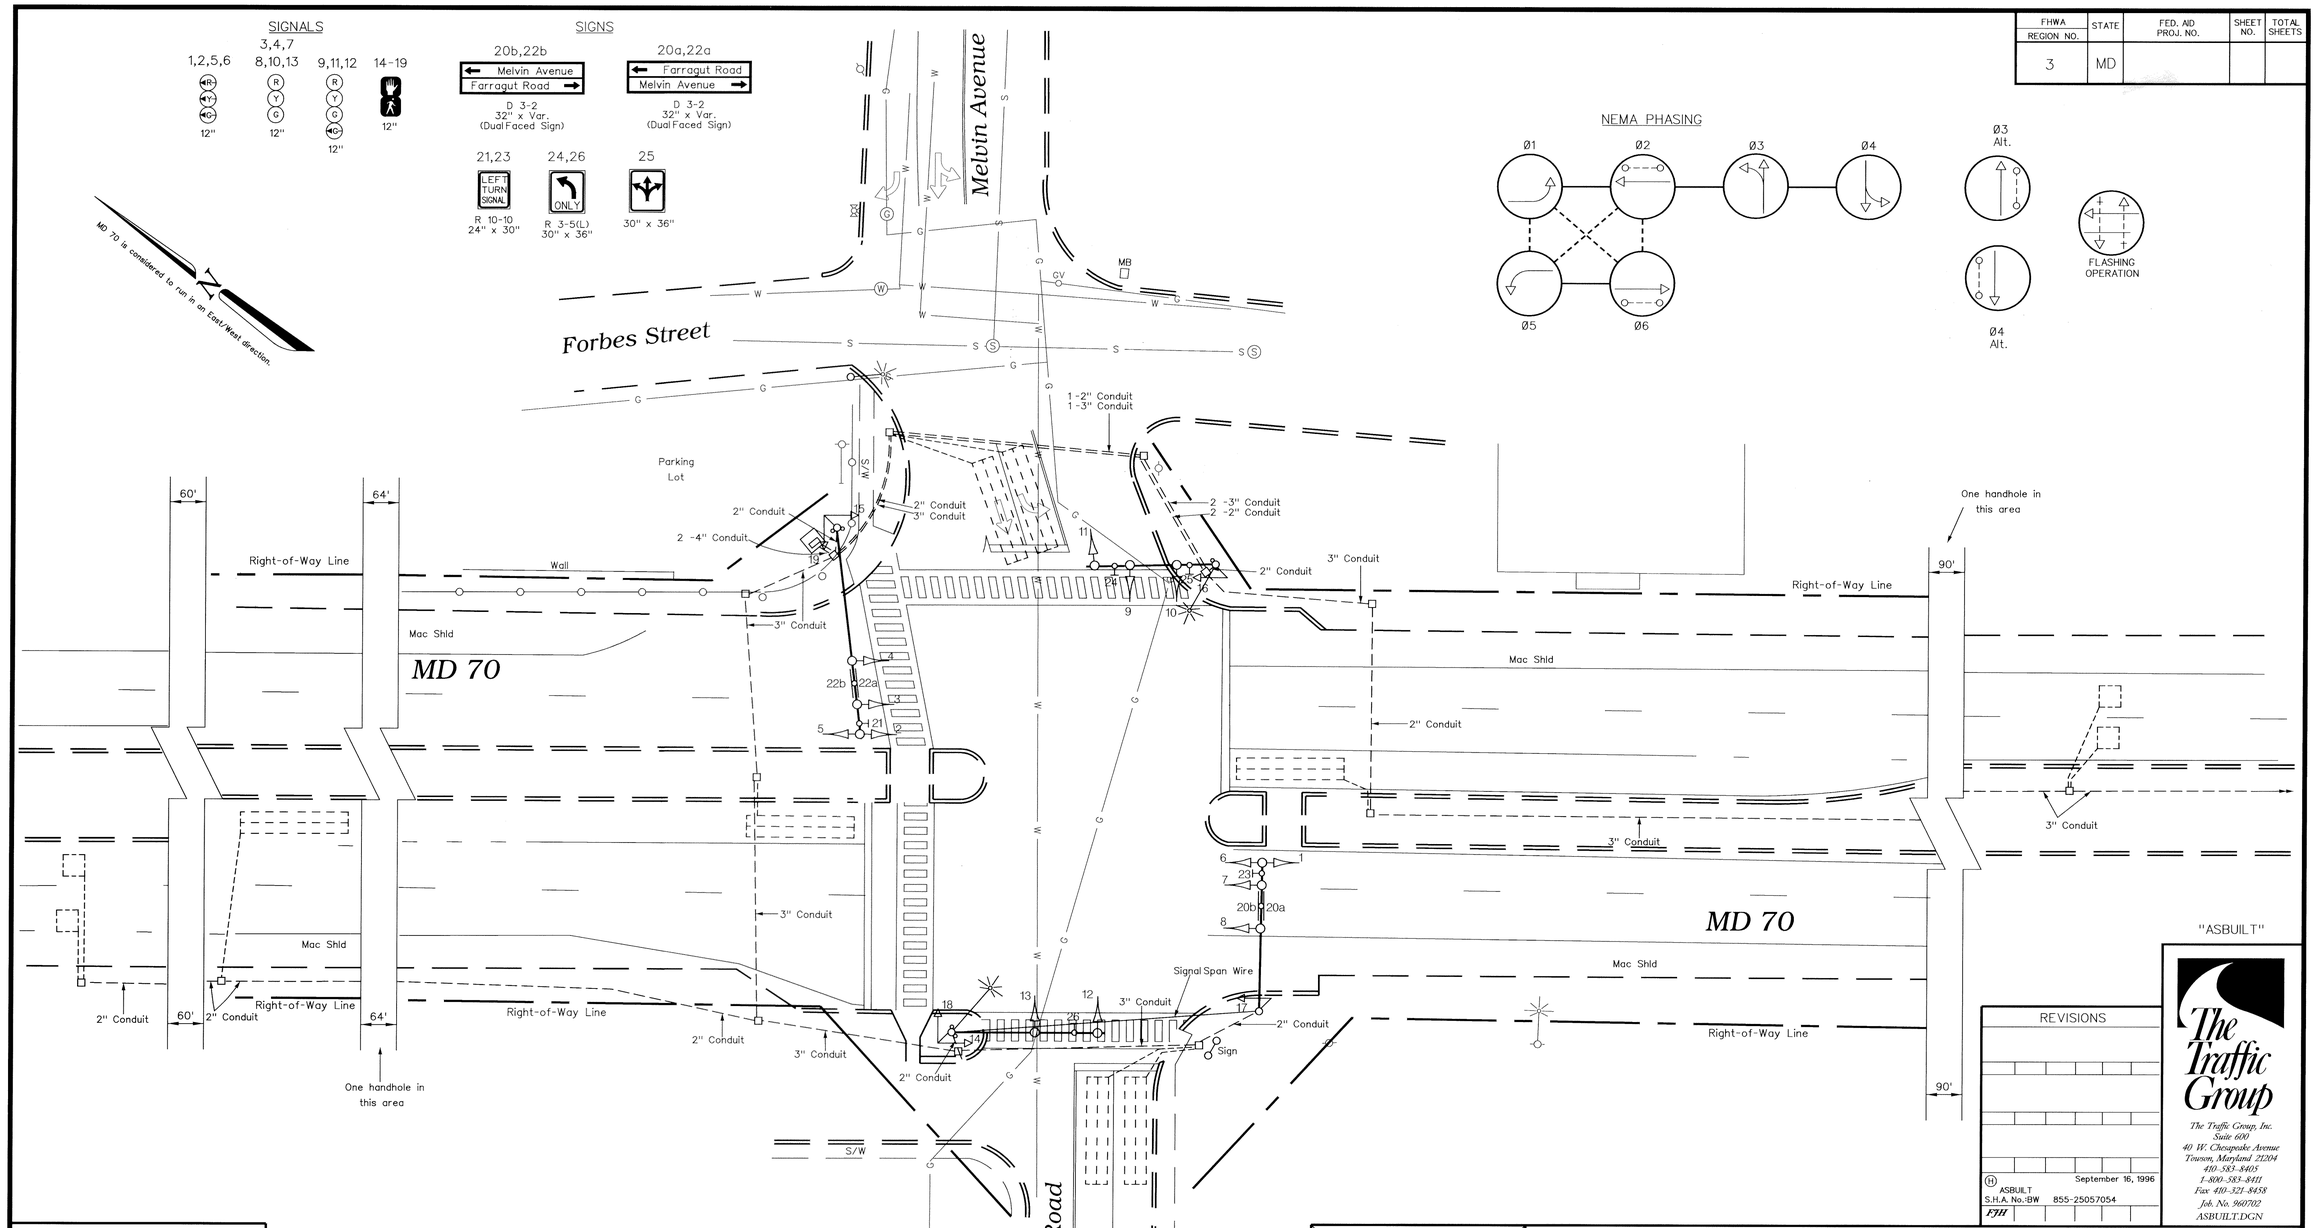

GEOMETRIC LEGEND

EXISTING GEOMETRICS

PROPOSED GEOMETRICS

UTILITY LEGEND

G	GAS MAIN
W	WATER MAIN
S	SEWER MAIN
E	ELECTRIC CABLES
D	STORM DRAIN
A	AERIAL CABLES
T	TELEPHONE CABLES

REVISIONS

ASBUILT September 16, 1996
S.H.A. No.:BW 855-25057054
FJH

The Traffic Group

The Traffic Group, Inc.
Suite 600
40 W. Chesapeake Avenue
Towson, Maryland 21204
410-583-8405
1-800-583-8411
Fax 410-321-8458
Job. No. 960702
ASBUILT.DGN

APPROVALS

ASST. DIVISION CHIEF TRAFFIC ENGINEERING DESIGN DIVISION

CHIEF, TRAFFIC ENGINEERING DESIGN DIVISION

ASST. DISTRICT ENGINEER - TRAFFIC

DIRECTOR, OFFICE OF TRAFFIC & SAFETY

ORIGINAL ON FILE

MDOT – STATE HIGHWAY ADMINISTRATION
Office of Traffic & Safety
TRAFFIC ENGINEERING DESIGN DIVISION

DRAWN BY: D. Zafiris
DES. BY: D. Doda 8-4-75
CHK. BY: A. Budnichuck 8-15-75

(Traffic Signal Plan)
MD 70 at Melvin Avenue\ Farragut Road

COUNTY: ANNE ARUNDEL LOG MILE • 0200700098

DATE: Feb. 12, 1975
SCALE: 1" = 20'
F.A.P. NO. N/A
S.H.A. NO. AA-071X-000-585
TS/STD. NO. 1198H
SHEET NO. 1 of 1