FHWA REGION NO.	STATE	FED. AID PROJ. NO.	SHEET NO.	TOTAL SHEETS
3	MD			

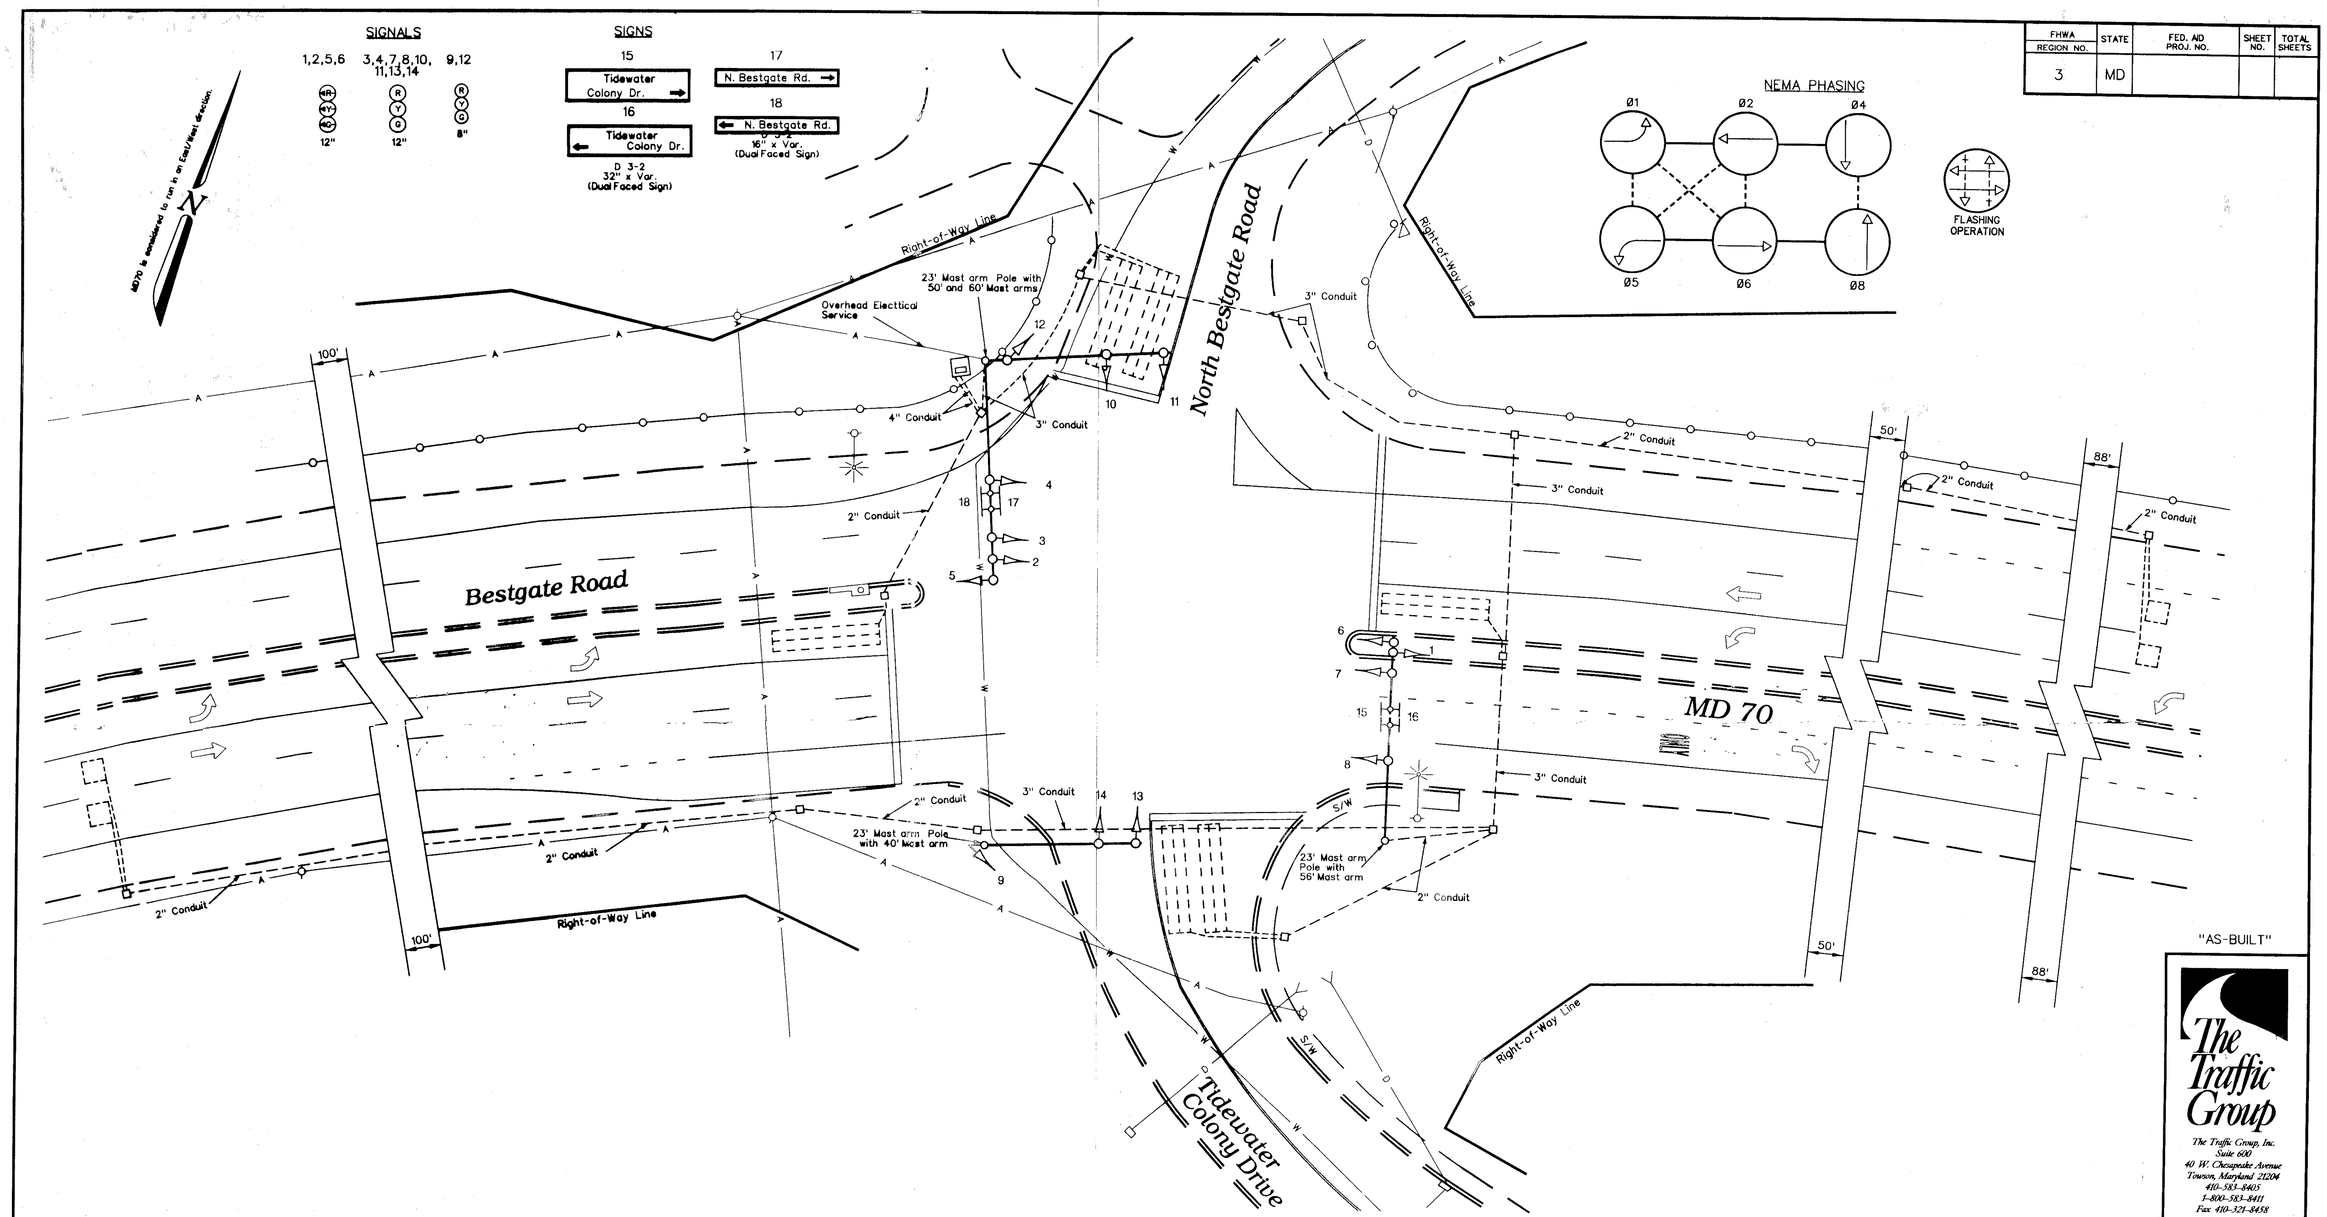

"AS-BUILT"

The Traffic Group

The Traffic Group, Inc.
Suite 600
40 W. Chesapeake Avenue
Towson, Maryland 21204
410-583-8403
1-800-583-8411
Fax 410-321-8458
Job No. 960706
ASBUILT.DGN

GEOMETRIC LEGEND

EXISTING GEOMETRICS
PROPOSED GEOMETRICS

UTILITY LEGEND

G — G	GAS MAIN
W — W	WATER MAIN
S — S	SEWER MAIN
E — E	ELECTRIC CABLES
D — D	STORM DRAIN
A — A	AERIAL CABLES
T — T	TELEPHONE CABLES

REVISIONS

September 11, 1996

© ASBUILT
S.H.A. No.: 855-25057063

APPROVALS

ASST. DIVISION CHIEF TRAFFIC ENGINEERING DESIGN DIVISION

CHIEF, TRAFFIC ENGINEERING DESIGN DIVISION

ASST. DISTRICT ENGINEER - TRAFFIC

DIRECTOR, OFFICE OF TRAFFIC & SAFETY

ORIGINAL ON FILE

MDOT – STATE HIGHWAY ADMINISTRATION
Office of Traffic & Safety
TRAFFIC ENGINEERING DESIGN DIVISION

DRAWN BY: WKS
DES. BY: WKS
CHK. BY:

(Traffic Signal Plan)
MD 70 at Tidewater Colony/ North Bestgate

COUNTY: ANNE ARUNDEL
LOG MILE • 02007002.06

DATE: October, 1993
SCALE: 1" = 20'
F.A.P. NO. N/A
S.H.A. NO.

TS/STD. NO. 3396C

SHEET NO. 1 of 1