FHWA REGION NO.	STATE	FED. AID PROJ. NO.	SHEET NO.	TOTAL SHEETS
3	MD			

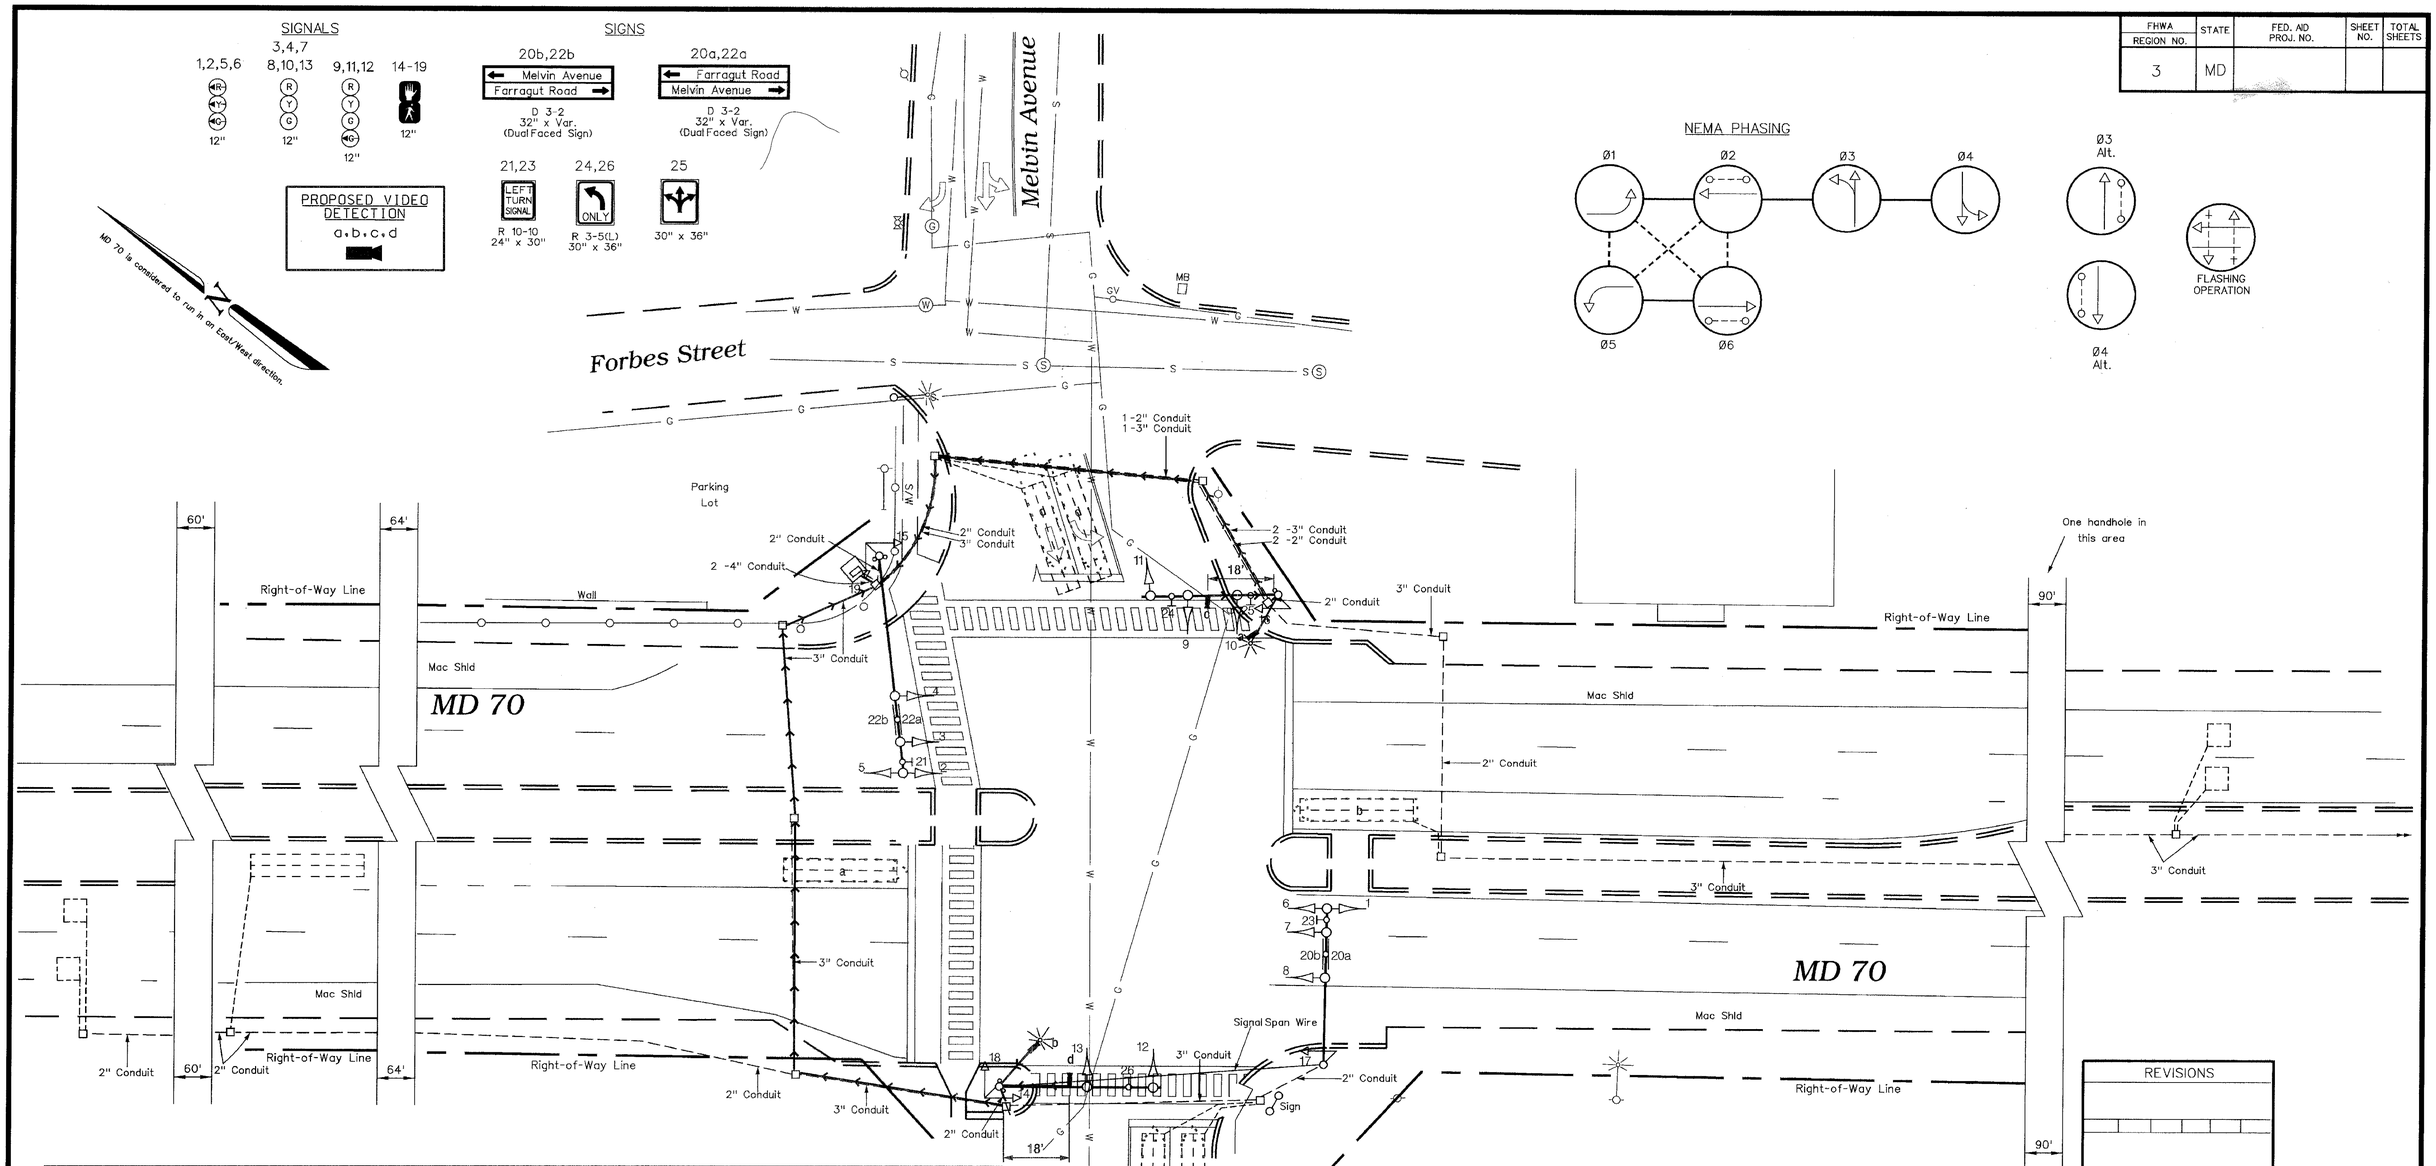

B. EQUIPMENT TO BE FURNISHED AND/OR INSTALLED BY THE CONTRACTOR.

CATEGORY CODE NO.	DESCRIPTION	UNITS	QUANTITY
8019	VIDEO DETECTION CAMERA	EA	4
8020	CONTROL CABLE, 250 FOOT VIDEO DETECTION CAMERA TO CONTROLLER	EA	2
8021	CONTROL CABLE, 500 FOOT VIDEO DETECTION CAMERA TO CONTROLLER	EA	2

GEOMETRIC LEGEND

EXISTING GEOMETRICS

PROPOSED GEOMETRICS

UTILITY LEGEND

GAS MAIN

WATER MAIN

SEWER MAIN

ELECTRIC CABLES

STORM DRAIN

AERIAL CABLES

TELEPHONE CABLES

VIDEO CAMERA LEGEND

= VIDEO CABLE (PATH TO CONTROLLER)

REVISIONS

INSTALL VIDEO DETECTION SHA No. AT3085185 3/ /04

SWA

ASBUILT September 16, 1996

S.H.A. No.:BW 855-25057054

FJH

SHA #: AA.348A51/B51 TOD #: AT308-02

APPROVALS

ASST. DIVISION CHIEF TRAFFIC ENGINEERING DESIGN DIVISION

CHIEF, TRAFFIC ENGINEERING DESIGN DIVISION

ASST. DISTRICT ENGINEER - TRAFFIC

DIRECTOR, OFFICE OF TRAFFIC & SAFETY

ORIGINAL ON FILE

SABRA, WANG & ASSOCIATES, INC.
1504 JOH AVENUE
SUITE 160
BALTIMORE, MD 21227
(410) 737-6564
WWW.SABRA-WANG.COM

MDOT – STATE HIGHWAY ADMINISTRATION
Office of Traffic & Safety
TRAFFIC ENGINEERING DESIGN DIVISION

DRAWN BY: D. Zafiris
DES. BY: D. Doda 8-4-75
CHK. BY: A. Budnichuck 8-15-75

(Traffic Signal Plan)
MD 70 at Melvin Avenue\ Farragut Road

COUNTY: ANNE ARUNDEL LOG MILE • 0200700098

DATE: Feb. 12, 1975 F.A.P. NO. N/A
SCALE: 1" = 20' S.H.A. NO. AA-071X-000-585

TS/STD. NO. 1198~~H~~I

SHEET NO. 1 of 1

FILE: r:\02-12 2001-12c\task 12\dwg\tif\anne arundel\70.melvin.dgn
DATE: 27-Feb-04 16:57