F H WA REGION NO	STATE	FED. AID PROJ. NO	SHEET NO.	TOTAL SHEETS
3	MD.			

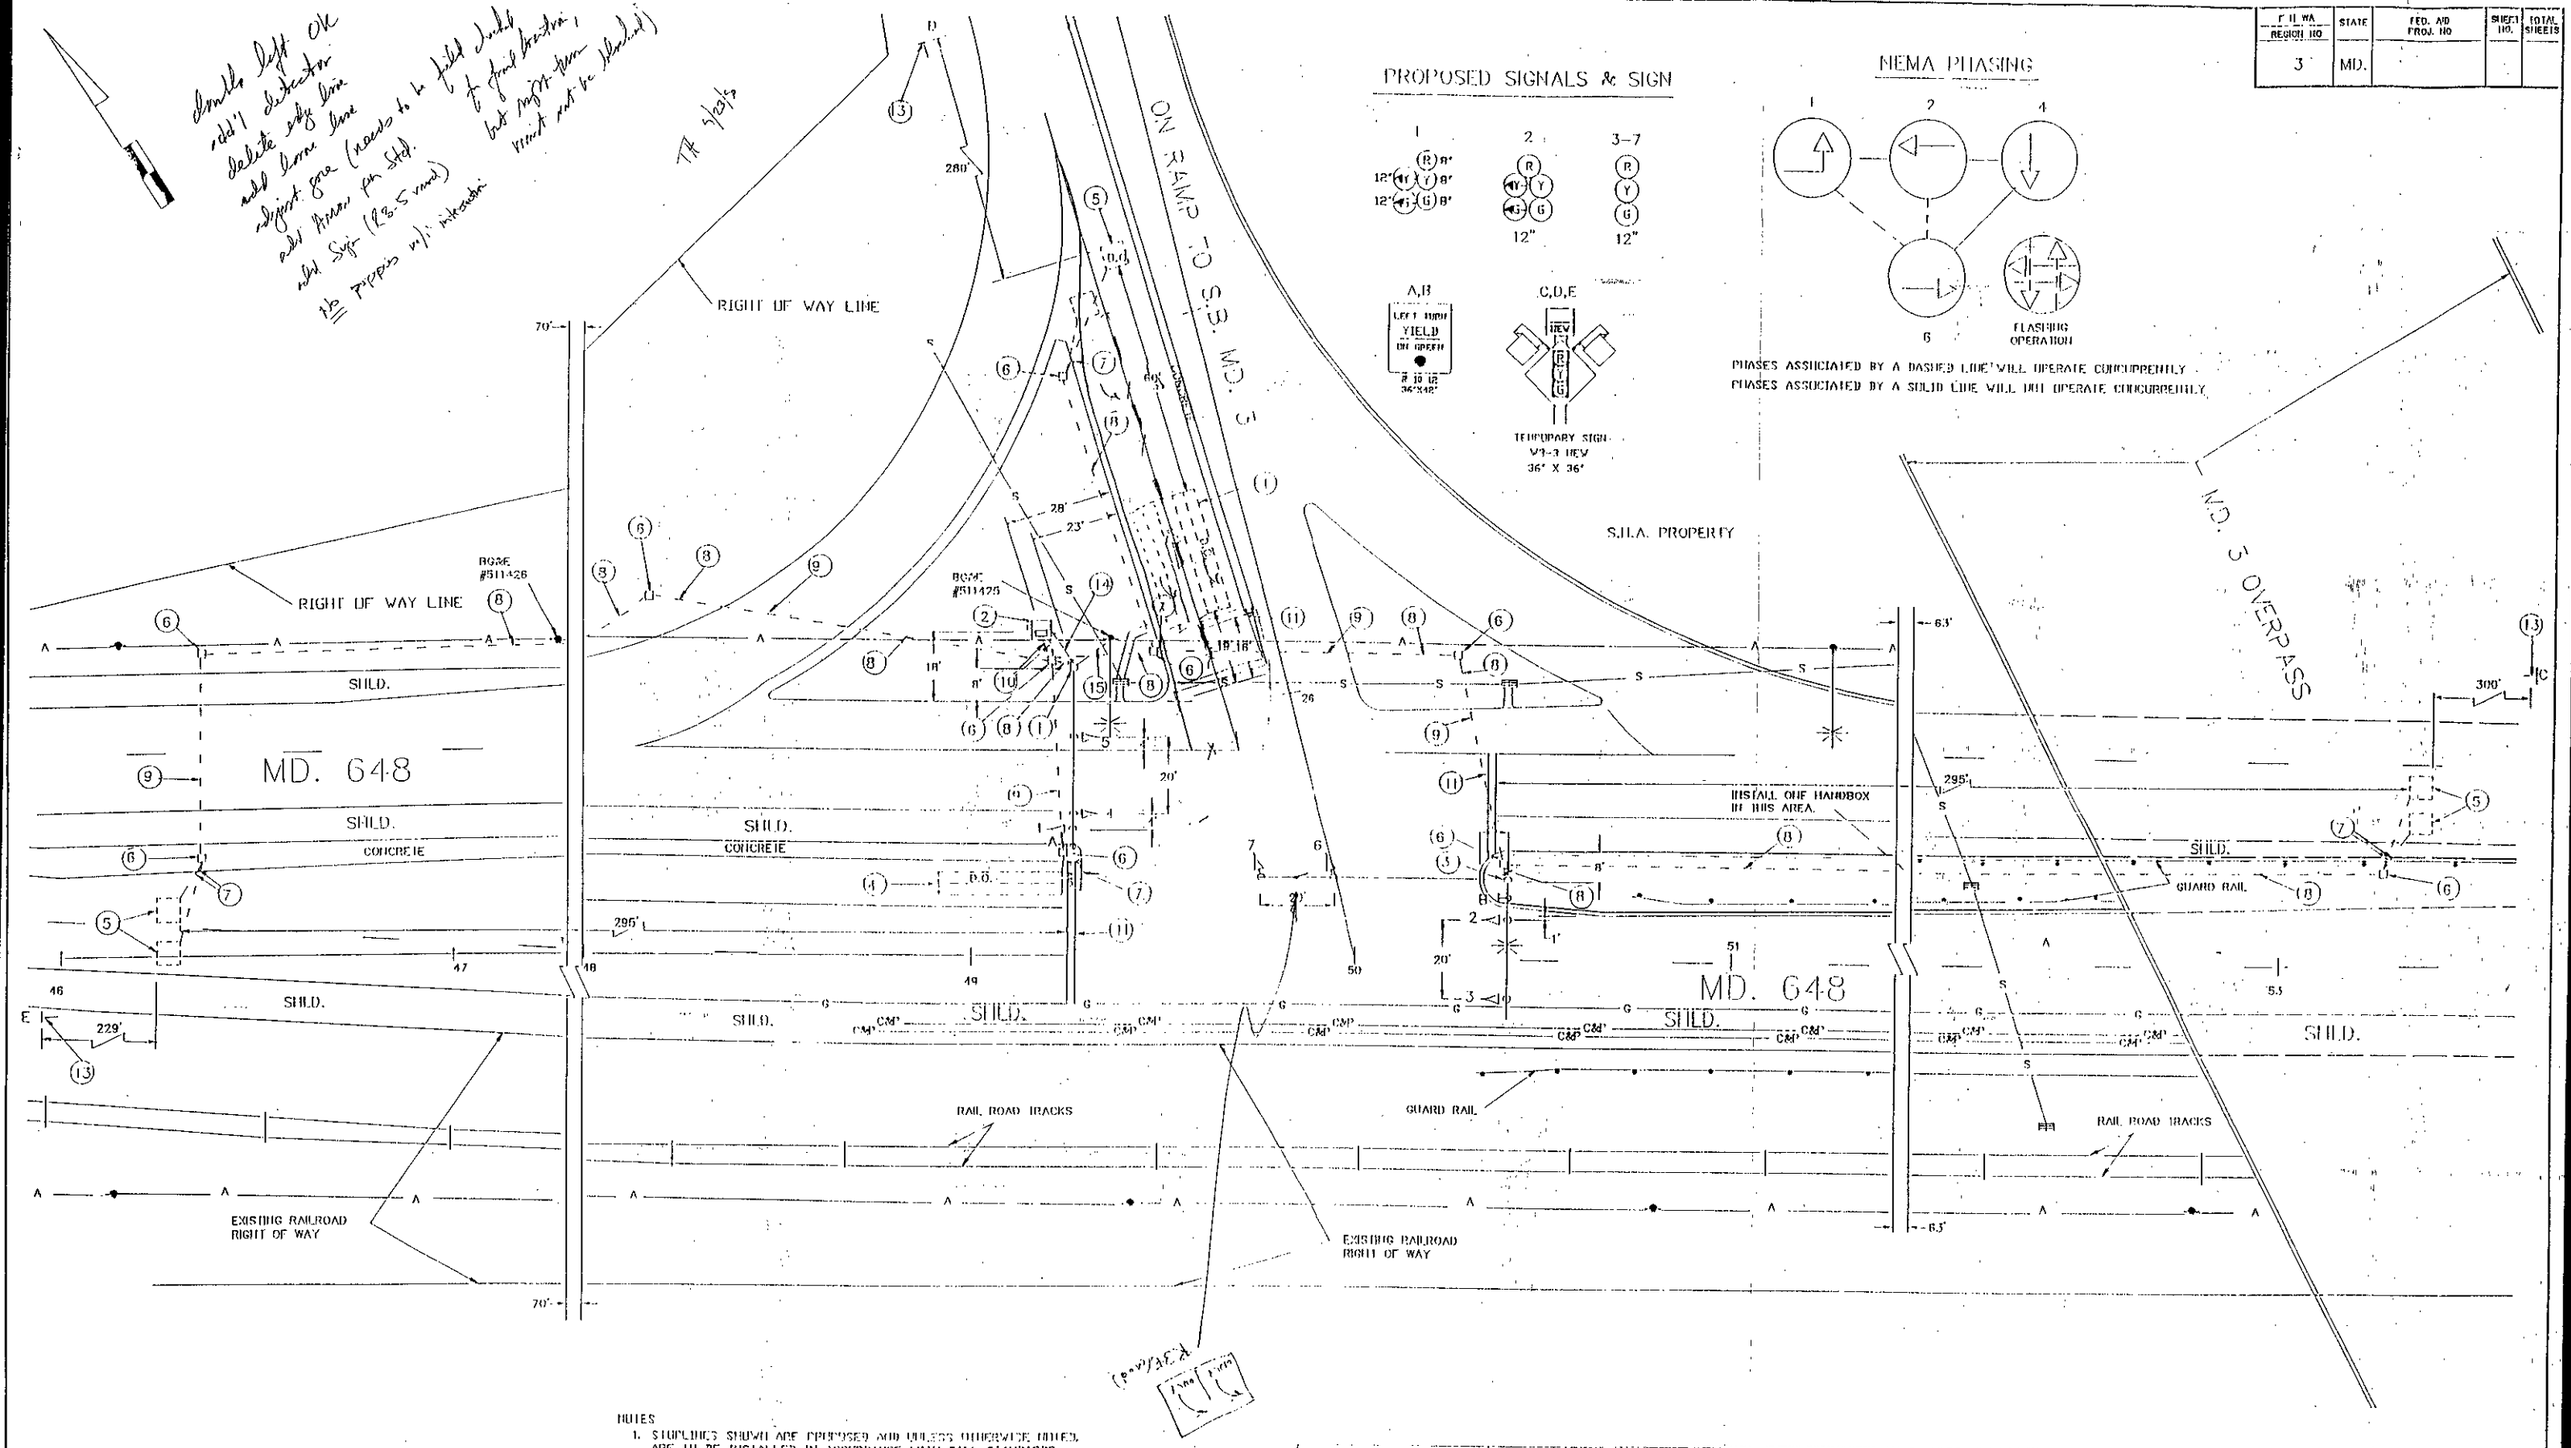

NOTES
1. STRIPING SHOWN ARE PROPOSED AND UNLESS OTHERWISE NOTED, ARE TO BE INSTALLED IN ACCORDANCE WITH SHA STANDARDS.
2. "D.D." INDICATES A DELAY-DROPOUT LOOP DETECTOR

UTILITY LEGEND

—G—G—	GAS MAIN
—W—W—	WATER MAIN
—S—S—	SEWER MAIN
—E—E—	ELECTRIC CABLES
—A—A—	AERIAL CABLES
—CMP—CMP—	TELEPHONE CABLES

REVISIONS

APPROVALS

MDOT — STATE HIGHWAY ADMINISTRATION
Office of Traffic
TRAFFIC ENGINEERING DIVISION LOG MILE # 02009715.92

02009715.92

DRAWN BY: D. DISTANCE
DES. BY: D. DISTANCE
CHK. BY:
DATE: 8/90
SCALE: 1" = 20'
F.A.P. NO.
SHA NO.

MD. 648 & S.B. MD. 3 ON/OFF RAMP

COUNTY: ANNE ARUNDEL

IS/SHD. NO. 3028A

SHEET NO. OF