F H WA REGION NO	STATE	FED. AID PROJ. NO	SHEET NO.	TOTAL SHEETS
3	MD.			

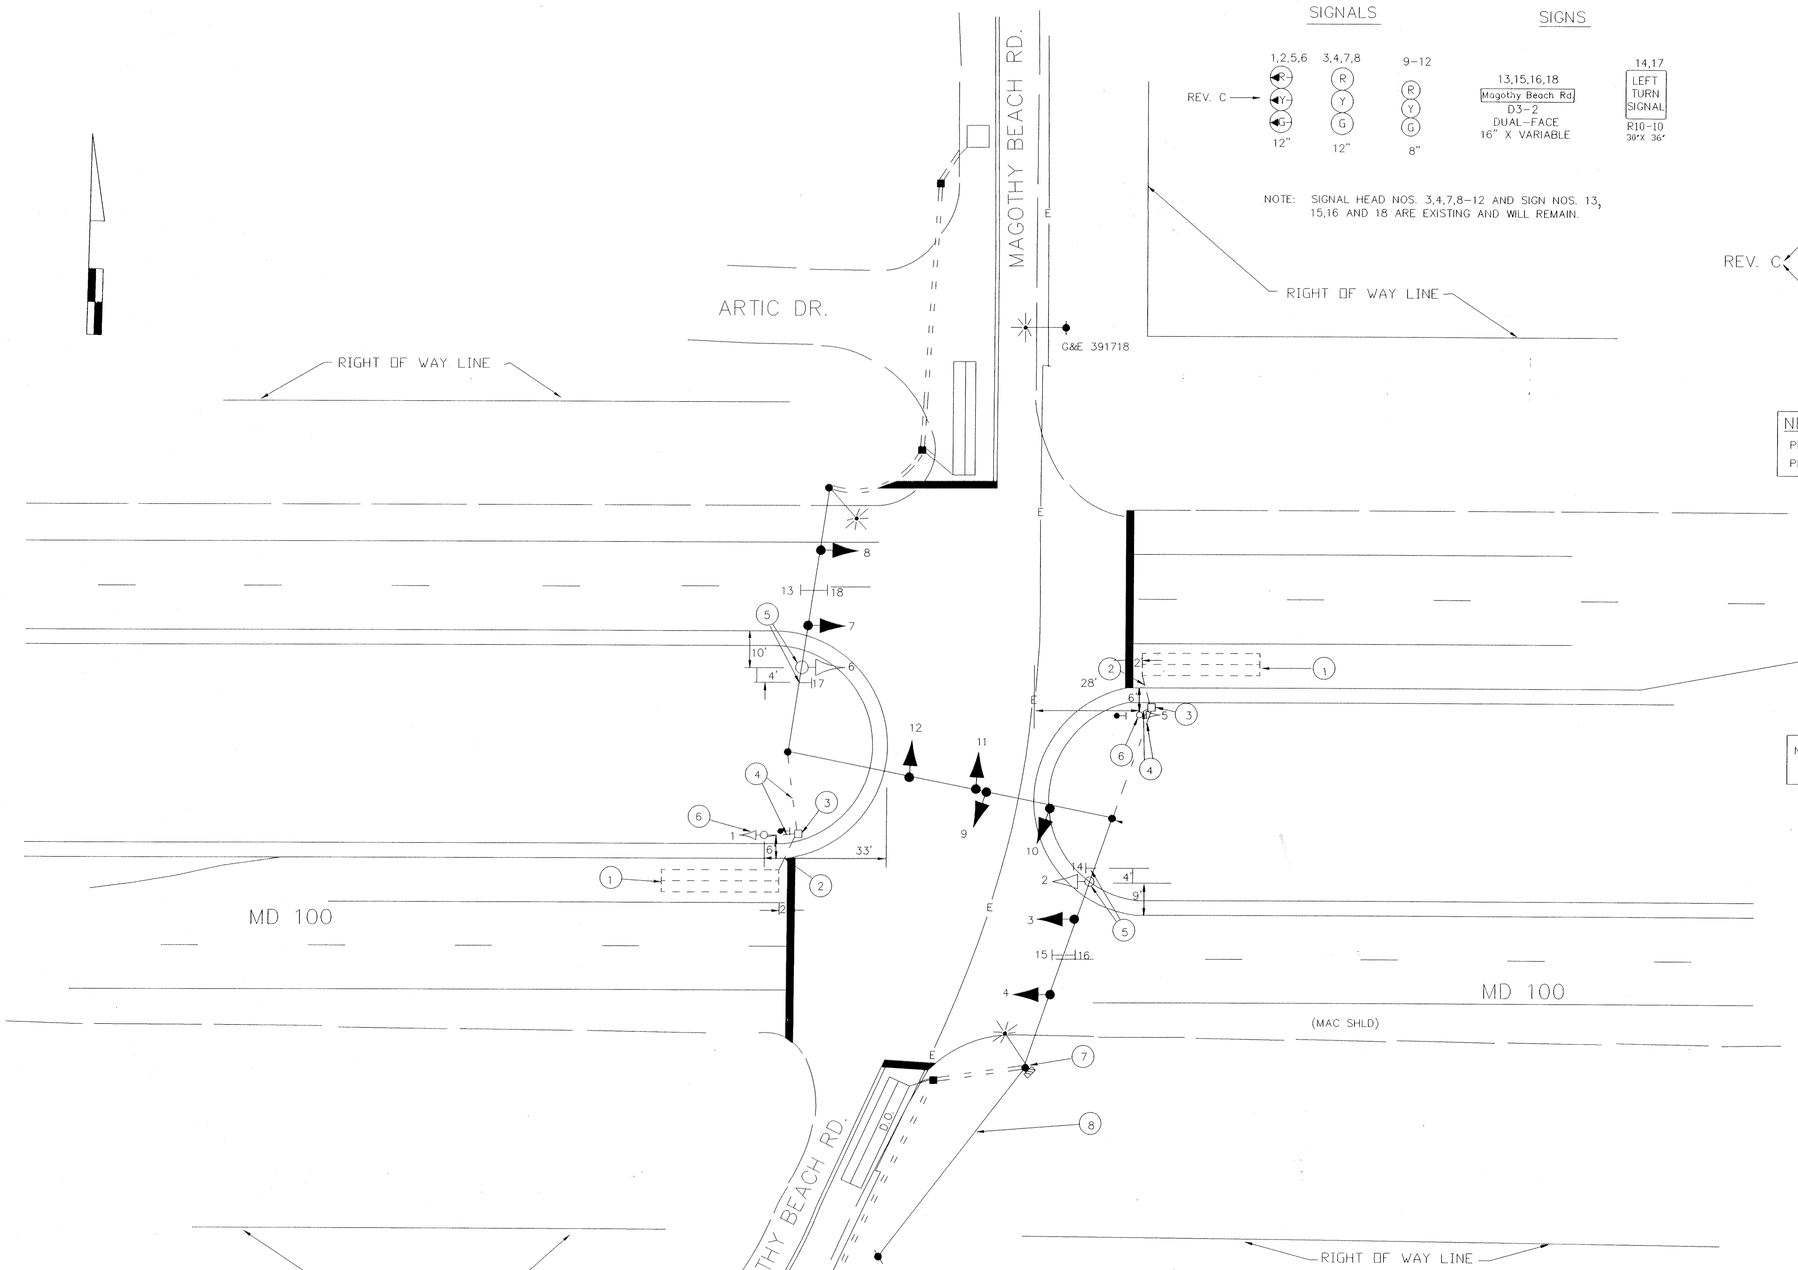

SIGNALS

SIGNS

NOTE: SIGNAL HEAD NOS. 3,4,7,8–12 AND SIGN NOS. 13, 15,16 AND 18 ARE EXISTING AND WILL REMAIN.

NEMA PHASING

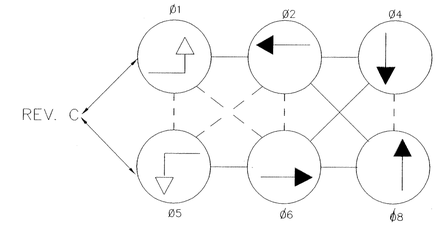

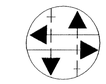

FLASHING OPERATION

NEMA NOTES

PHASES ASSOCIATED BY A DASHED LINE WILL OPERATE CONCURRENTLY
PHASES ASSOCIATED BY A SOLID LINE WILL NOT OPERATE CONCURRENTLY

NOTE: REVISION "C" IS A REVISION TO THE TRAFFIC SIGNAL BUILT IN 1976 UNDER CONTRACT AA-990-000-585

UTILITY LEGEND

G	GAS MAIN
W	WATER MAIN
S	SEWER MAIN
E	ELECTRIC CABLES
A	AERIAL CABLES
T	TELEPHONE CABLES

REVISIONS	APPROVALS
C INSTALL EXCLUSIVE LEFT-TURNS FOR EAST AND WESTBOUND MD 100 1/92 MEL 12/21/2022	ORIGINAL — CHIEF, SIGNAL DESIGN SECTION
B CHANGED FROM HIB TO SEMI-ACTUATED SIGNAL SHA NO. 855-25005 1/8/86 DLA SAR DAZ ETP TH	NOTED — ASST. DISTRICT ENGINEER, TRAFFIC
A ASBUILT 12/27/78 AA-990X-000-585 MM DJD DAZ ETP TH	ON — CHIEF, TRAFFIC ENGINEERING DIVISION
	FILE — DEPUTY CHIEF ENGINEER, OFFICE OF TRAFFIC

MDOT – STATE HIGHWAY ADMINISTRATION
OFFICE OF TRAFFIC & SAFETY
TRAFFIC ENGINEERING DESIGN DIVISION

DRAWN BY: DIMITRIOS ZAFIRIS
DES. BY: DIMITRIOS ZAFIRIS
CHK. BY: AL BUDNICHUK

MD 100 & MAGOTHY BEACH RD.
ANNE ARUNDEL COUNTY

DATE: 10-17-75
SCALE: 1" = 20'
F.A.P. NO.
S.H.A. NO. AA-990-000-585
TS/STD. NO. TS-1379C
SHEET NO. 1 OF 1

F#5

02010000.45