



F H WA REGION NO	STATE	FED. AID PROJ. NO	SHEET NO.	TOTAL SHEETS
3	MD.	SEE TITLE SHEET	59A	68

**SIGNALS**

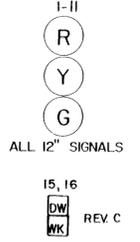

**NEMA PHASING**

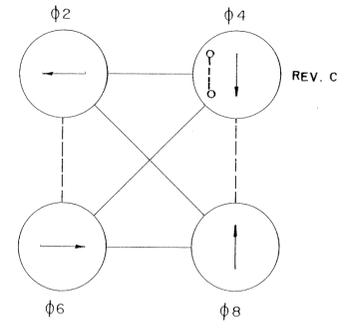

**PHASING NOTES**

1. PHASES ASSOCIATED BY A SOLID LINE WILL NOT OPERATE CONCURRENTLY.
2. PHASES ASSOCIATED BY A DASHED LINE WILL OPERATE CONCURRENTLY.

12, 13  
ANDOVER ROAD  
D3-2  
16" X VAR.

14  
AVIATION BLVD.  
D3-2  
16" X VAR.

MD 162

MD 162

HISTORIC HOUSE  
ENTRANCE

PROPOSED GEOMETRICS

PROPOSED GEOMETRICS

**GENERAL NOTES**

1. ALL PAVEMENT MARKINGS SHOWN ARE PROPOSED AND, UNLESS OTHERWISE NOTED, ARE TO BE INSTALLED BY DISTRICT FORCES IN ACCORDANCE WITH S.H.A. STANDARDS.
2. "D.O." INDICATES A DELAY-OUTPUT LOOP DETECTOR.
3. LOOP DETECTORS AND CONDUIT SHALL BE INSTALLED PRIOR TO THE INSTALLATION OF PAVEMENT MARKINGS.
4. REVISION C IS A MODIFICATION TO WORK COMPLETED UNDER CONTRACT AA-442-501-583, DATED 5/87.

NOTE: ALL LAND SHOWN ON THIS PLAN IS STATE AVIATION ADMINISTRATION PROPERTY.

—G—G—	GAS MAIN
—W—W—	WATER MAIN
—S—S—	SEWER MAIN
—E—E—	ELECTRIC CABLES
—T—T—	TELEPHONE CABLES
—A—A—	AERIAL CABLES

TS-3 OF TS-10

**KCI**  
KIDDE CONSULTANTS, INC.  
1020 CROMWELL BRIDGE ROAD  
TOWSON, MARYLAND 21204  
PHONE: (301) 321-5500

REVISIONS	APPROVALS
3. APPENDUM 12-5-91 NEW SHEET  B 11-10-91, S.H.A. AA463-501-571 RELOCATE MAST ARM POLE IN SOUTHEAST QUADRANT 8-25-87  C SHA NO. AA 463-501-571 INSTALL PEDESTAL POLE AND PEDESTRIAN SIGNALS 5-2-88 8-25-87  ADD 12-1-87 Reloc Fuel to revised transformer location 8-11-87	[Signature] 8/25/87 CHIEF, SIGNAL DESIGN SECTION  [Signature] 8/24/87 ASST. DISTRICT ENGINEER, TRAFFIC  [Signature] 8-25-87 CHIEF, BUREAU OF TRAFFIC ENGINEERING  [Signature] 8-25-87 DEPUTY CHIEF ENGINEER, OFFICE OF TRAFFIC

MARYLAND DEPARTMENT OF TRANSPORTATION STATE HIGHWAY ADMINISTRATION — OFFICE OF TRAFFIC BUREAU OF TRAFFIC ENGINEERING	
DRAWN BY: C.J.B. OF KIDDE	MD 162 / ANDOVER ROAD
DES. BY: B.J.H. OF KIDDE	COUNTY: ANNE ARUNDEL
CHK. BY: T.A.R. OF KIDDE	TS/FILE NO. TS-2337 ©
DATE: 5/87	SHEET NO. 59A OF 68
SCALE: 1" = 20'	F.A.P. NO. AA 463-501-571 S.H.A. NO. AA 132-533-572

0006701, 85