DRILL HOLES

BORDER REV: DATE: June 1, 2004

PROPOSED CAMERAS

VIDEO DETECTION CAMERA (a-b)

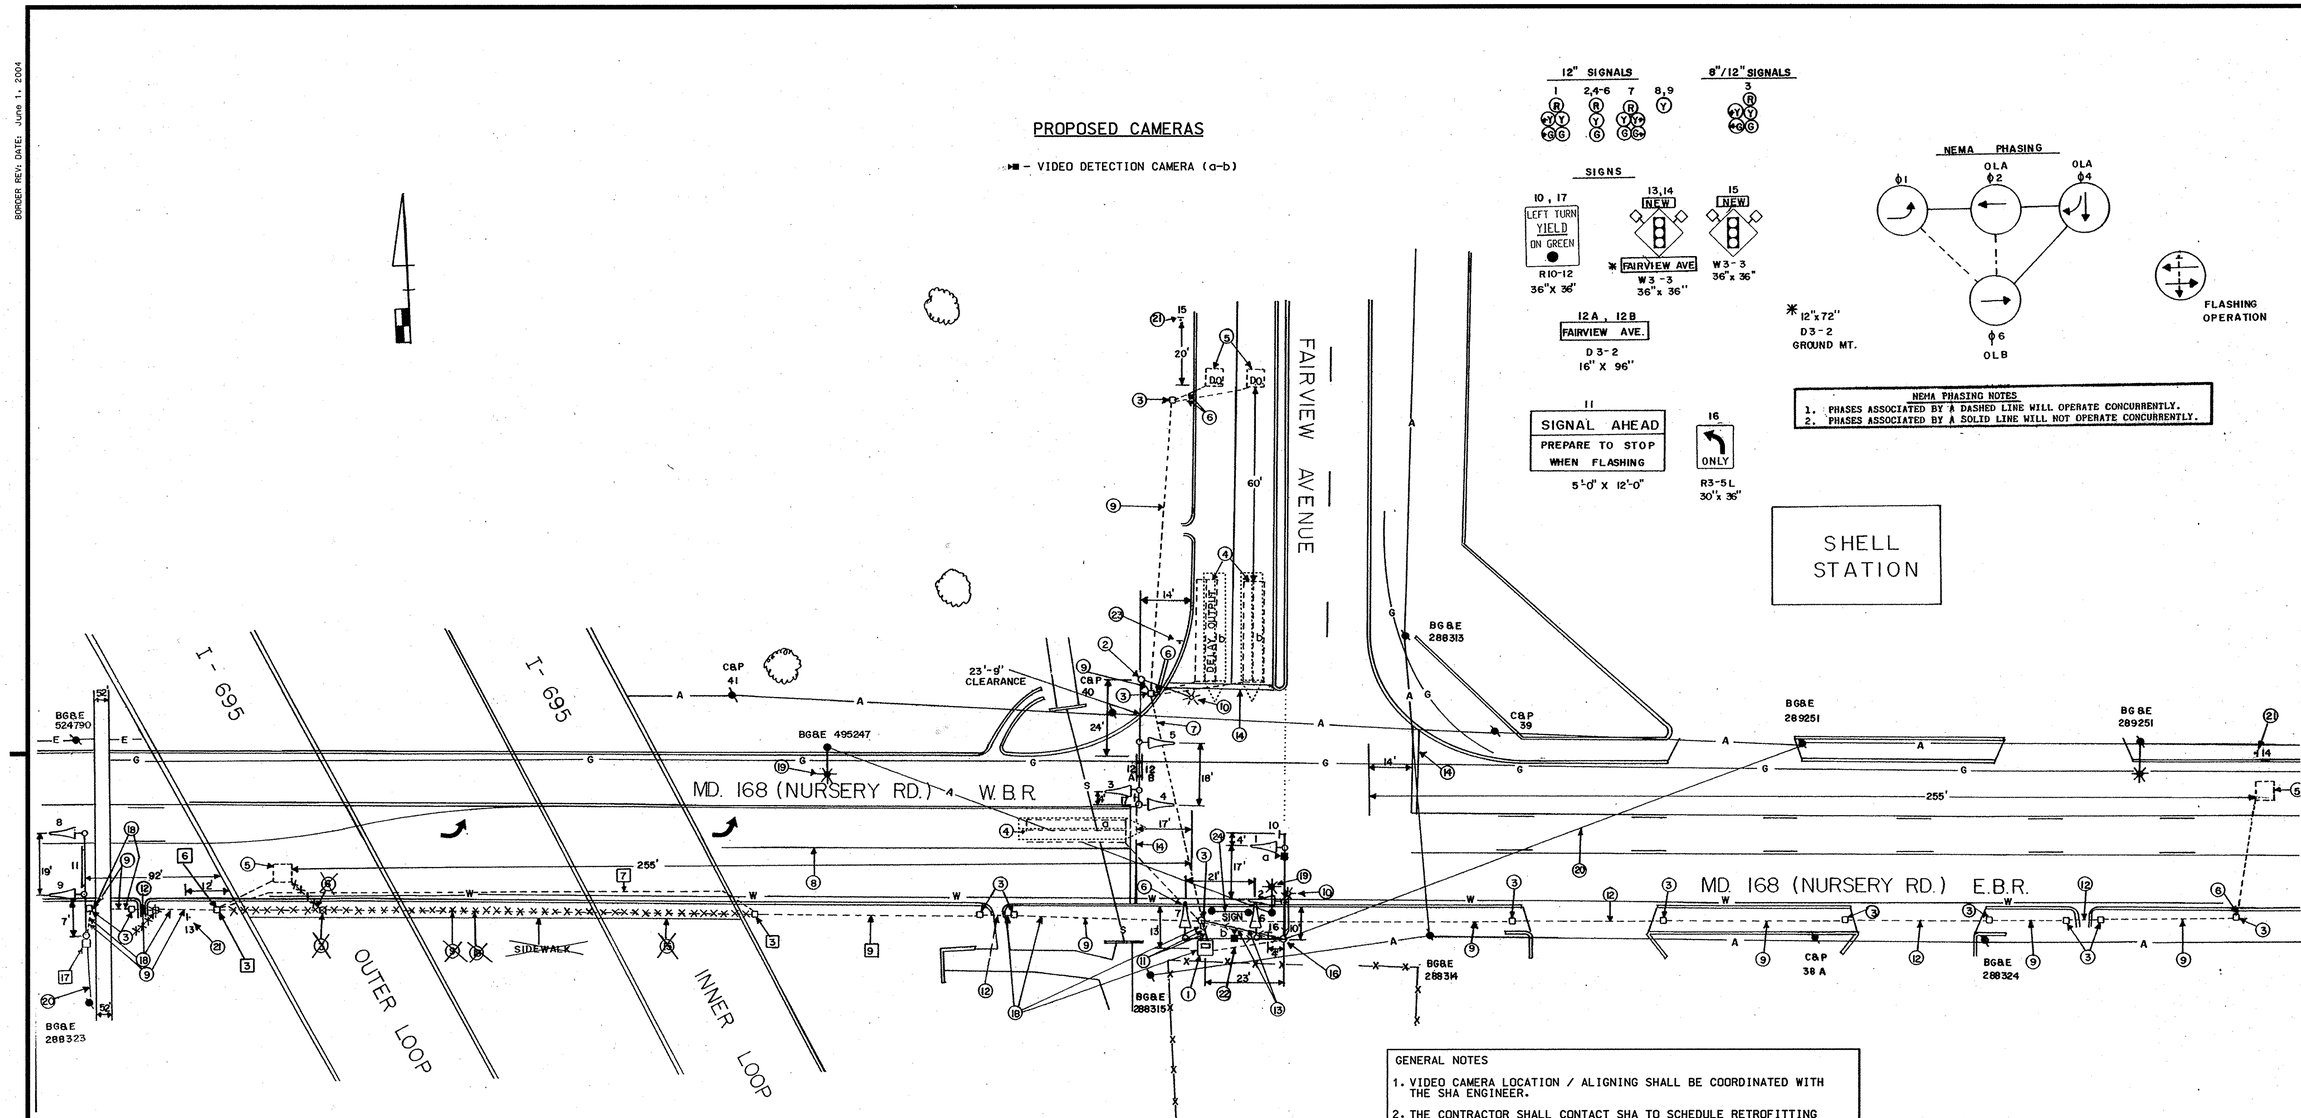

DRILL HOLES

DRILL HOLES

EQUIPMENT LIST

A. EQUIPMENT TO BE FURNISHED BY THE SHA

ITEM NO.	DESCRIPTION	QUANTITY
9086	VIDEO DETECTION INTERFACE EQUIPMENT WITH CABLES AND INTERFACE CARD (To be installed by SHA signal shop)	1 EA

B. EQUIPMENT TO BE FURNISHED AND/OR INSTALLED BY THE CONTRACTOR

ITEM NO.	DESCRIPTION	QUANTITY
1001	MAINTENANCE OF TRAFFIC PER ASSIGNMENT	1 EA
8004	* - REMOVE & DISPOSE FOR THIS INTERSECTION HAS ALREADY BEEN COVERED ON OTHER SHEET	
8026	VIDEO DETECTION CAMERA.	2 EA
8027	PRE MANUFACTURED CAMERA TO CONTROLLER (250' LENGTH) CABLE	2 EA

VIDEO CAMERA LEGEND

= VIDEO CABLE (PATH TO CONTROLLER)

GENERAL NOTES

1. VIDEO CAMERA LOCATION / ALIGNING SHALL BE COORDINATED WITH THE SHA ENGINEER.
2. THE CONTRACTOR SHALL CONTACT SHA TO SCHEDULE RETROFITTING OF THE CONTROLLER EQUIPMENT IN ORDER TO OPERATE VIDEO DETECTION EQUIPMENT.
3. THE CONTRACTOR SHALL BE RESPONSIBLE FOR TERMINATING ALL VIDEO DETECTION CAMERA CABLES TO THE APPROPRIATE TERMINALS AND PROPERLY LABEL EACH CABLE SO THAT SHA FORCES CAN MAKE THE FINAL CONNECTIONS.
4. THE INSTALLATION OF PROPOSED VIDEO DETECTION EQUIPMENT SHALL NECESSITATE THE REMOVAL OF EXISTING CABLES ASSOCIATED WITH THE PRESENCE LOOP DETECTORS BEING REPLACED BY VIDEO DETECTION.
5. ALL EXISTING TRAFFIC SIGNAL EQUIPMENT REMOVED SHALL BECOME THE PROPERTY OF THE SIGNAL CONTRACTOR UPON COMPLETION OF THE SIGNAL MODIFICATION.
6. ALL UNUSED SIGNAL CABLES SHALL BE REMOVED AND DISPOSED.

TOD No: AT724-04
SHA No: AA426A51/B51
Anne Arundel County

GEOMETRIC LEGEND
PROPOSED
EXISTING

LEGEND OF UNDERGROUND AND OVERHEAD UTILITIES
AERIAL CABLE — A — A —
ELECTRIC — E — E —
TELEPHONE — T — T —
GAS — G — G —
SEWER — S — S —
WATER — W — W —
CABLE TV — TV — TV —

REVISION "B"

STREET TRAFFIC STUDIES, LTD.
400 Crain Hwy. NW.
Glen Burnie, MD 21061
Ph (410) 590-5500
Fax (410) 590-6637

5061H777C.DGN D6-79

APPROVALS	
TEAM LEADER	ORIGINAL ON FILE
ASST. DIV. CHIEF	
DIVISION CHIEF	
OFFICE DIRECTOR	

REVISIONS	
B 3/2006	TMS NO.:H777 REPLACE LOOP DETECTION WITH VIDEO CAMERAS SHA NO.:AT7245185
JWA	
A 11/1992	SHA NO.:AA5185095B5 REVISE EB MD 168, MODIFY CONDUIT RUN & HB POLE
ERS	

PLOTTED: $DATETIME$
FILE: $FILE$

STATE OF MARYLAND
DEPARTMENT OF TRANSPORTATION
STATE HIGHWAY ADMINISTRATION

MD 168 (WEST NURSERY RD) AND FAIRVIEW AVE

SCALE N/A DATE 6/1/1992 CONTRACT NO.

DESIGNED BY GENE SIMMERS
DRAWN BY GENE SIMMERS
CHECKED BY
F.A.P. NO.

COUNTY ANNE ARUNDEL
LOGMILE 02016800.16
TIMS NO. H777
TOD NO.

TS NO. 3250B | DRAWING NO. 3 OF 4 | SHEET NO. OF

...\5000$\5061\77\5061h77c.dgn Mar. 15, 2006 08:36:38