FHWA REGION NO.	STATE	FED. AID PROJ. NO.	SHEET NO.	TOTAL SHEETS
3	MD.		2	5

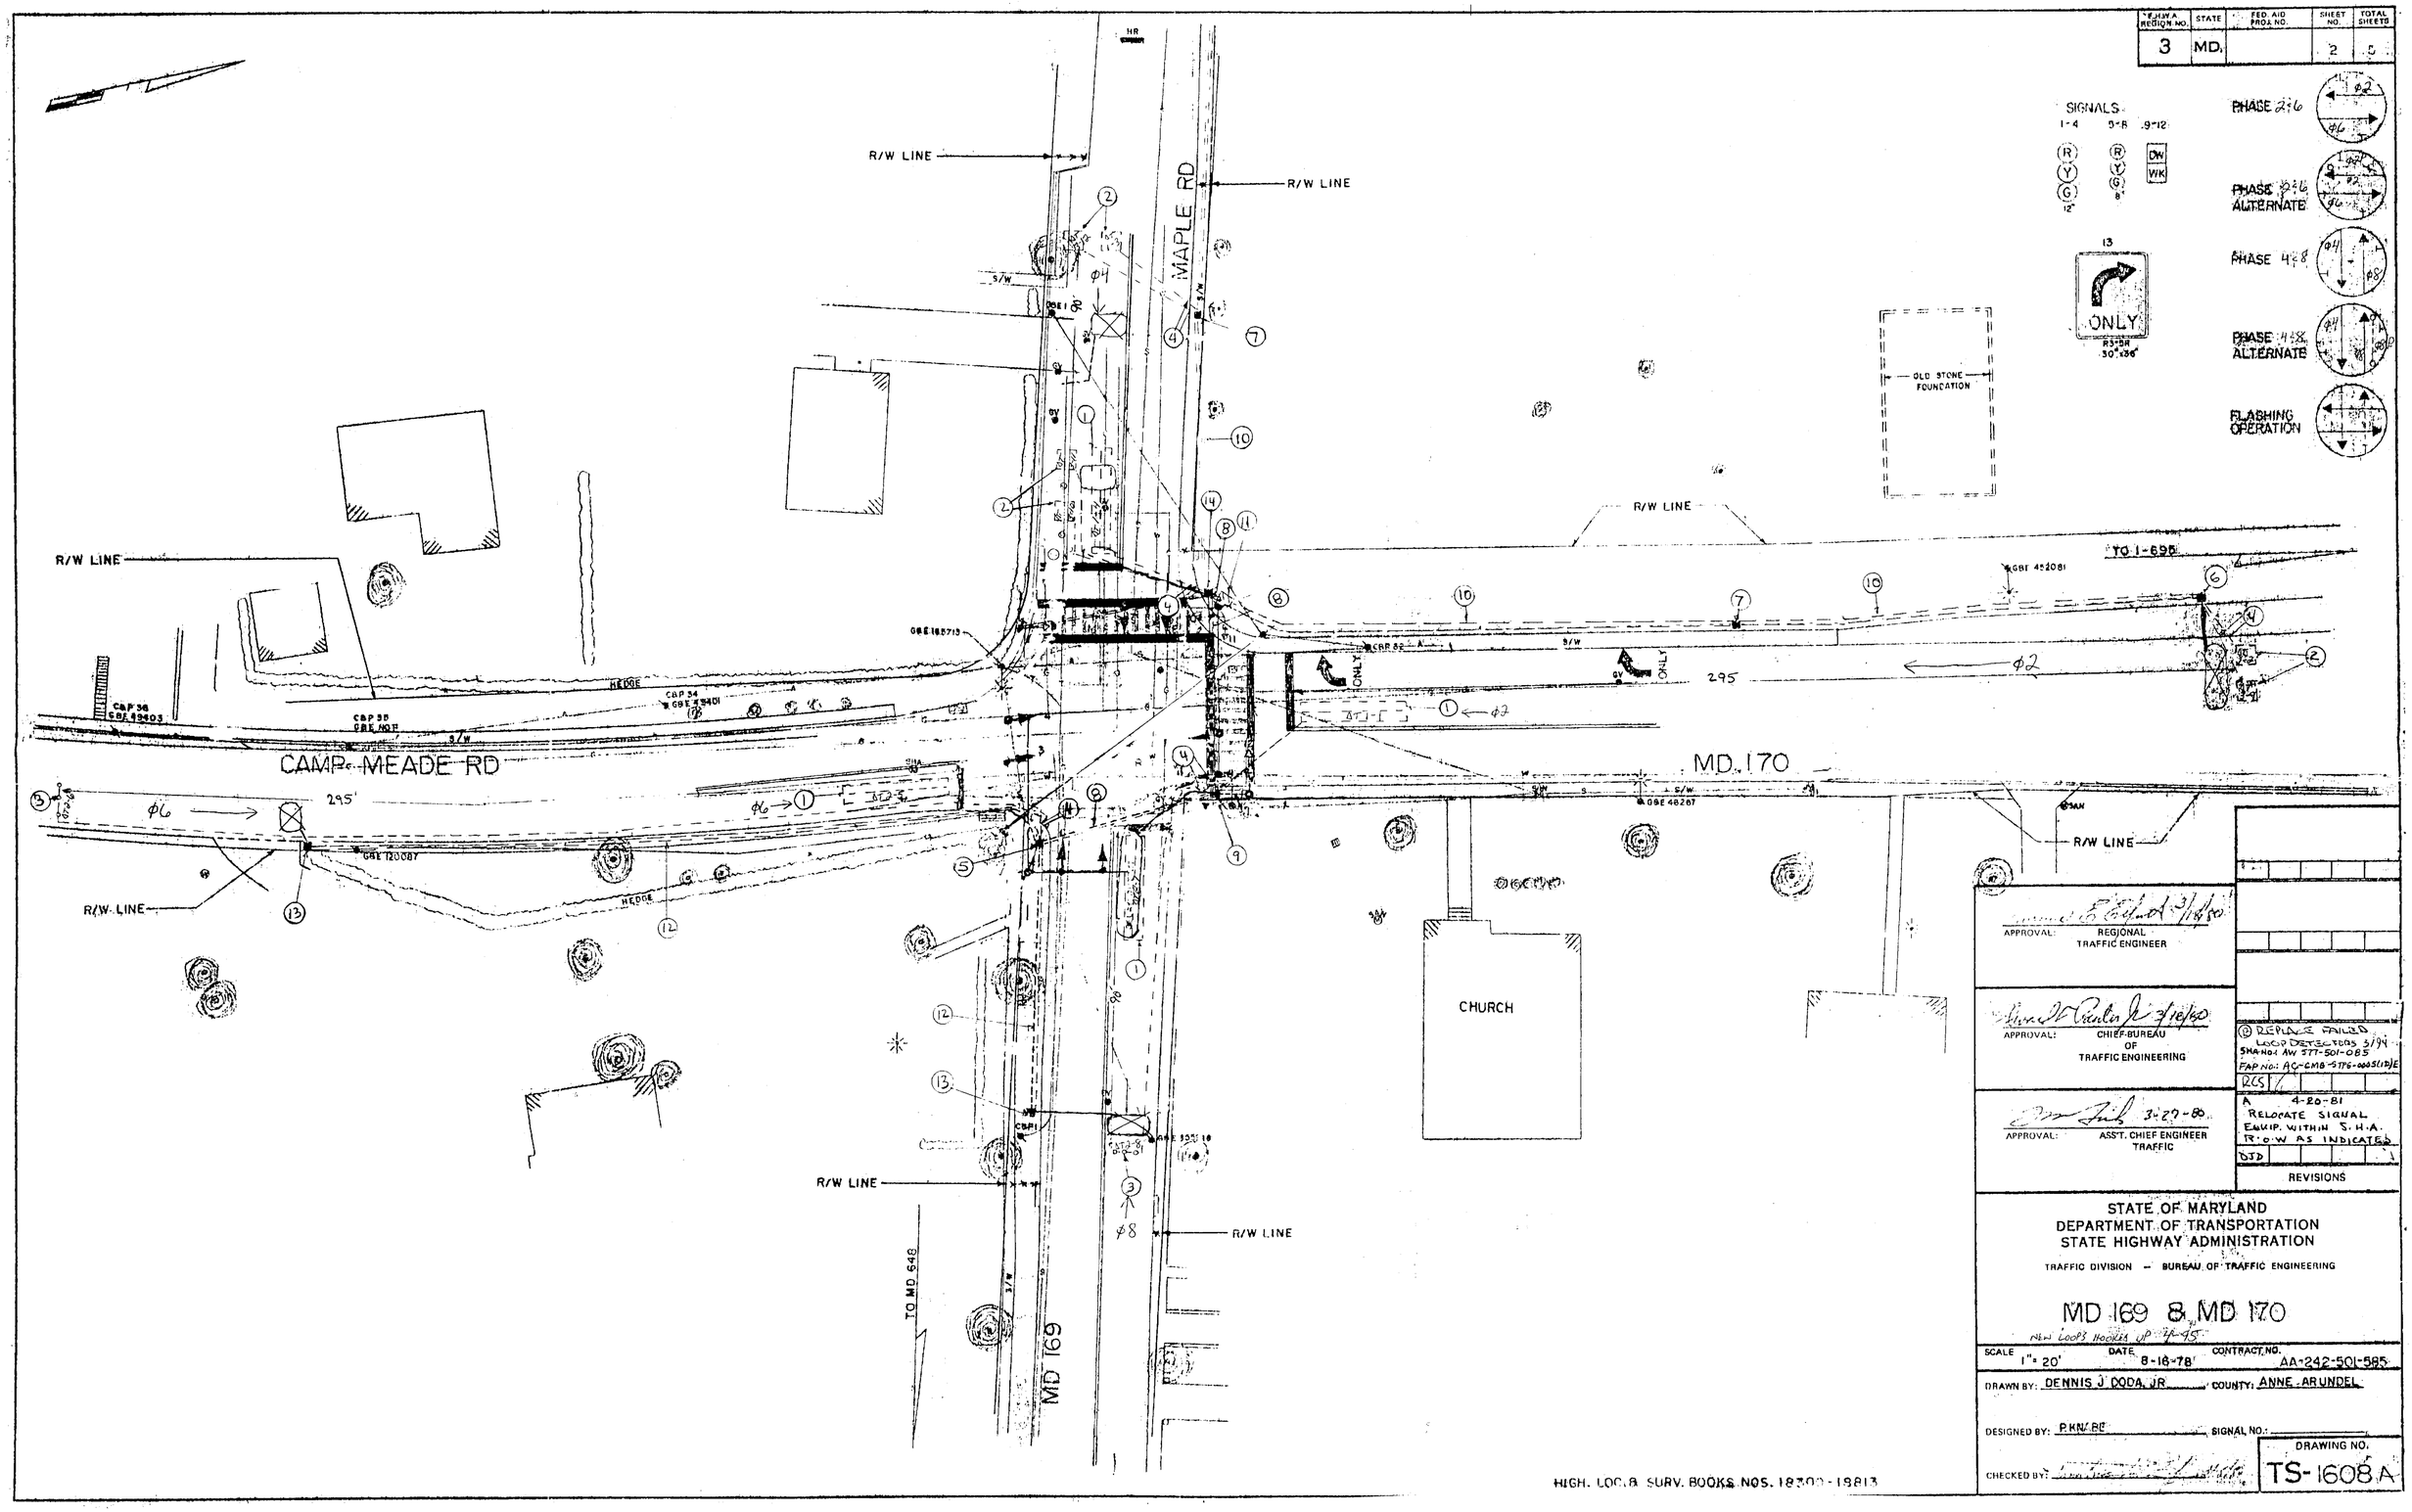

APPROVAL: REGIONAL TRAFFIC ENGINEER 3/18/80

APPROVAL: CHIEF BUREAU OF TRAFFIC ENGINEERING 3/18/80

APPROVAL: ASS'T. CHIEF ENGINEER TRAFFIC 3-27-80

REVISIONS	
B	REPLACE FAILED LOOP DETECTORS 3/94 SHA-No: AW 377-501-085 FAP NO: AC-CMB-5176-0005(13)E RCS
A	4-20-81 RELOCATE SIGNAL EQUIP. WITHIN S.H.A. R/O/W AS INDICATED DJD

STATE OF MARYLAND
DEPARTMENT OF TRANSPORTATION
STATE HIGHWAY ADMINISTRATION

TRAFFIC DIVISION — BUREAU OF TRAFFIC ENGINEERING

MD 169 & MD 170

NEW LOOPS HOOKED UP 7-95

SCALE 1" = 20' DATE 8-18-78 CONTRACT NO. AA-242-501-585

DRAWN BY: DENNIS J. DODA, JR. COUNTY: ANNE ARUNDEL

DESIGNED BY: P.KN/BE SIGNAL NO.:

CHECKED BY:

DRAWING NO. TS-1608A

HIGH. LOC.& SURV. BOOKS NOS. 18300-18813