F.H.W.A. REGION NO.	STATE	FED. AID PROJ. NO.	SHEET NO.	TOTAL SHEETS
3	MD.			

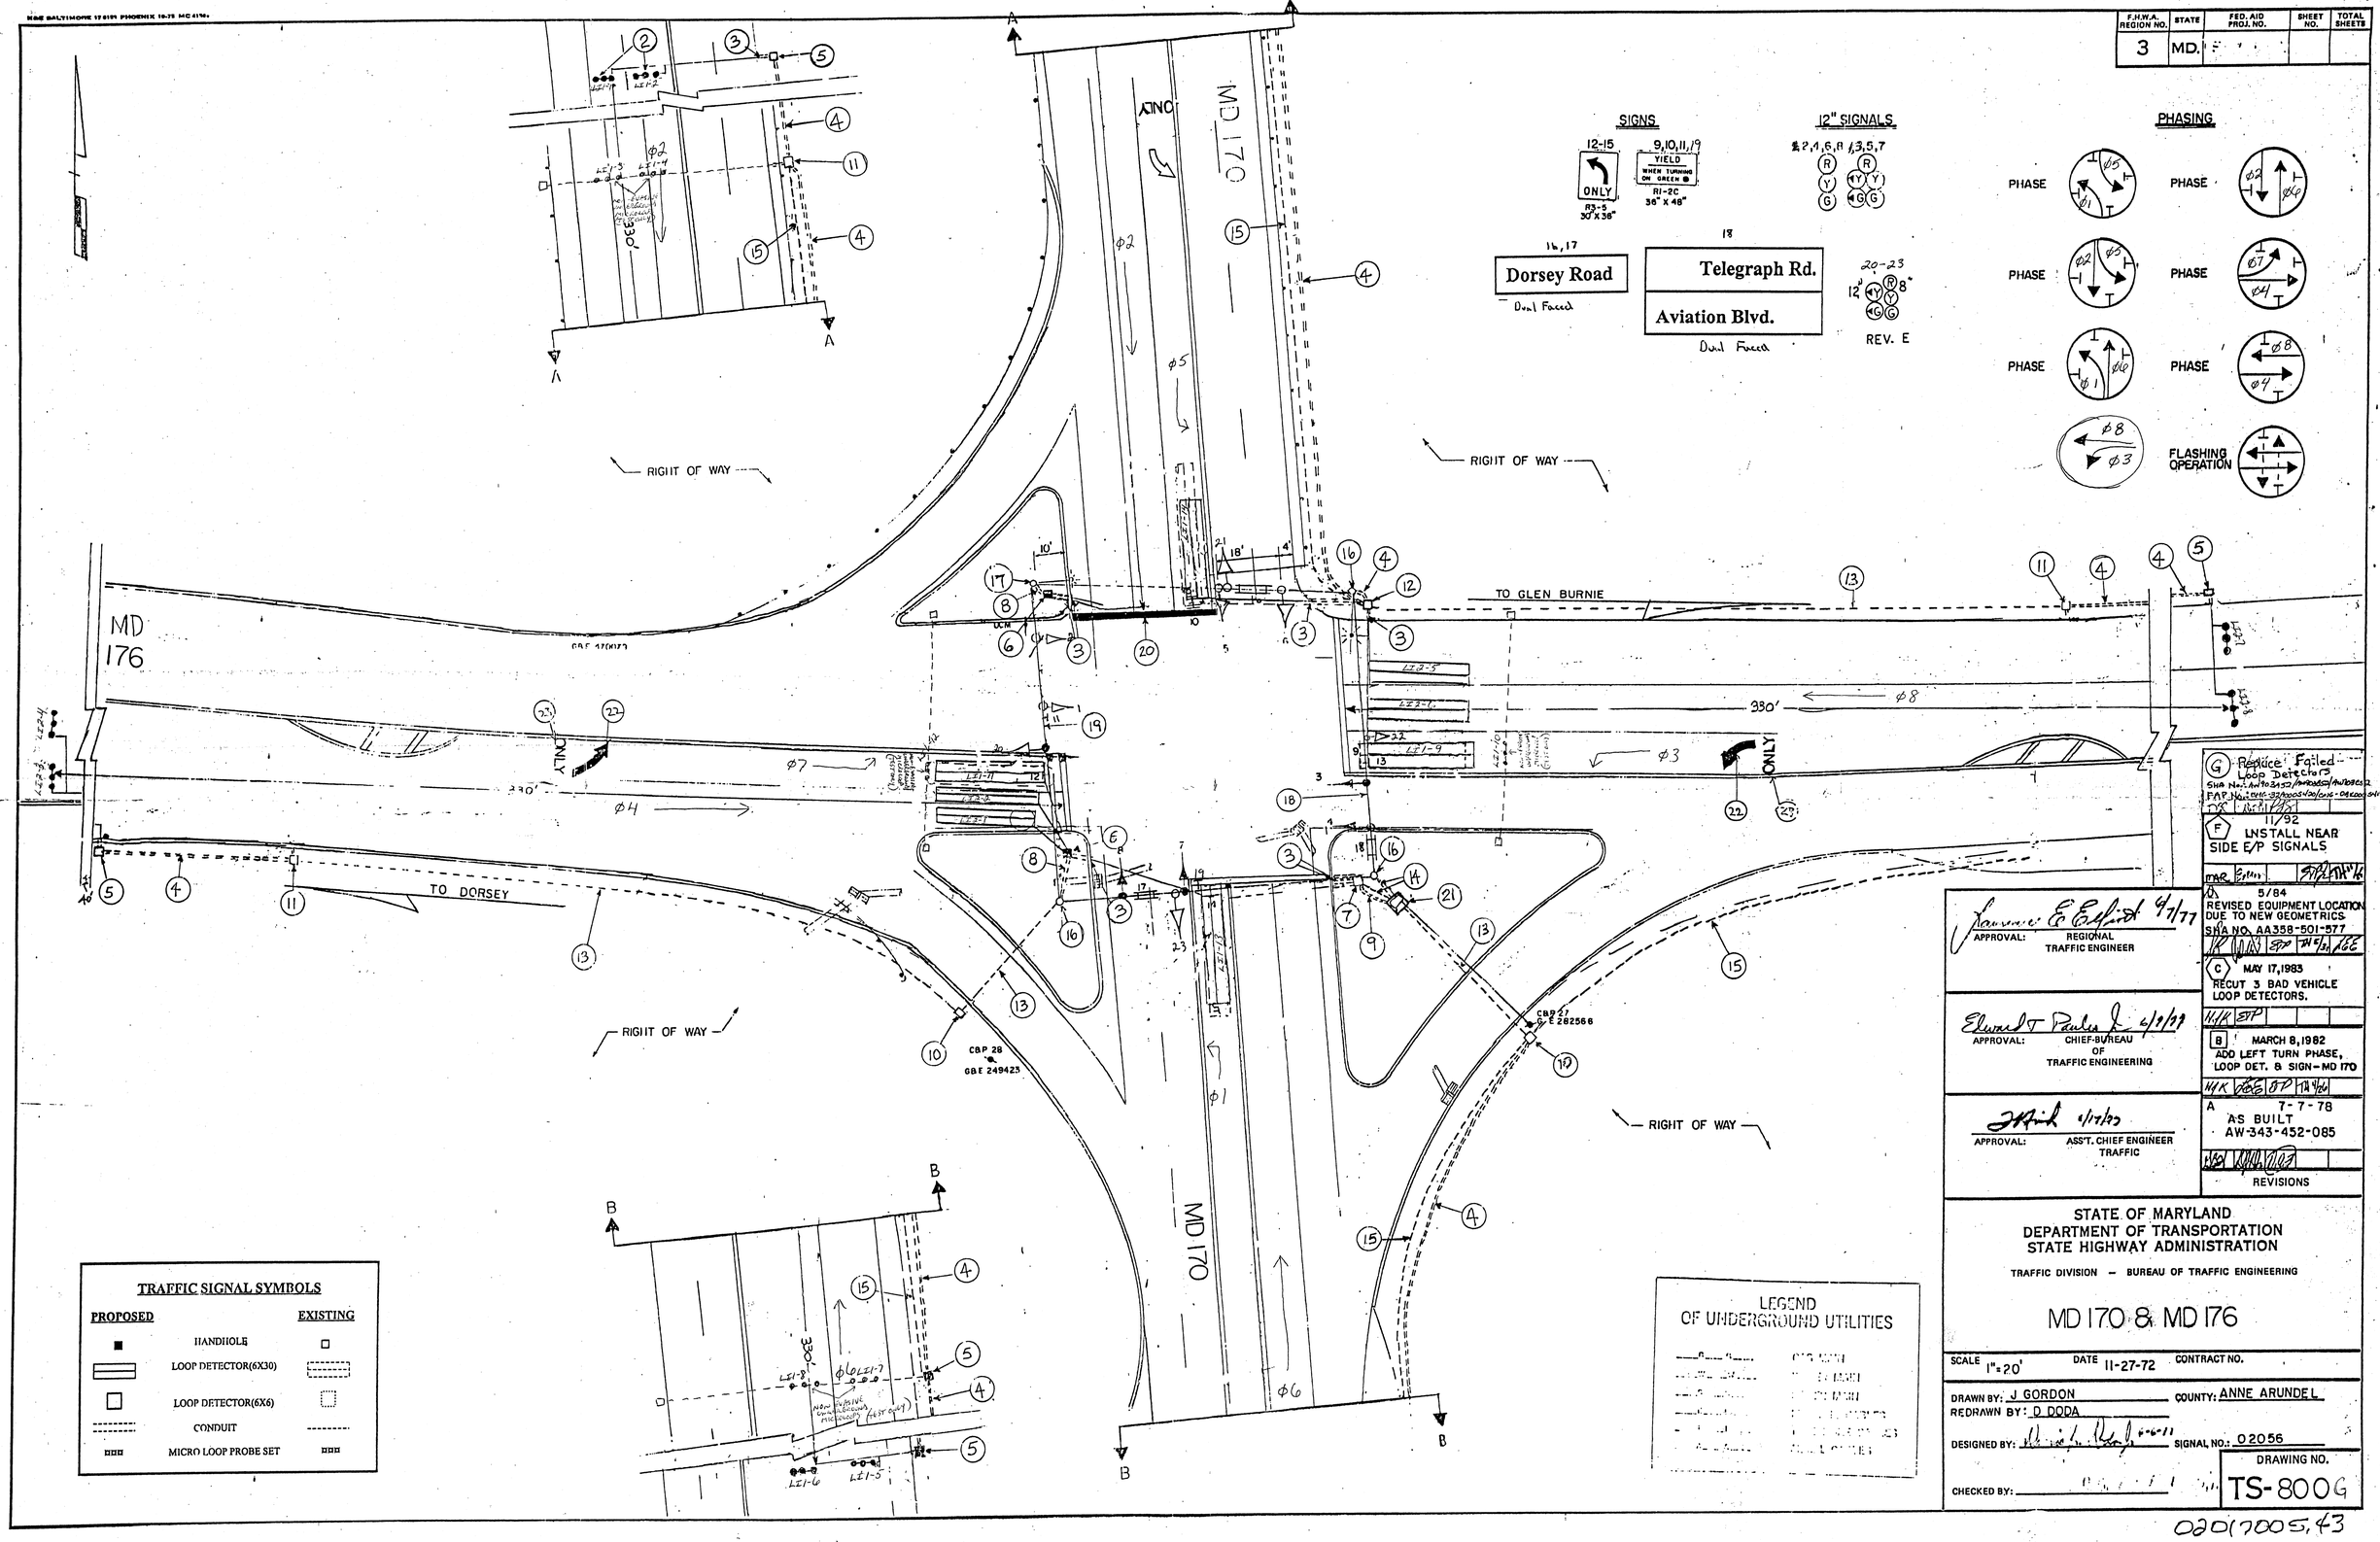

G Replace Failed Loop Detectors
SHA No.: AA-703-323/AA-703-324/AA-703-325-2
F.A.P. No.: BRHS-327(003)-30/CMS-08(200)-0418
11/92
F INSTALL NEAR SIDE E/P SIGNALS

5/84
REVISED EQUIPMENT LOCATION DUE TO NEW GEOMETRICS
SHA NO. AA338-501-577

C MAY 17, 1983
RECUT 3 BAD VEHICLE LOOP DETECTORS.

B MARCH 8, 1982
ADD LEFT TURN PHASE, LOOP DET. & SIGN - MD 170

A 7-7-78
AS BUILT
AW-343-452-085

REVISIONS

APPROVAL: REGIONAL TRAFFIC ENGINEER 4/7/77

APPROVAL: CHIEF-BUREAU OF TRAFFIC ENGINEERING 4/7/77

APPROVAL: ASS'T. CHIEF ENGINEER TRAFFIC 4/7/77

STATE OF MARYLAND
DEPARTMENT OF TRANSPORTATION
STATE HIGHWAY ADMINISTRATION

TRAFFIC DIVISION — BUREAU OF TRAFFIC ENGINEERING

MD 170 & MD 176

SCALE 1"=20' DATE 11-27-72 CONTRACT NO.

DRAWN BY: J GORDON COUNTY: ANNE ARUNDEL
REDRAWN BY: D DODA
DESIGNED BY: SIGNAL NO.: 02056
CHECKED BY:

DRAWING NO. TS-800G

02017005,43