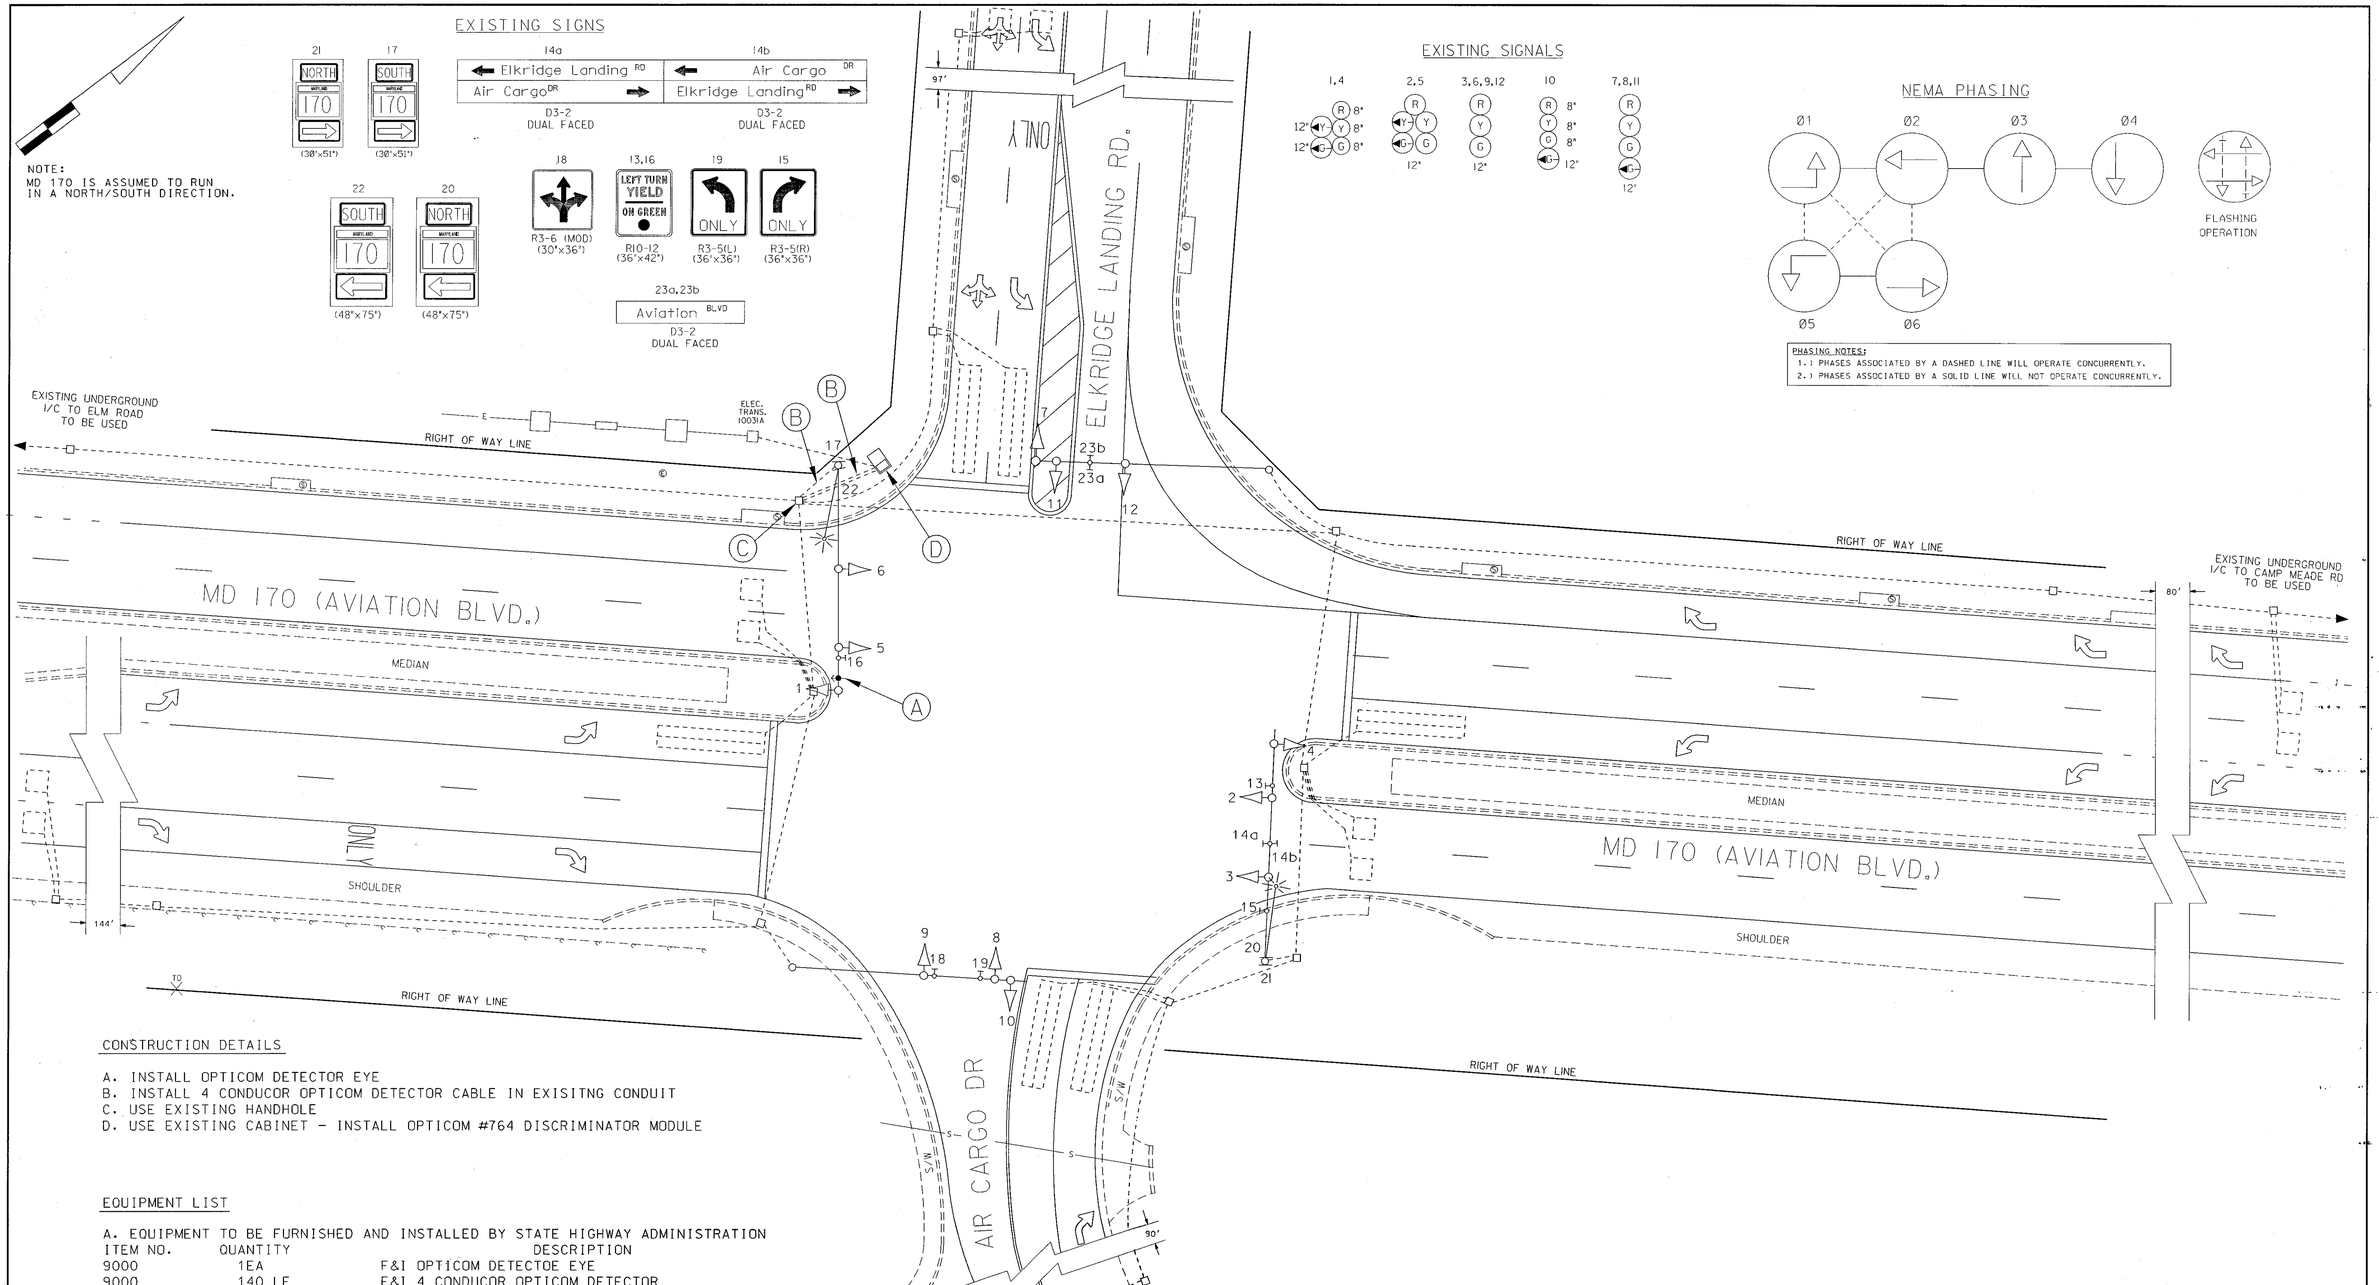

CONSTRUCTION DETAILS

A. INSTALL OPTICOM DETECTOR EYE
B. INSTALL 4 CONDUCOR OPTICOM DETECTOR CABLE IN EXISITNG CONDUIT
C. USE EXISTING HANDHOLE
D. USE EXISTING CABINET - INSTALL OPTICOM #764 DISCRIMINATOR MODULE

EQUIPMENT LIST

A. EQUIPMENT TO BE FURNISHED AND INSTALLED BY STATE HIGHWAY ADMINISTRATION

ITEM NO.	QUANTITY	DESCRIPTION
9000	1EA	F&I OPTICOM DETECTOE EYE
9000	140 LF	F&I 4 CONDUCOR OPTICOM DETECTOR
9000	1EA	F&I OPTICOM #764 DISCRIMINATOR MODULE

GEOMETRIC LEGEND
PROPOSED
EXISTING

LEGEND OF UNDERGROUND AND OVERHEAD UTILITIES
AERIAL CABLE
ELECTRIC
TELEPHONE
GAS
SEWER
WATER
CABLE TV

REVISIONS	APPROVALS
(E) INSTALL OPTICOM MARCH. 2004 TIMS 4304	TEAM LEADER, TRAFFIC ENGINEERING DESIGN DIVISION
D.EBY (B) 5-10-02 ADD SAMPLING STATIONS SHA NO.: XX1085185	ASST. CHIEF, TRAFFIC ENGINEERING DESIGN DIVISION
EMM C 9/97 AS BUILT BW 801-802-512	CHIEF, TRAFFIC ENGINEERING DESIGN DIVISION
RRZ B 8/95 RECONSTRUCTED SIGNAL TO GEOMETRIC IMPROVEMENT	DIRECTOR, TRAFFIC & SAFETY
DMP RCI	

ORIGINAL ON FILE

MARYLAND DOT - STATE HIGHWAY ADMINISTRATION
Office of Traffic & Safety
TRAFFIC ENGINEERING DESIGN DIVISION
MD 170 (AVIATION BLVD.) AT
AIR CARGO DR & ELKRIDGE LANDING RD

DRAWN BY:	F.A.P. NO.	TS NO. 1227D	SHEET NO.
CHECKED BY:	S.H.A. NO. BW 801-802-512		
SCALE: 1"= 20'	COUNTY: ANNE ARUNDEL	T.I.M.S. NO. F551	2 OF 4
DATE: JUNE 13, 1995	LOG MILE: 02017008.25		