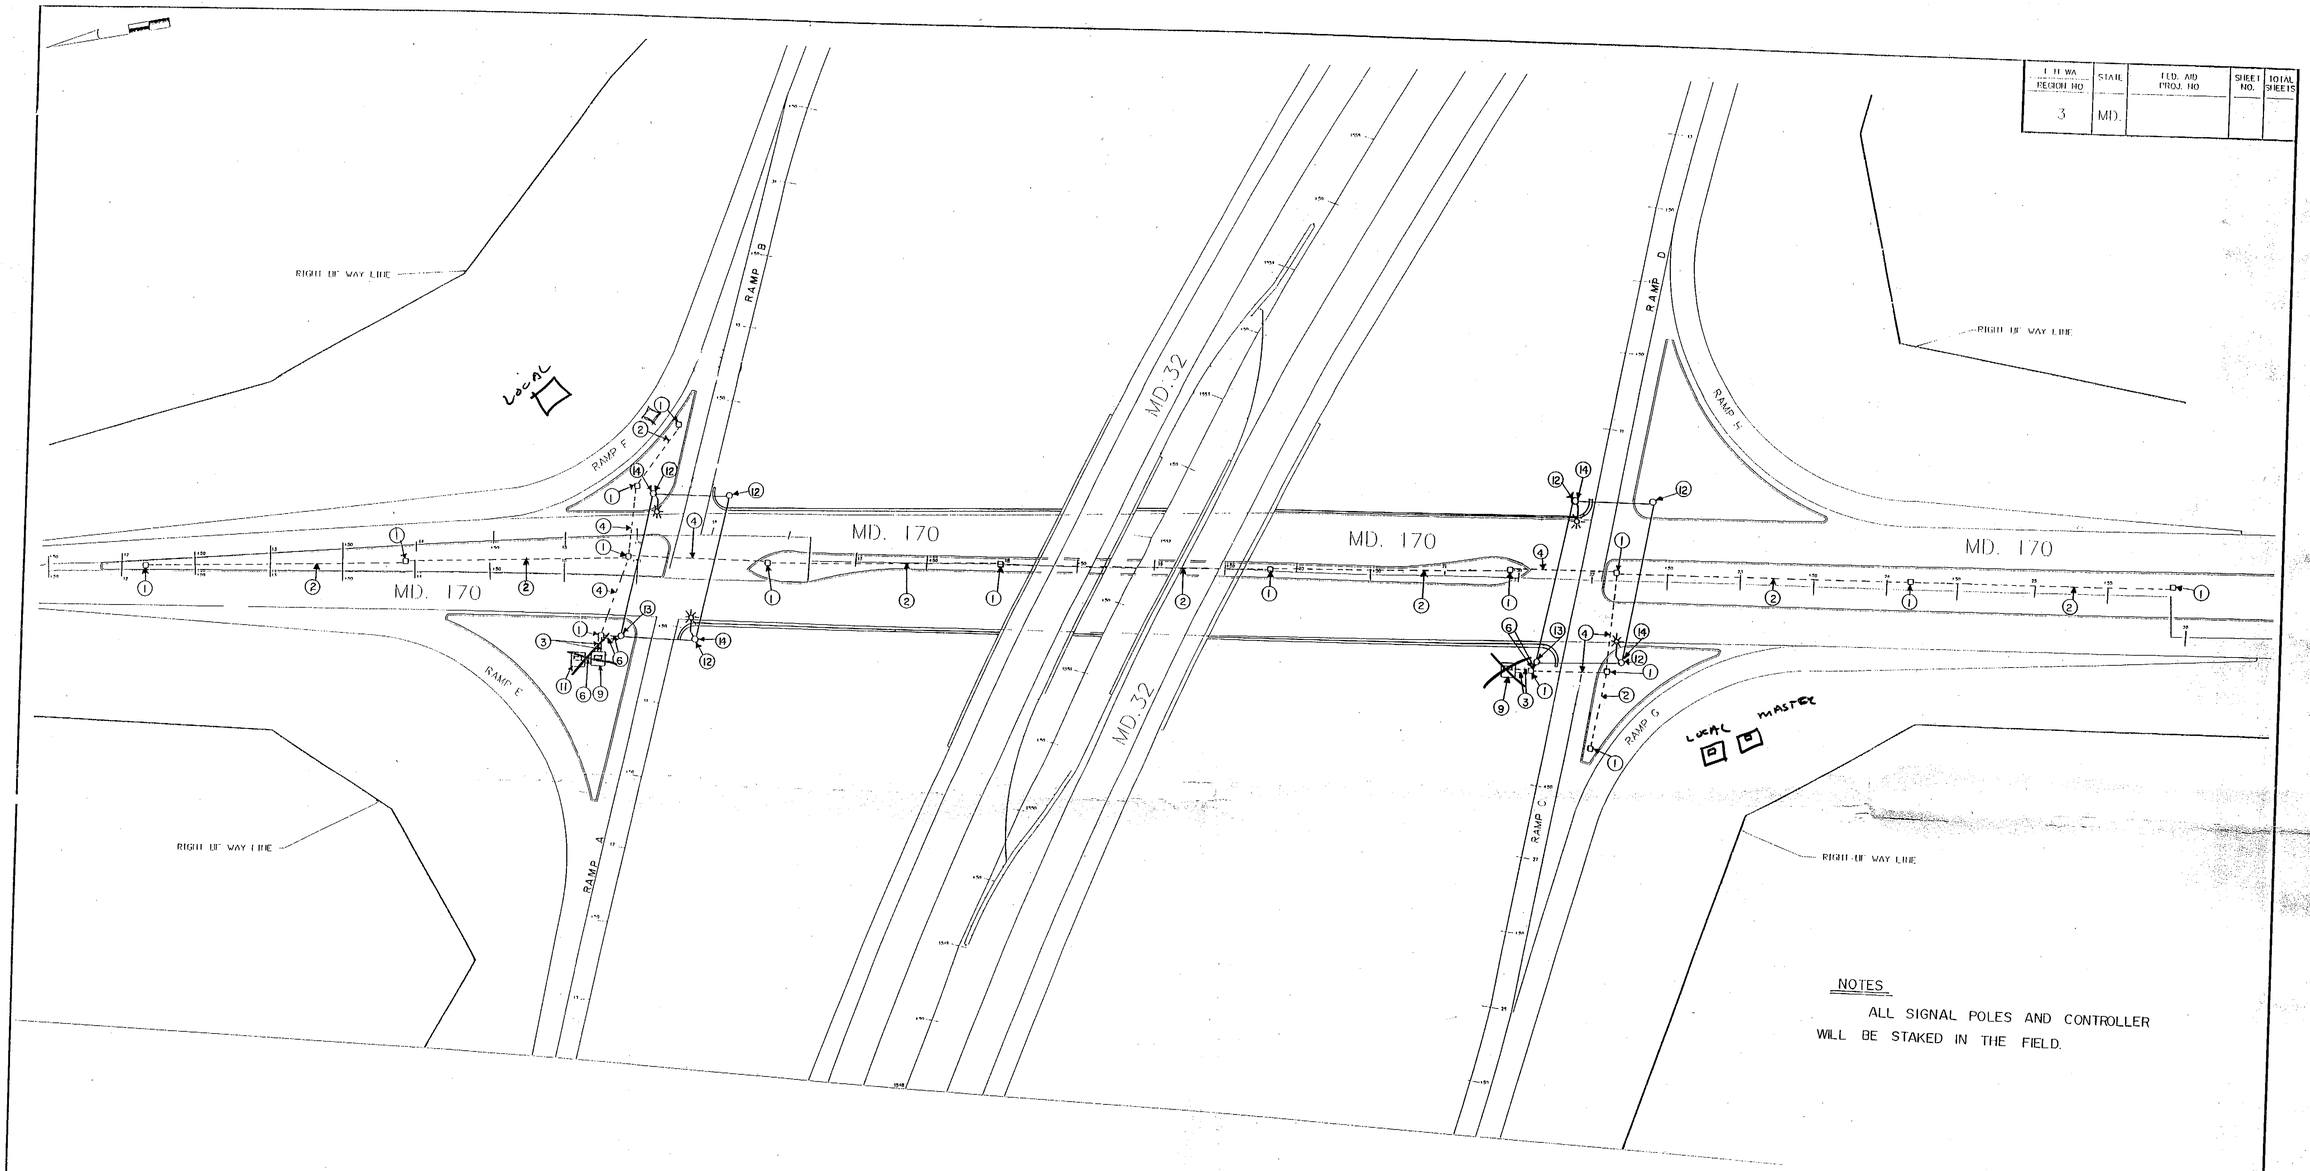

F.H.WA. REGION NO.	STATE	FED. AID PROJ. NO.	SHEET NO.	TOTAL SHEETS
3	MD.			

NOTES

ALL SIGNAL POLES AND CONTROLLER WILL BE STAKED IN THE FIELD.

REVISIONS	APPROVALS
	CHIEF, SIGNAL DESIGN SECTION
	ASST. DISTRICT ENGINEER, TRAFFIC
	CHIEF, TRAFFIC ENGINEERING DIVISION
	DEPUTY CHIEF ENGINEER, OFFICE OF TRAFFIC

MDOT – STATE HIGHWAY ADMINISTRATION

Office of Traffic & Safety

TRAFFIC ENGINEERING DESIGN DIVISION SIGNAL II

DRAWN BY: *W. MALCOLM*

DES. BY: *G. SIMMERS*

CHK. BY:

MD. RTE. 32 AT MD. 170 (RAMPS A&B)

MD. RTE. 32 AT MD. 170 (RAMPS C&D)

COUNTY: ANNE ARUNDEL

DATE: 02/92

SCALE: 1" = 50'

F.A.P. NO.

S.H.A. NO. AA-739-502-570

IS/SID. NO.

SHEET NO. 1 OF 1