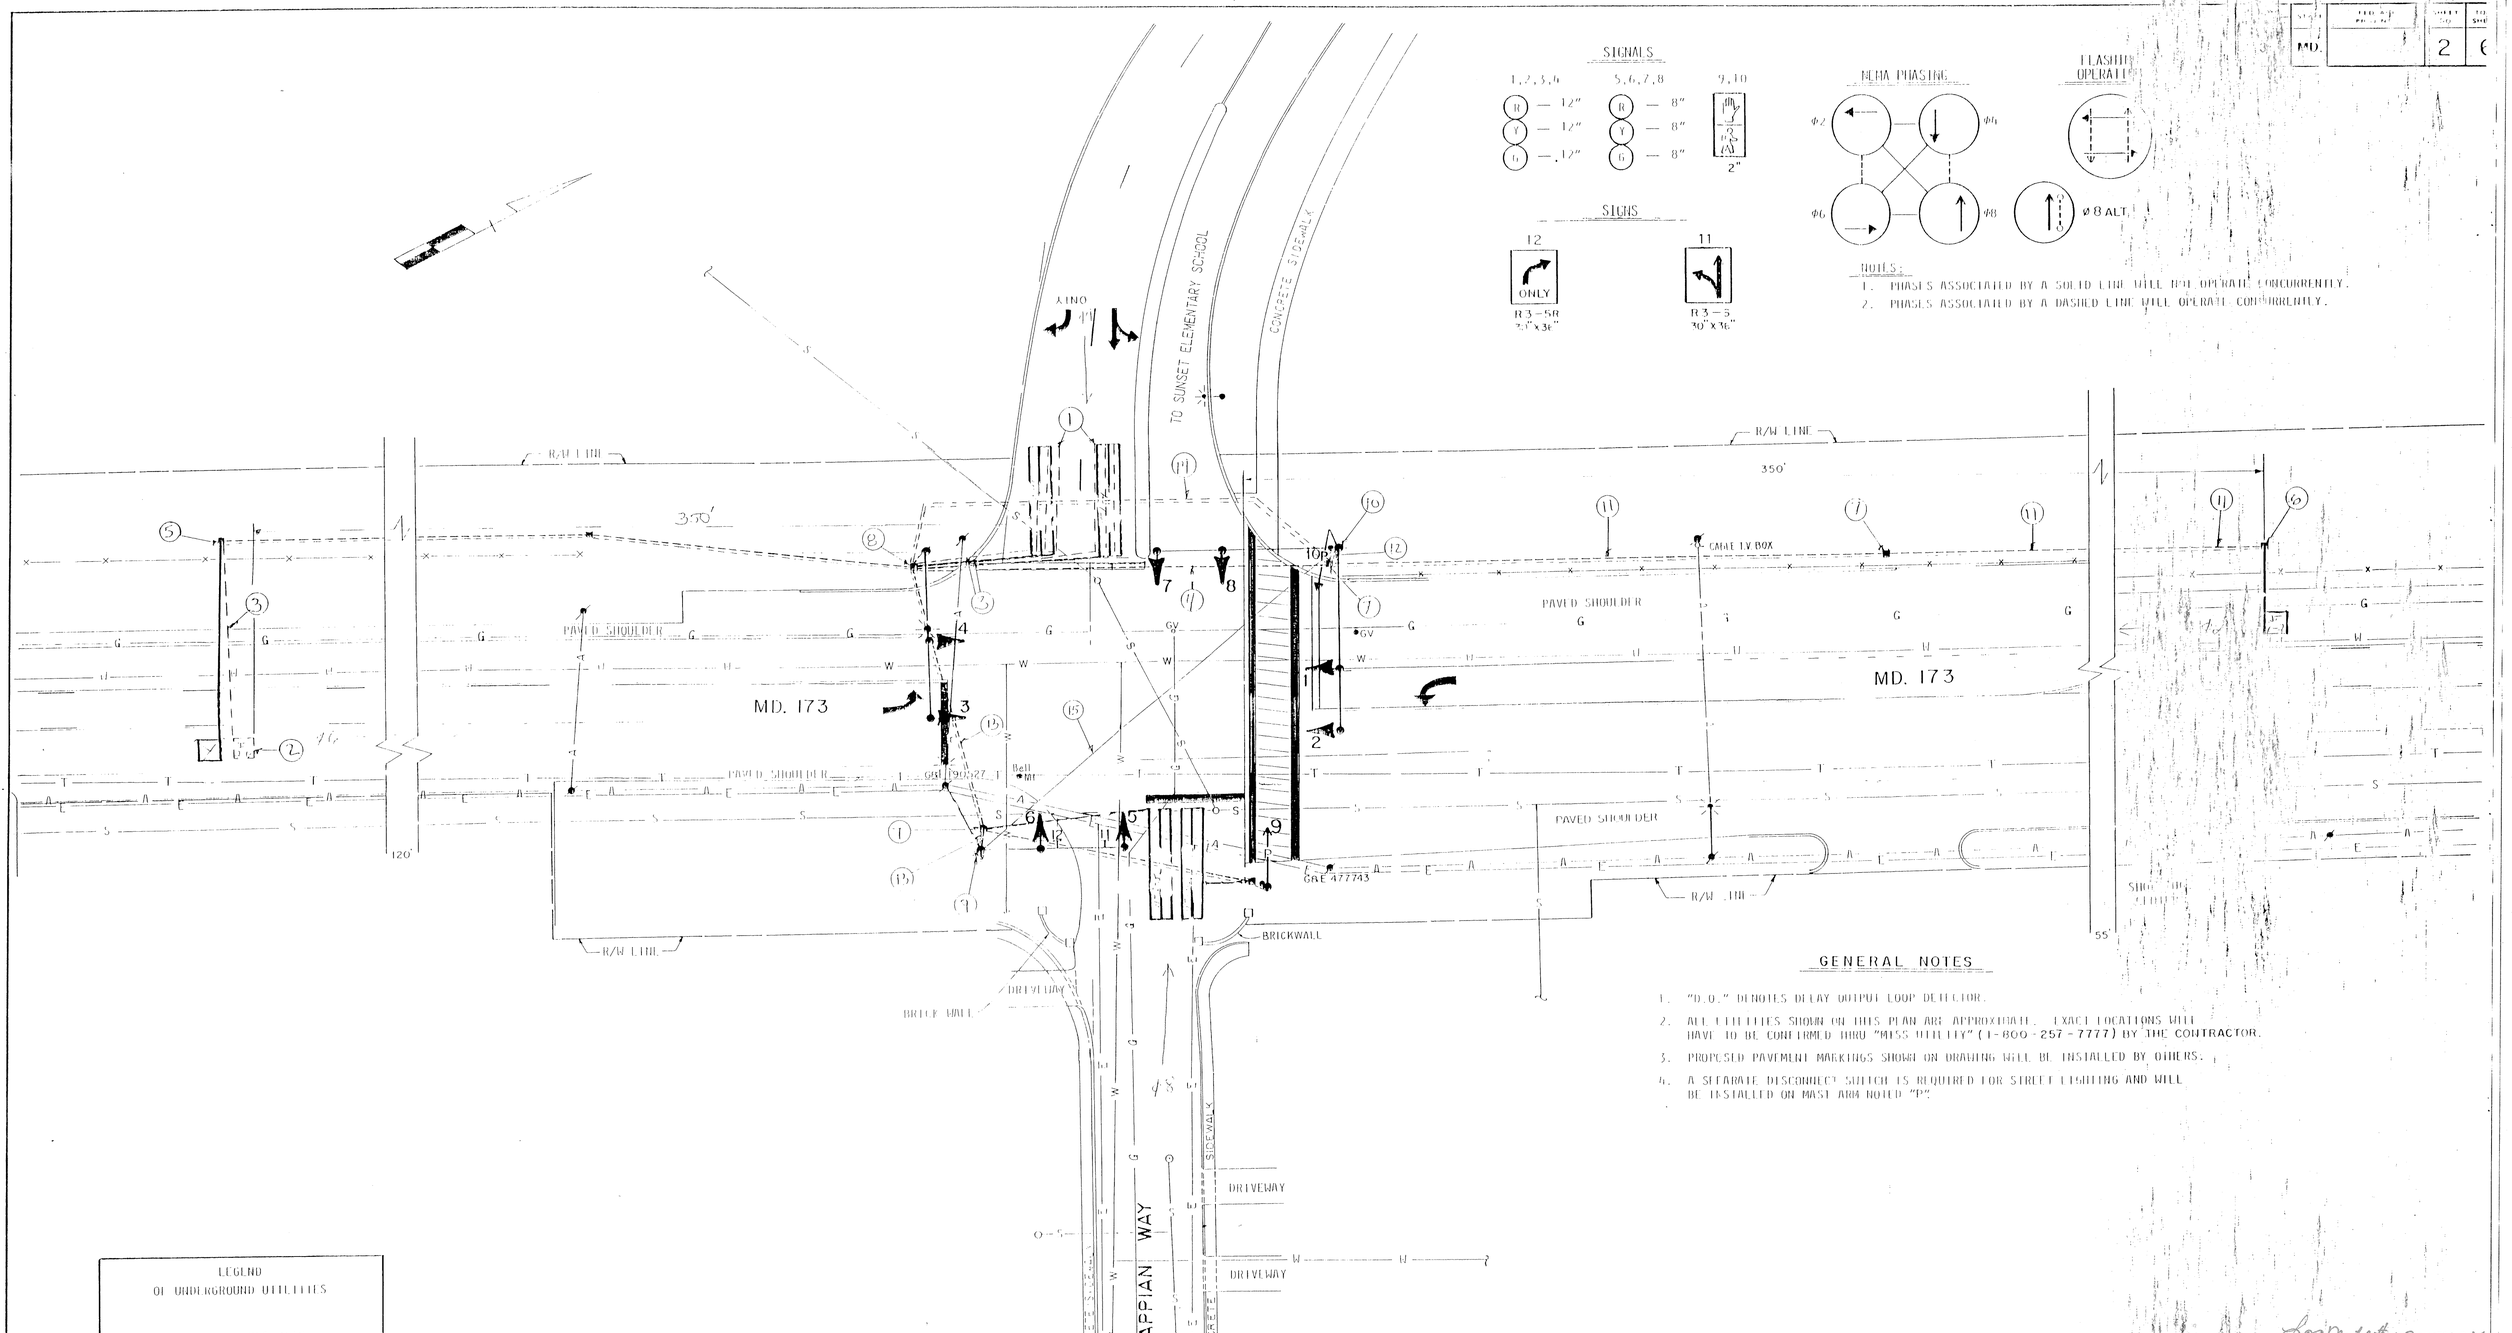
SIGNALS
1,2,3,4
R — 12"
Y — 12"
G — 12"
5,6,7,8
R — 8"
Y — 8"
G — 8"
9,10
2"
SIGNS
12
ONLY
R3-5R
30"x36"
11
R3-5
30"x36"
NEMA PHASING
Φ2
Φ4
Φ6
Φ8
Φ8 ALT.
FLASHING OPERATION
NOTES:
1. PHASES ASSOCIATED BY A SOLID LINE WILL NOT OPERATE CONCURRENTLY.
2. PHASES ASSOCIATED BY A DASHED LINE WILL OPERATE CONCURRENTLY.
MD. 173
2
6
TO SUNSET ELEMENTARY SCHOOL
CONCRETE SIDEWALK
R/W LINE
350'
PAVED SHOULDER
CABLE TV BOX
MD. 173
BRICKWALL
DRIVEWAY
BRICK WALL
APPIAN WAY
SIDEWALK
CONCRETE
GRE 477743
GRE 190327
Bell Atl
120'
55'
LEGEND
OF UNDERGROUND UTILITIES
GAS MAIN
WATER MAIN
SEWER MAIN
ELECTRIC CABLES
TELEPHONE CABLES
AERIAL CABLES
STORM DRAIN
GENERAL NOTES
1. "D.O." DENOTES DELAY OUTPUT LOOP DETECTOR.
2. ALL UTILITIES SHOWN ON THIS PLAN ARE APPROXIMATE. EXACT LOCATIONS WILL HAVE TO BE CONFIRMED THRU "MISS UTILITY" (1-800-257-7777) BY THE CONTRACTOR.
3. PROPOSED PAVEMENT MARKINGS SHOWN ON DRAWING WILL BE INSTALLED BY OTHERS.
4. A SEPARATE DISCONNECT SWITCH IS REQUIRED FOR STREET LIGHTING AND WILL BE INSTALLED ON MAST ARM NOTED "P".
PREPARED BY
CENTURY ENGINEERING, INC.
CONSULTING ENGINEERS & PLANNERS
TOWSON, MARYLAND 21204
REVISIONS
APPROVALS
CHIEF, SIGNAL DESIGN SECTION
ASST DISTRICT ENGINEER, TRAFFIC
CHIEF, BUREAU OF TRAFFIC ENGINEERING
MARYLAND DEPARTMENT OF TRANSPORTATION
STATE HIGHWAY ADMINISTRATION
BUREAU OF TRAFFIC ENGINEERING
MD. 173 AND APPIAN WAY
COUNTY: ANNE ARUNDEL
DES. BY: REBECCA PAGOS
CENTURY ENGINEERING, INC.
CHK. BY:
F.A.P. NO.
S.H.A. NO.
TS#22-17
SHEET NO.