F H WA REGION NO	STATE	FED. AID PROJ. NO	SHEET NO.	TOTAL SHEETS
3	MD.			

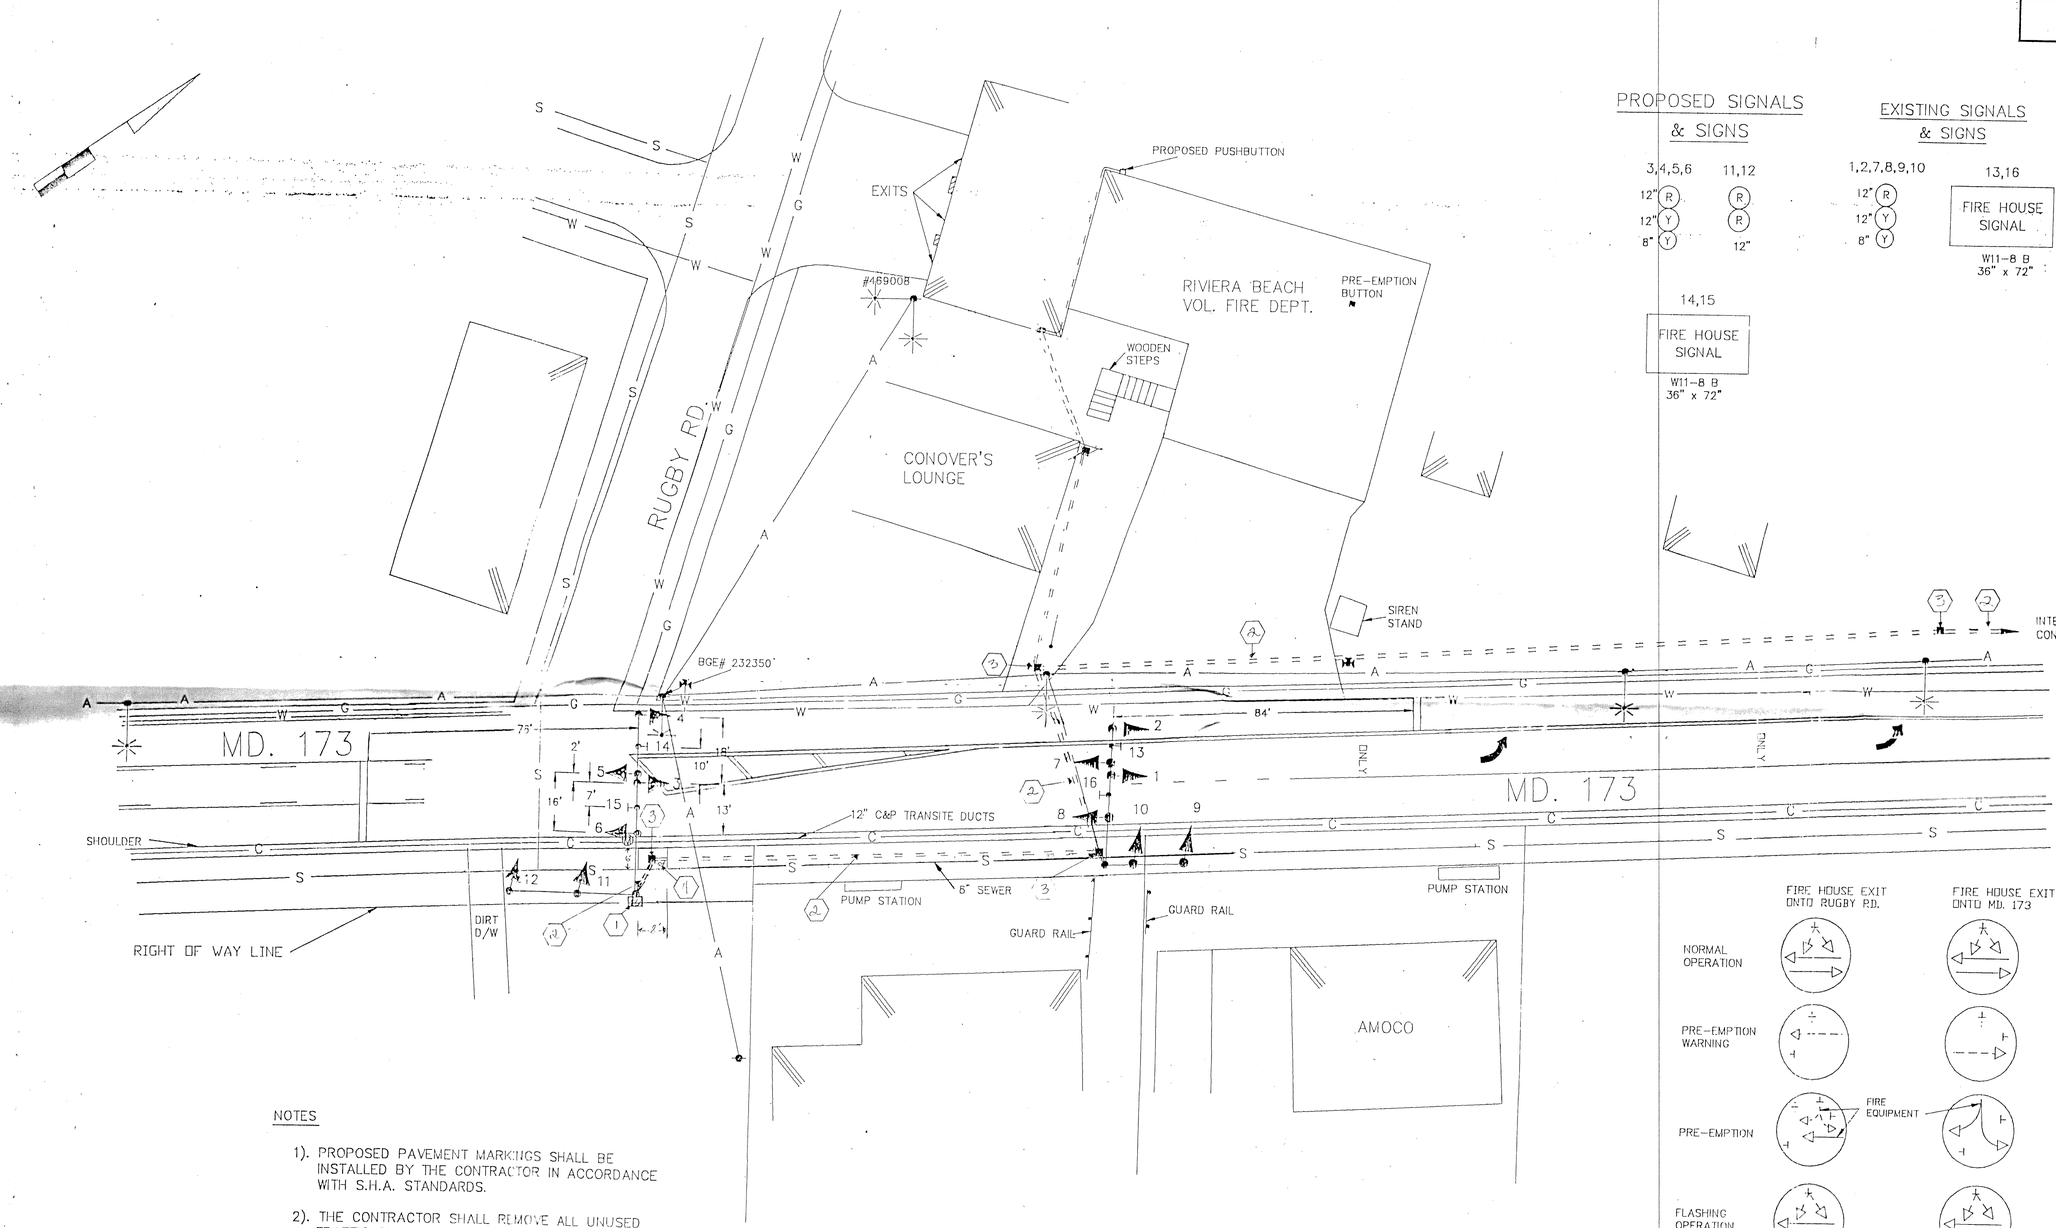

PROPOSED SIGNALS & SIGNS

3,4,5,6: 12" R, 12" Y, 8" Y

11,12: R, R, 12"

14,15: FIRE HOUSE SIGNAL — W11-8 B 36" x 72"

EXISTING SIGNALS & SIGNS

1,2,7,8,9,10: 12" R, 12" Y, 8" Y

13,16: FIRE HOUSE SIGNAL — W11-8 B 36" x 72"

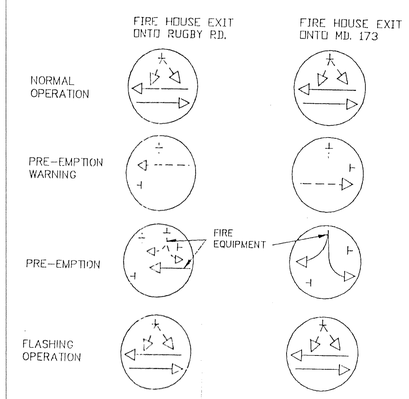

NOTES

1). PROPOSED PAVEMENT MARKINGS SHALL BE INSTALLED BY THE CONTRACTOR IN ACCORDANCE WITH S.H.A. STANDARDS.

2). THE CONTRACTOR SHALL REMOVE ALL UNUSED TRAFFIC SIGNAL ELECTRICAL CABLE FROM CONDUITS.

UTILITY LEGEND

G	G	GAS MAIN
W	W	WATER MAIN
S	S	SEWER MAIN
E	E	ELECTRIC CABLES
A	A	AERIAL CABLES
T	T	TELEPHONE CABLES

REVISIONS

(6) REPLACE DAMAGED PREEMPTION INTERCONNECT CABLE S.H.A. NO.: 859-02979 S.H.A. — M.B. 1/3/91

(5) REPLACE DAMAGED PUSHBUTTON S.H.A. NO.: 859-05032139 — M.B. 12/7/90

APPROVALS

CHIEF, SIGNAL DESIGN SECTION — 2/5/91

ASST. DISTRICT ENGINEER, TRAFFIC

CHIEF, TRAFFIC ENGINEERING DIVISION — 2/5/91

DEPUTY CHIEF ENGINEER, OFFICE OF TRAFFIC — 2/7/91

MDOT – STATE HIGHWAY ADMINISTRATION
Office of Traffic
TRAFFIC ENGINEERING DIVISION

SIGNAL # 02017305.09

DRAWN BY: D. DISTANCE
DES. BY: D. DISTANCE
CHK. BY: 2-5-91

MD. 173 (FORT SMALLWOOD RD.) @ RUGBY RD.

COUNTY: ANNE ARUNDEL

DATE: 2/91
SCALE: 1"=20'
F.A.P. NO.
S.H.A. NO

TS/STD. NO. 3063

SHEET NO. ___ OF ___