T.I.R.W.A. REGION NO.	STATE	FED. AID PROJ. NO.	SHEET NO.	TOTAL SHEETS
3	MD.		2	5

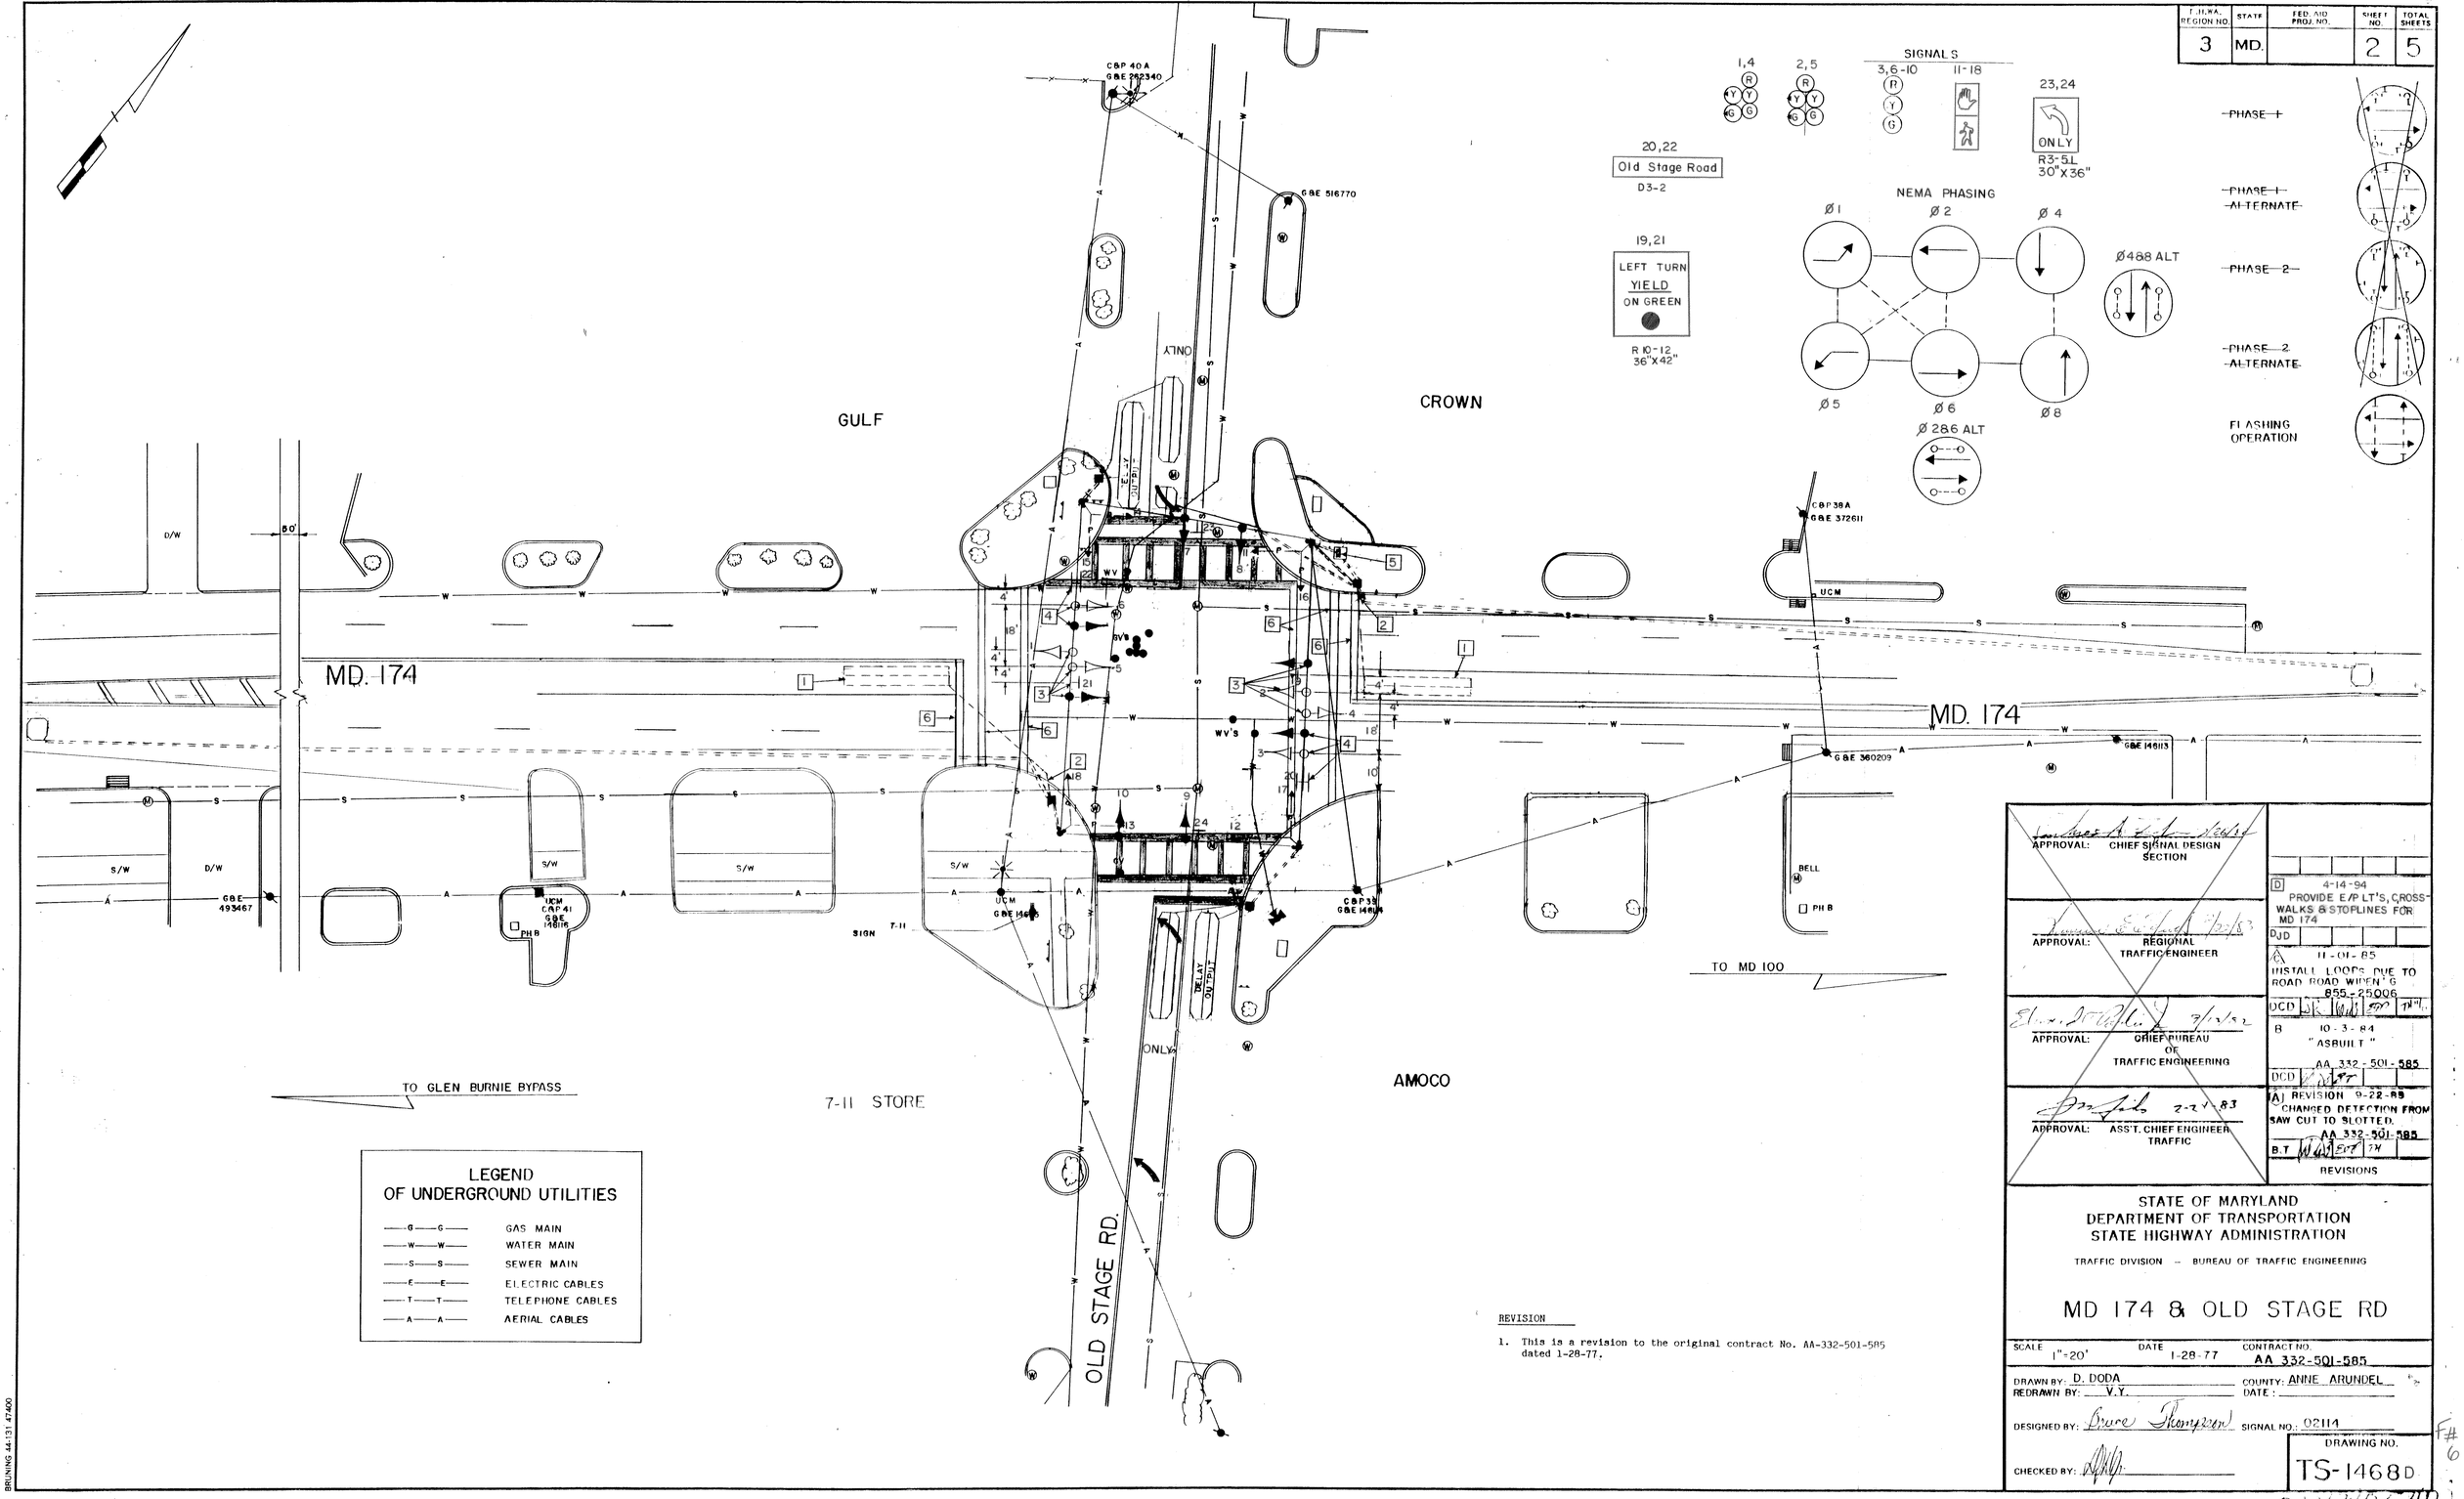

LEGEND OF UNDERGROUND UTILITIES

—G—G—	GAS MAIN
—W—W—	WATER MAIN
—S—S—	SEWER MAIN
—E—E—	ELECTRIC CABLES
—T—T—	TELEPHONE CABLES
—A—A—	AERIAL CABLES

REVISION

1. This is a revision to the original contract No. AA-332-501-585 dated 1-28-77.

APPROVAL: CHIEF SIGNAL DESIGN SECTION

APPROVAL: REGIONAL TRAFFIC ENGINEER 7-2-83

APPROVAL: CHIEF BUREAU OF TRAFFIC ENGINEERING 7/2/82

APPROVAL: ASS'T. CHIEF ENGINEER TRAFFIC 7-27-83

D 4-14-94 PROVIDE E/P LT'S, CROSSWALKS & STOPLINES FOR MD 174 DJD

A 11-01-85 INSTALL LOOPS DUE TO ROAD ROAD WIDEN'G 855-25006 DCD

B 10-3-84 "ASBUILT" AA 332-501-585 DCD

A REVISION 9-22-83 CHANGED DETECTION FROM SAW CUT TO SLOTTED. AA 332-501-585 B.T.

REVISIONS

STATE OF MARYLAND
DEPARTMENT OF TRANSPORTATION
STATE HIGHWAY ADMINISTRATION

TRAFFIC DIVISION — BUREAU OF TRAFFIC ENGINEERING

MD 174 & OLD STAGE RD

SCALE	DATE	CONTRACT NO.
1"=20'	1-28-77	AA 332-501-585

DRAWN BY: D. DODA
REDRAWN BY: V.Y.
COUNTY: ANNE ARUNDEL
DATE:
DESIGNED BY: Bruce Thompson
SIGNAL NO.: 02114
CHECKED BY:

DRAWING NO. TS-1468D

F#6

02017405.40

BRUNING 44-131 47400