F.H.W.A. REGION NO.	STATE	FED. AID PROJ. NO.	SHEET NO.	TOTAL SHEETS
3	MD.			

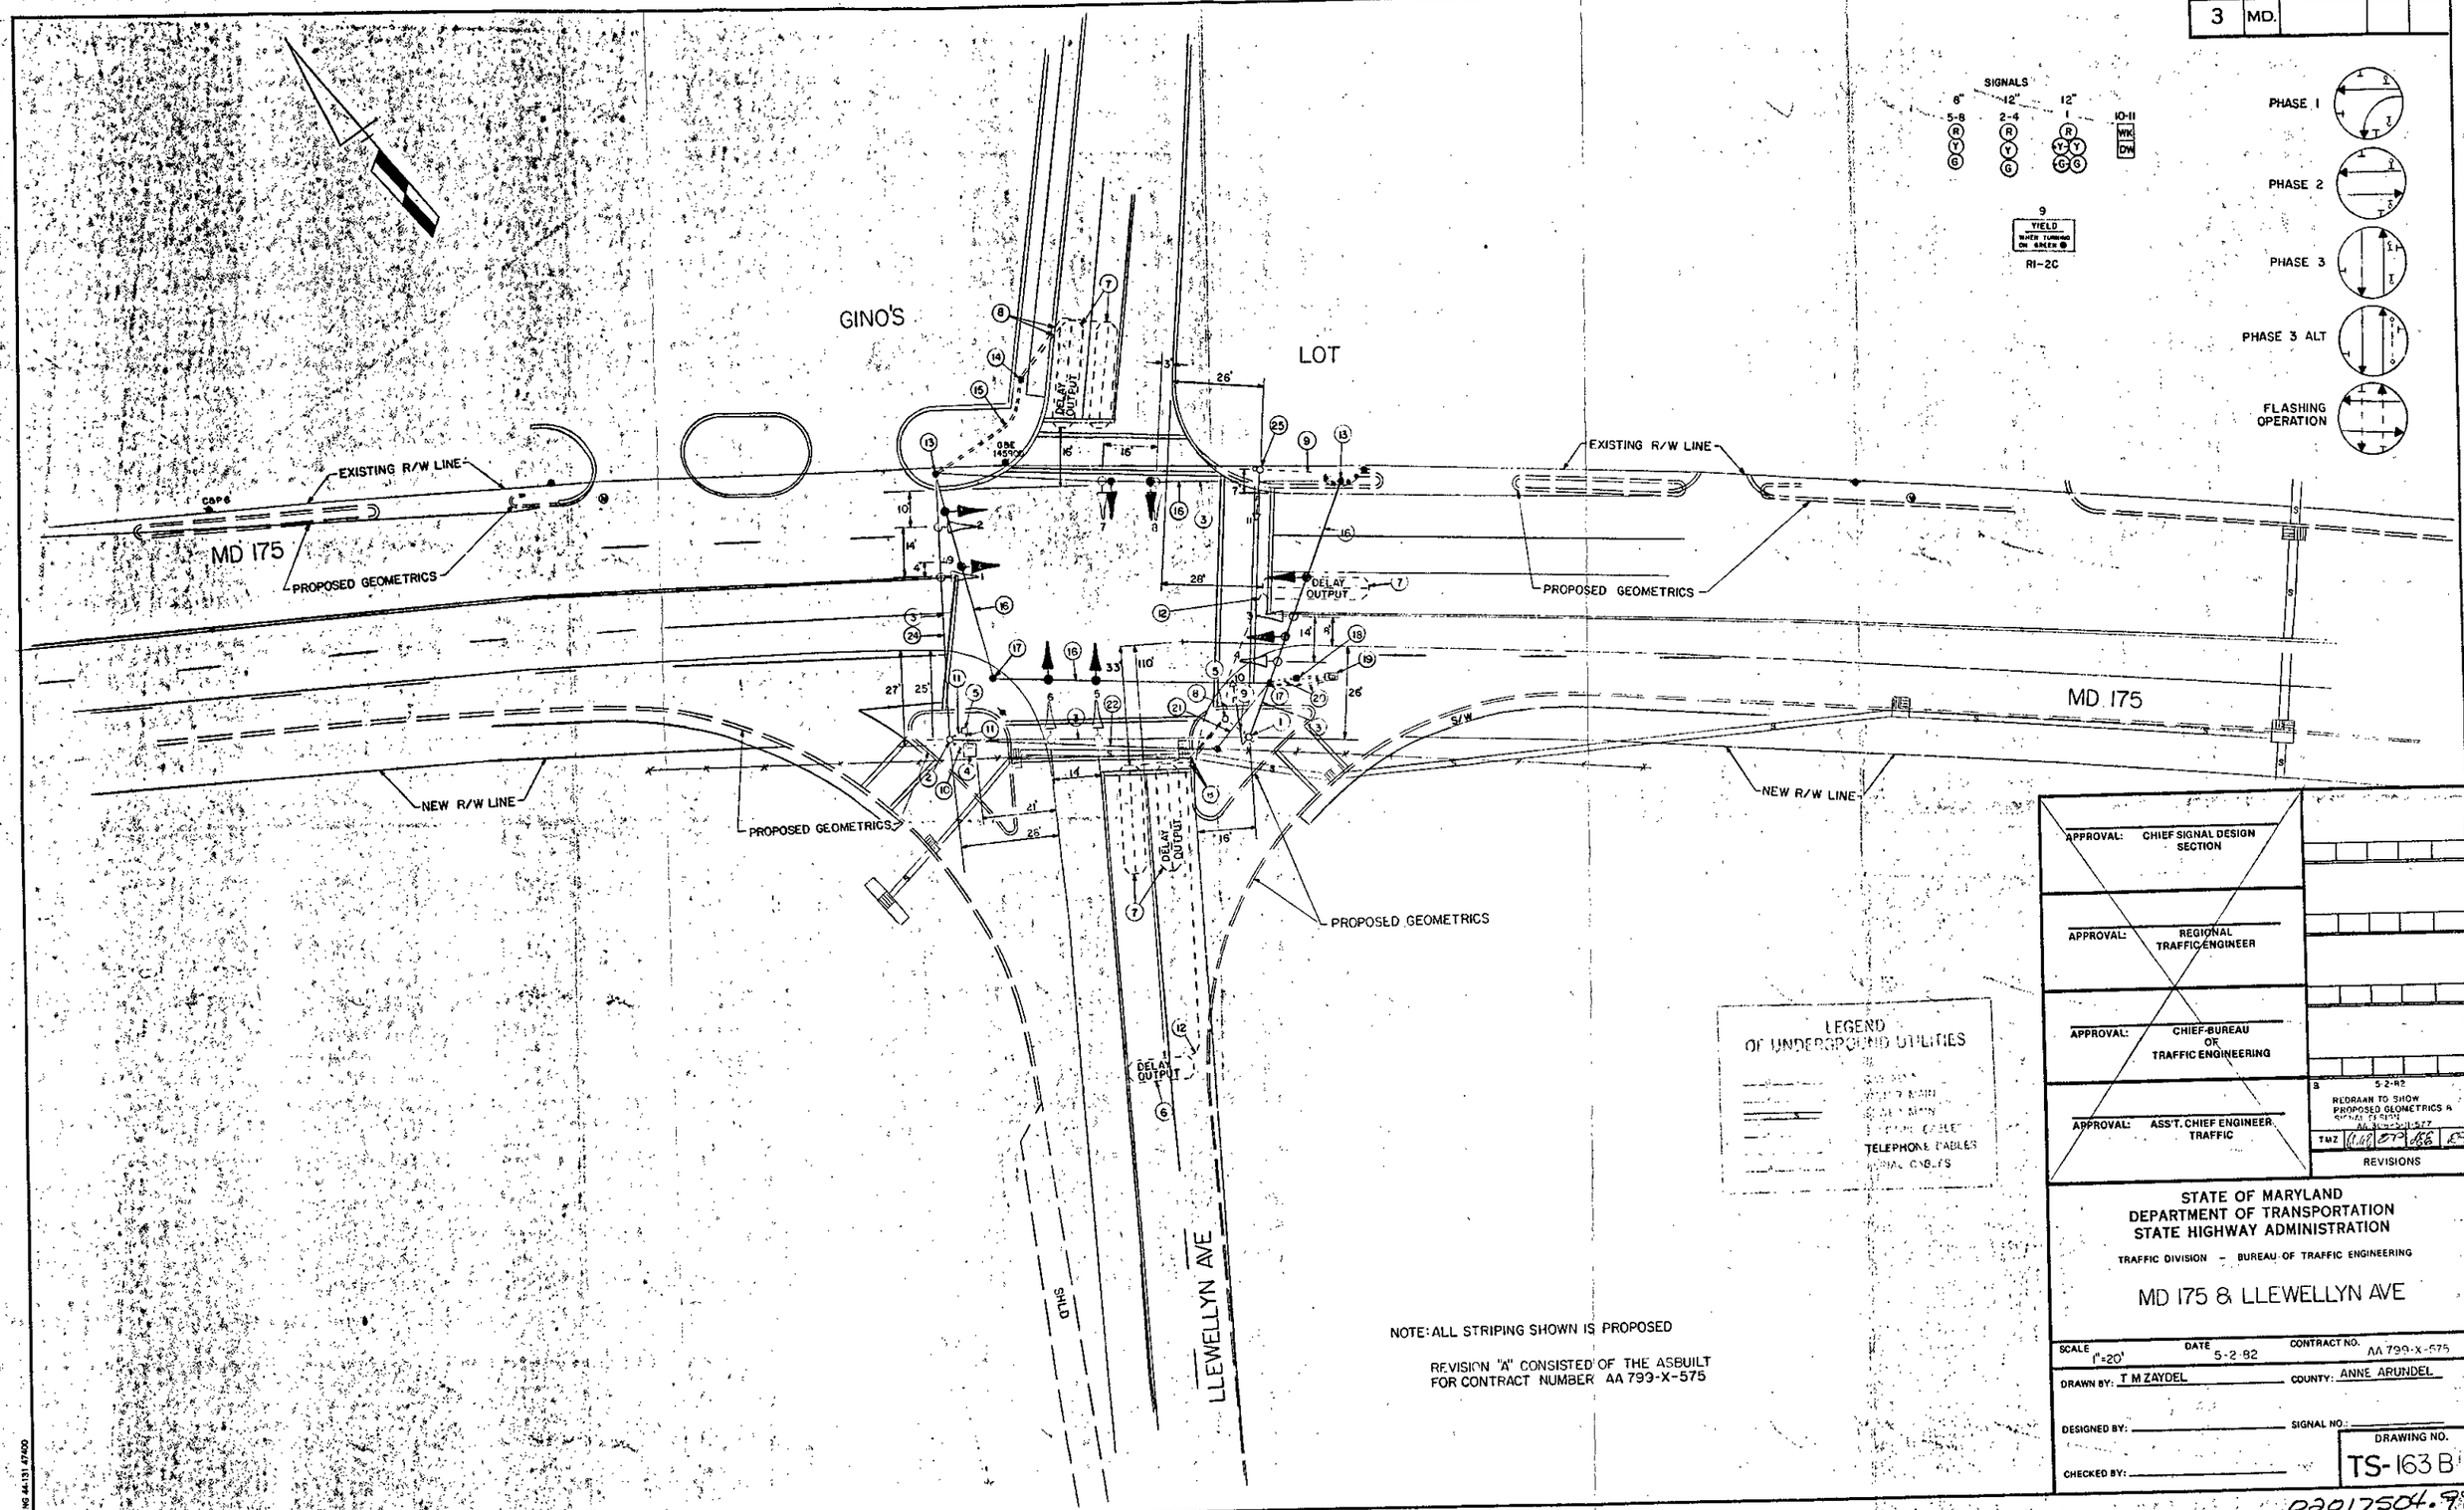

NOTE: ALL STRIPING SHOWN IS PROPOSED

REVISION "A" CONSISTED OF THE ASBUILT FOR CONTRACT NUMBER AA 799-X-575

APPROVAL: CHIEF SIGNAL DESIGN SECTION

APPROVAL: REGIONAL TRAFFIC ENGINEER

APPROVAL: CHIEF BUREAU OF TRAFFIC ENGINEERING

APPROVAL: ASS'T. CHIEF ENGINEER TRAFFIC

A	5-2-82	REDRAWN TO SHOW PROPOSED GEOMETRICS & SIGNAL REVISION AA 799-X-575	TMZ	

REVISIONS

STATE OF MARYLAND
DEPARTMENT OF TRANSPORTATION
STATE HIGHWAY ADMINISTRATION

TRAFFIC DIVISION – BUREAU OF TRAFFIC ENGINEERING

MD 175 & LLEWELLYN AVE

SCALE 1"=20' | DATE 5-2-82 | CONTRACT NO. AA 799-X-575

DRAWN BY: T M ZAYDEL | COUNTY: ANNE ARUNDEL

DESIGNED BY: | SIGNAL NO.:

CHECKED BY:

DRAWING NO. TS-163 B

02017504.98

BRUNING 44-131 47400