F.H.W.A. REGION NO.	STATE	FED. AID PROJ. NO.	SHEET NO.	TOTAL SHEETS
3	MD.			

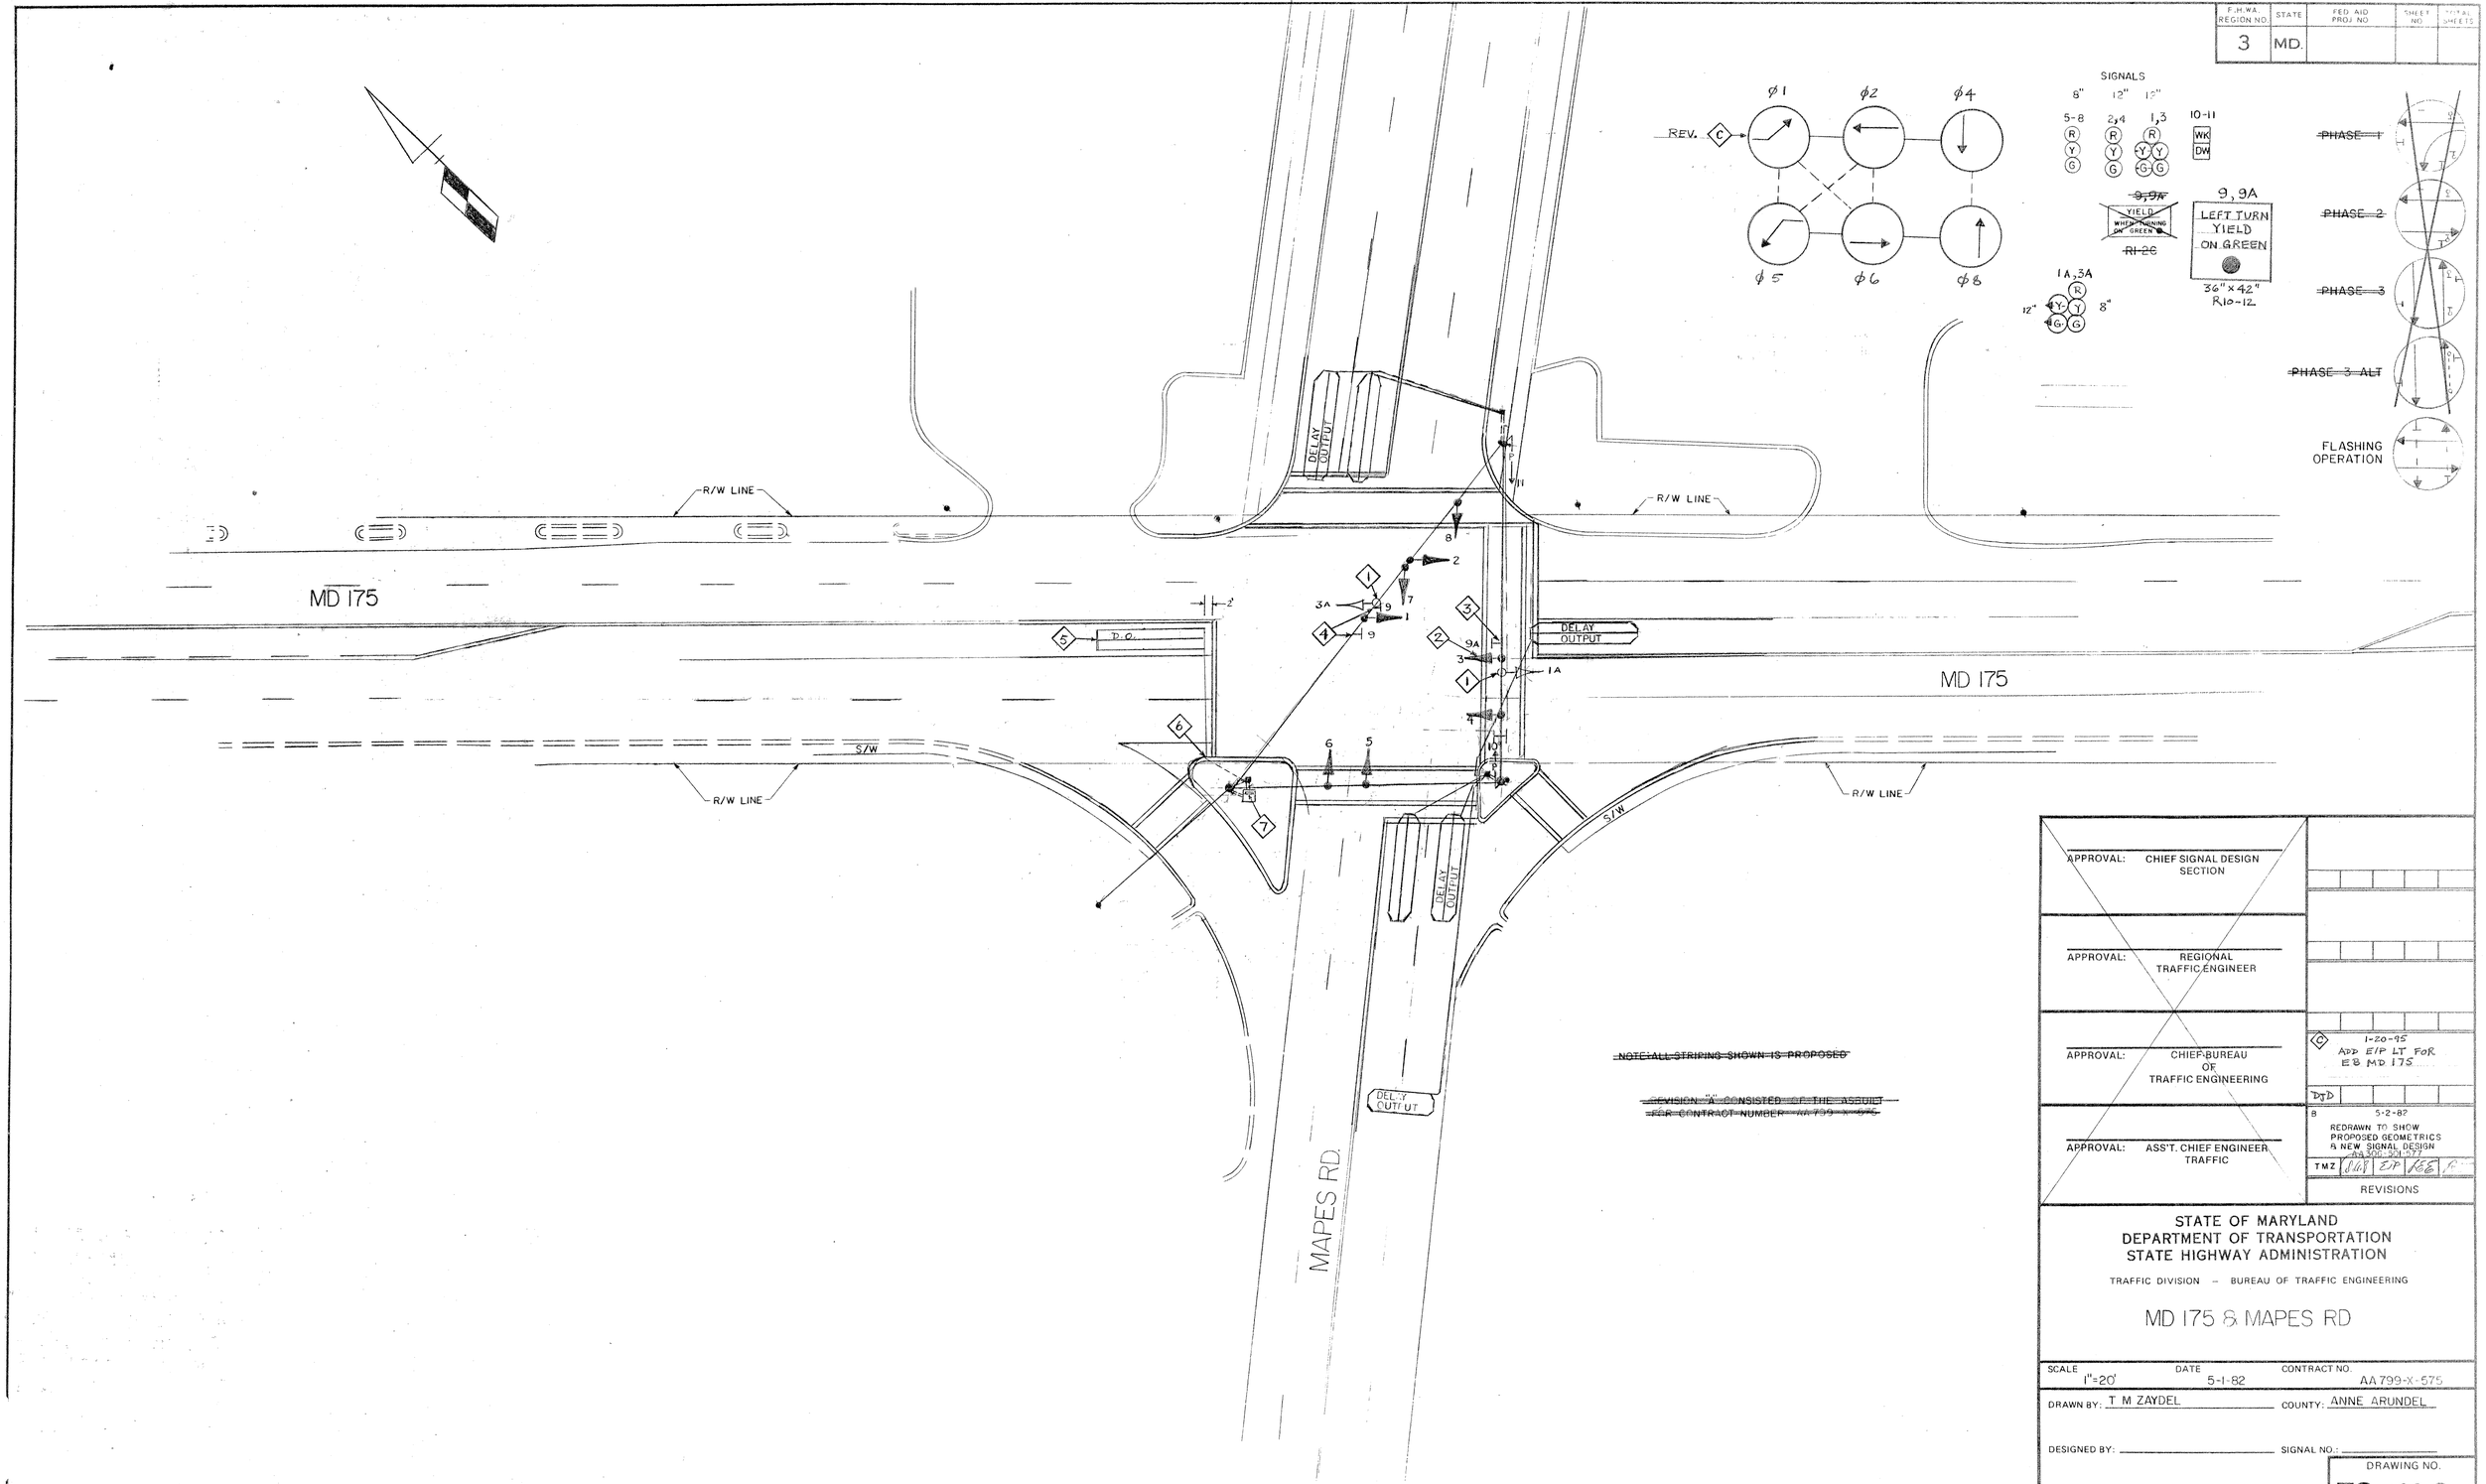

APPROVAL: CHIEF SIGNAL DESIGN SECTION

APPROVAL: REGIONAL TRAFFIC ENGINEER

APPROVAL: CHIEF, BUREAU OF TRAFFIC ENGINEERING

APPROVAL: ASS'T. CHIEF ENGINEER TRAFFIC

C 1-20-95 ADD E/P LT FOR EB MD 175 DJD

B 5-2-82 REDRAWN TO SHOW PROPOSED GEOMETRICS & NEW SIGNAL DESIGN AA 300-201-577 TMZ

REVISIONS

STATE OF MARYLAND
DEPARTMENT OF TRANSPORTATION
STATE HIGHWAY ADMINISTRATION

TRAFFIC DIVISION – BUREAU OF TRAFFIC ENGINEERING

MD 175 & MAPES RD

SCALE	DATE	CONTRACT NO.
1"=20'	5-1-82	AA 799-X-575

DRAWN BY: T M ZAYDEL COUNTY: ANNE ARUNDEL

DESIGNED BY: SIGNAL NO.:

CHECKED BY:

DRAWING NO. TS-162 C

02017505-32