F.H.W.A. REGION NO.	STATE	FED. AID PROJ. NO.	SHEET NO.	TOTAL SHEETS
3	MD.		2	5

NOTE

FOR LOCATION OF PUSH BUTTON, CONTACT CHIEF EARL SHIPLEY - PHONE NUMBER 799-1314

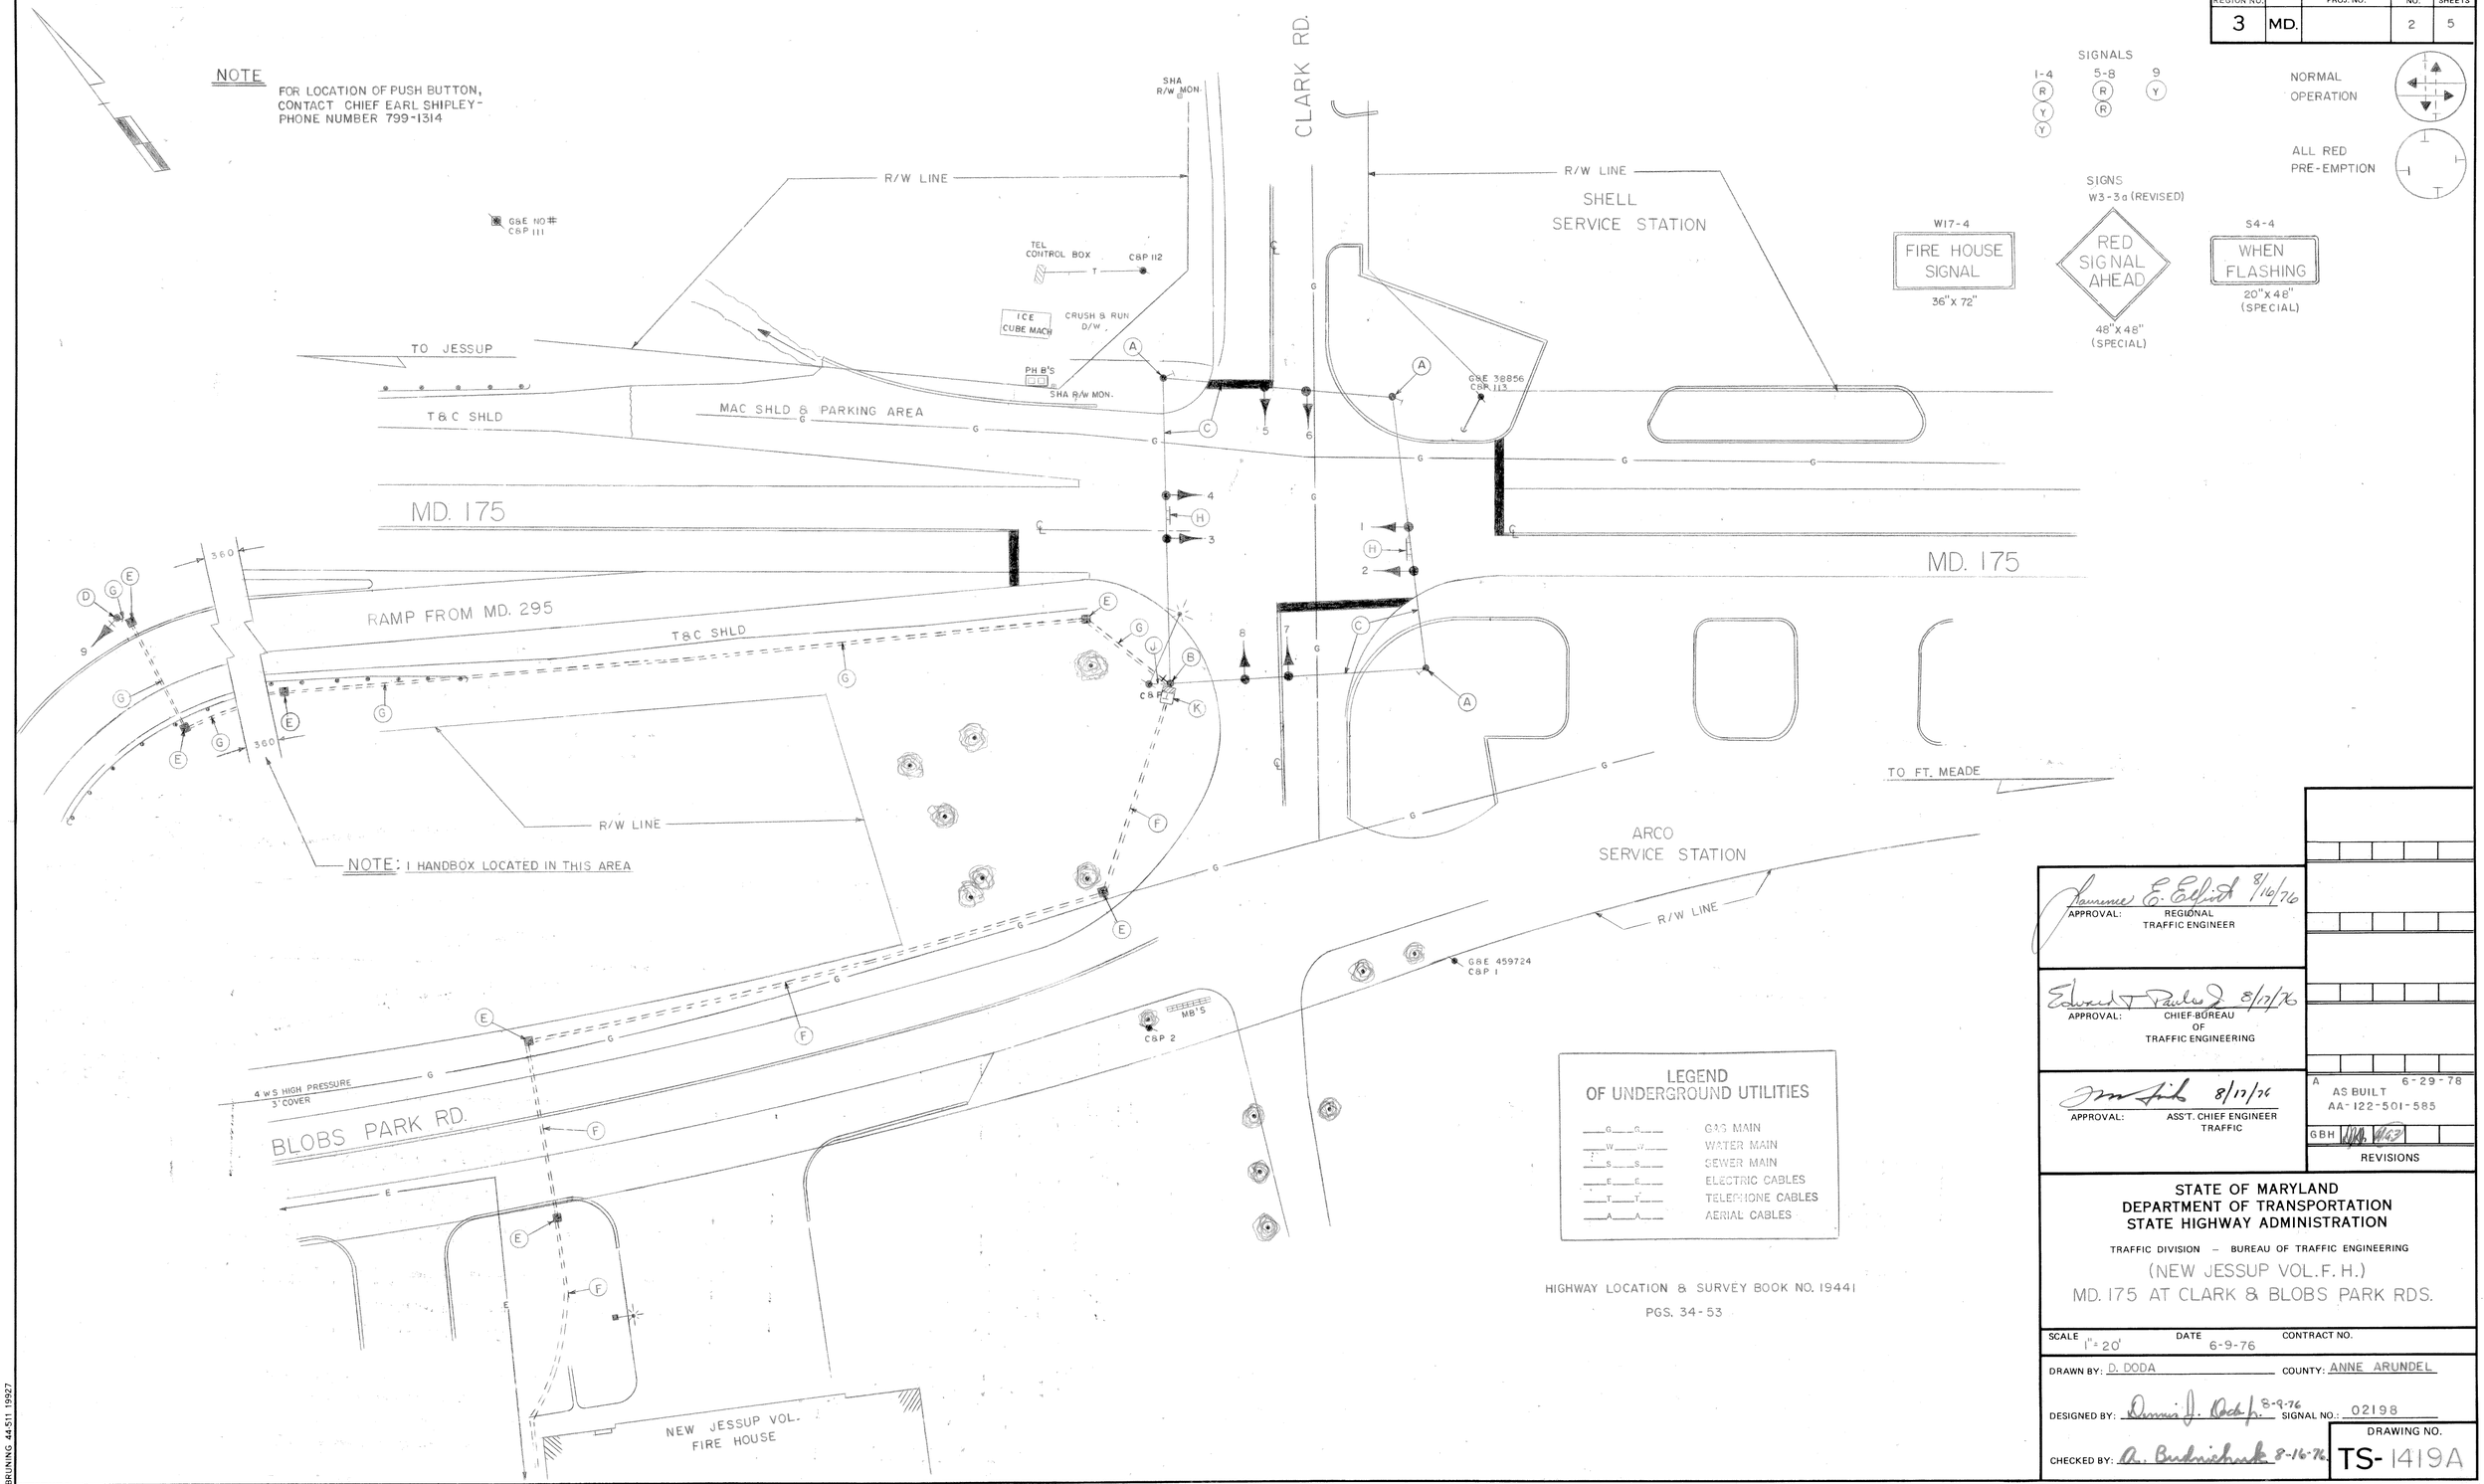

APPROVAL: REGIONAL TRAFFIC ENGINEER — 8/16/76

APPROVAL: CHIEF BUREAU OF TRAFFIC ENGINEERING — 8/17/76

APPROVAL: ASS'T. CHIEF ENGINEER TRAFFIC — 8/17/76

A AS BUILT 6-29-78 AA-122-501-585

GBH

REVISIONS

STATE OF MARYLAND
DEPARTMENT OF TRANSPORTATION
STATE HIGHWAY ADMINISTRATION

TRAFFIC DIVISION – BUREAU OF TRAFFIC ENGINEERING

(NEW JESSUP VOL. F. H.)

MD. 175 AT CLARK & BLOBS PARK RDS.

SCALE 1" = 20' | DATE 6-9-76 | CONTRACT NO.

DRAWN BY: D. DODA | COUNTY: ANNE ARUNDEL

DESIGNED BY: 8-9-76 | SIGNAL NO.: 02198

CHECKED BY: 8-16-76

DRAWING NO. TS-1419A

BRUNING 44511 19927