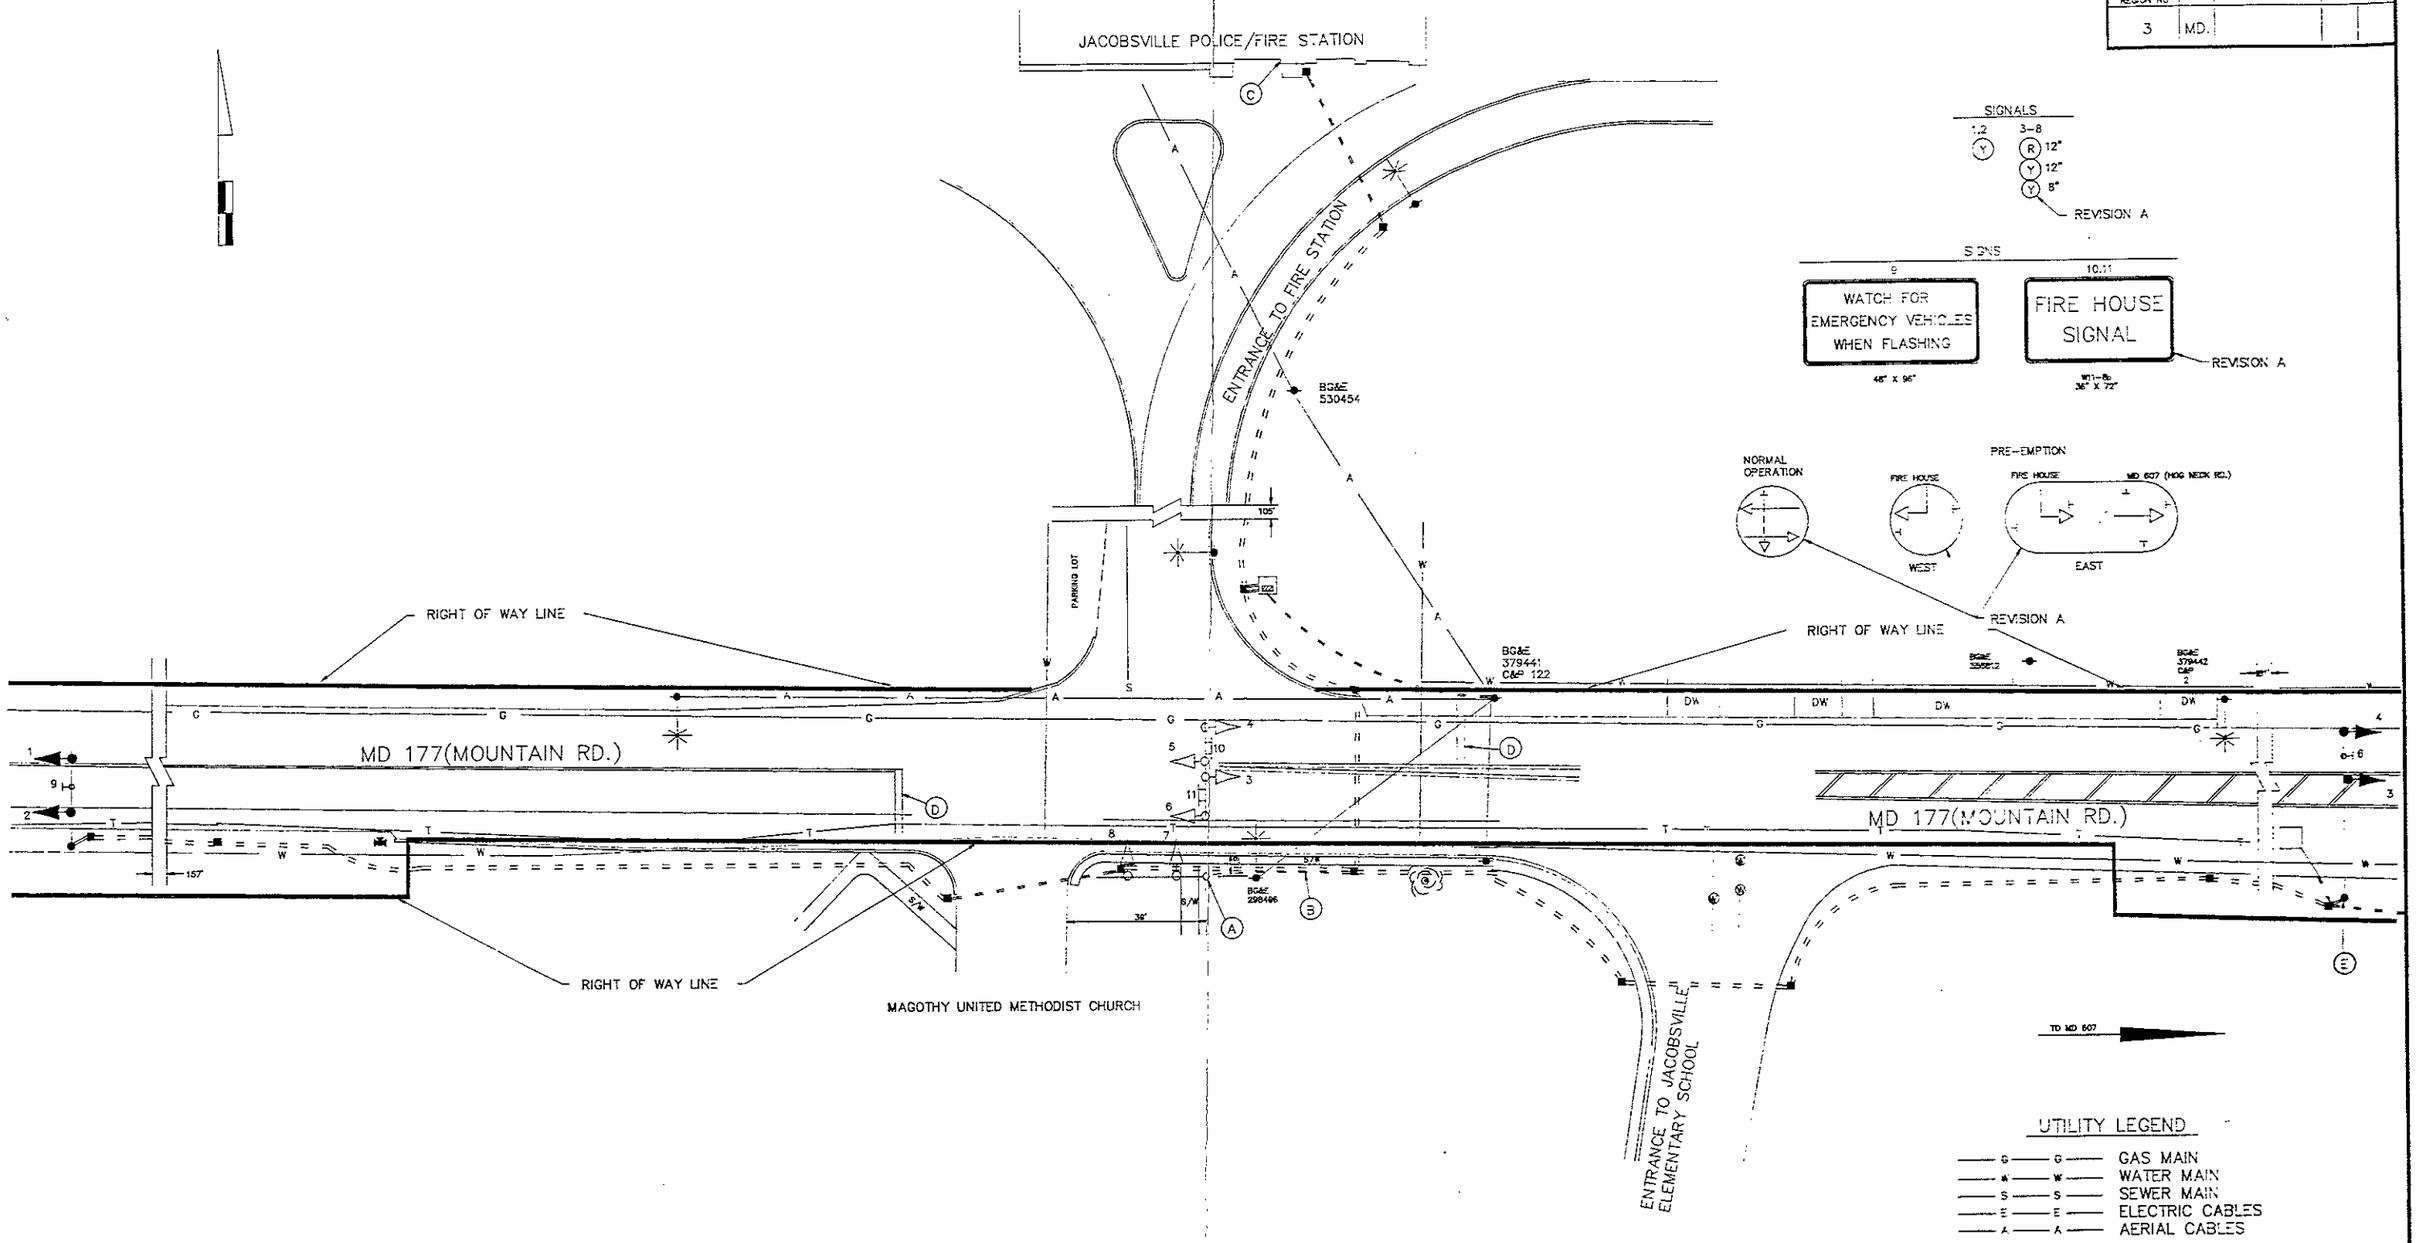

REVISIONS	APPROVALS
Ⓐ ASBUILT 11/90 INSTALL FIRE HOUSE SIGNAL AND I/C PRE-EMPTION WITH MD 607.	CHIEF, SIGNAL DESIGN SECTION ASST. DISTRICT ENGINEER, TRAFFIC CHIEF, TRAFFIC ENGINEERING DIVISION DEPUTY CHIEF ENGINEER, OFFICE OF TRAFFIC

THIS IS A REVISION TO S.H.A. NO. BW-170-501-512 COMPLETED 4-7-88 THE ORIGINAL IS IN FILE

MARYLAND DEPARTMENT OF TRANSPORTATION
STATE HIGHWAY ADMINISTRATION – OFFICE OF TRAFFIC
TRAFFIC ENGINEERING DIVISION

REDRAWN 10-31-90
DRAWN BY D. DICKERSON/B. THOMPSON
DES. BY: R.R. ZACHERL(STS)
CHK. BY: D. DODA 8-1-88

MD 177 and JACOBSVILLE FIRE STATION

SIGNAL NO. 02017704.17
COUNTY: ANNE ARUNDEL

DATE: 3-1-88
SCALE: 1"=20'
F.A.P. NO.
S.H.A. NO.
TS/FILE NO. 2470 A
SHEET NO. ___ OF ___

02017704.02