
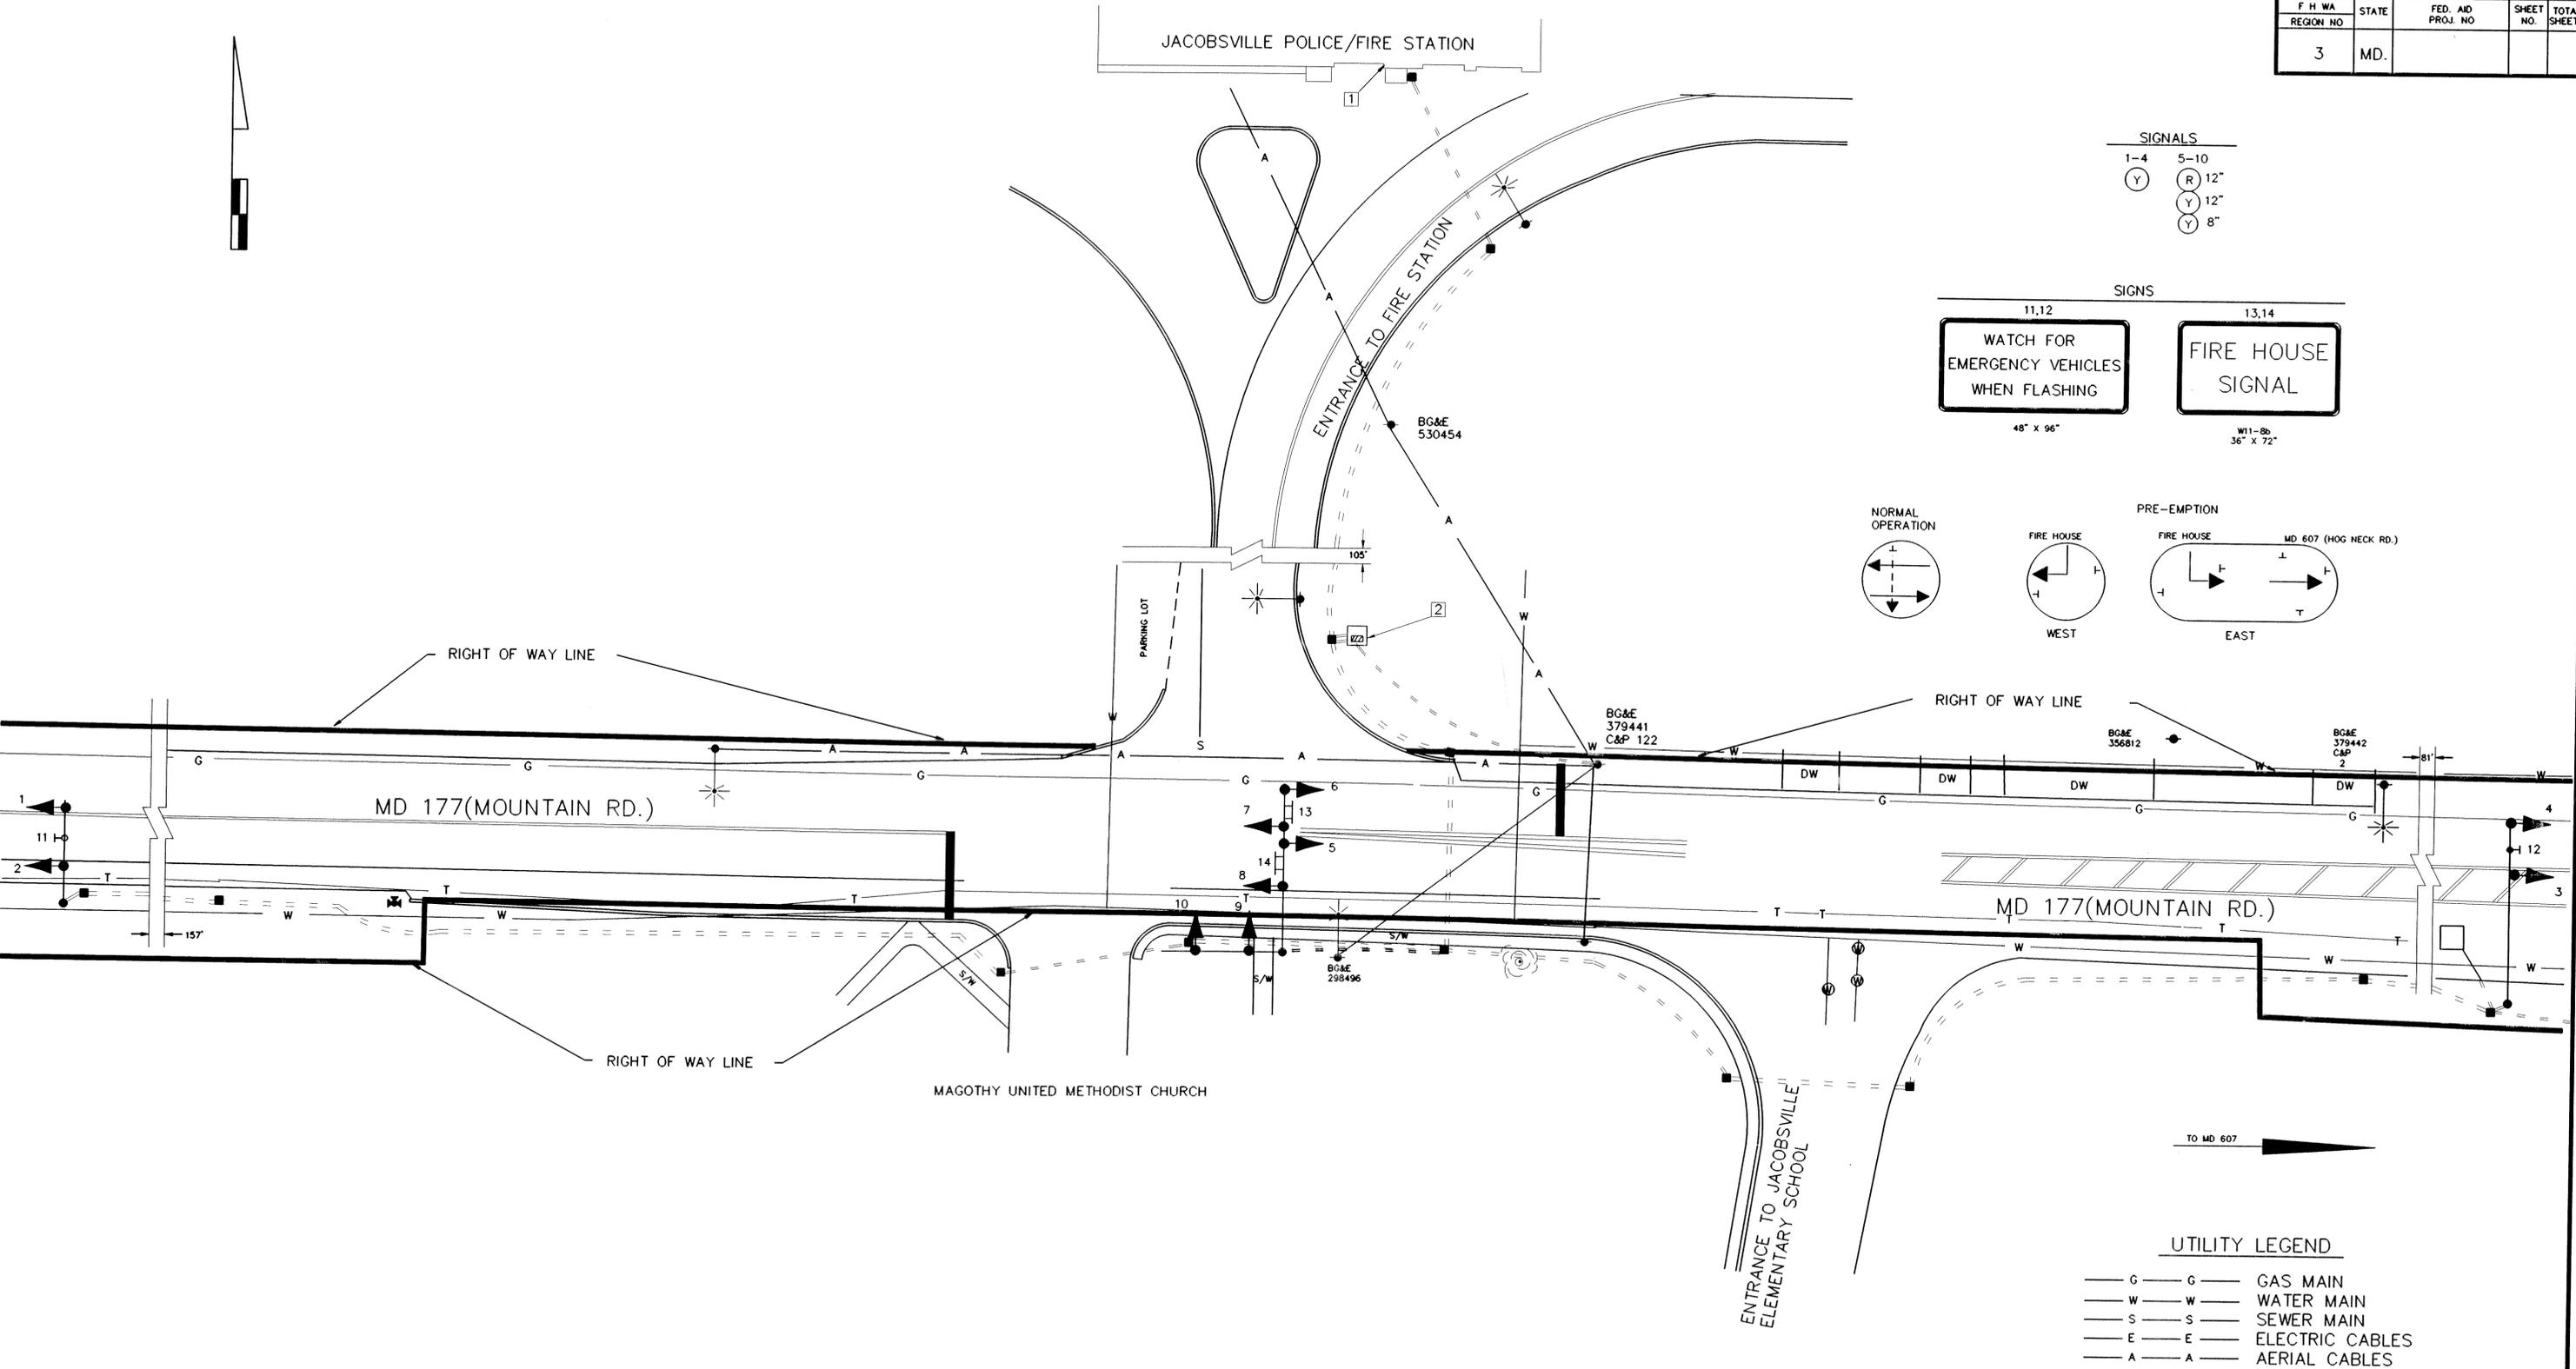
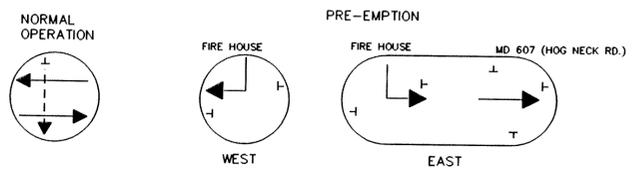
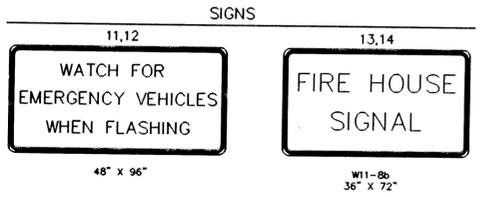


F. H. WA. REGION NO.	STATE	FED. AID PROJ. NO.	SHEET NO.	TOTAL SHEETS
3	MD.			

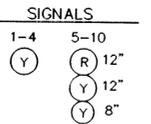

UTILITY LEGEND

— G —	GAS MAIN
— W —	WATER MAIN
— S —	SEWER MAIN
— E —	ELECTRIC CABLES
— A —	AERIAL CABLES

<p>REVISIONS</p> <p>10-1-92 (25-01124) INSTALL ADDITIONAL PUSHBUTTONS AND ADDITIONAL PRE-EMPTION</p> <p>MAR 11/90 ASBULT 11/90</p> <p>ASBULT 11/90 INSTALL FIRE HOUSE SIGNAL AND 1/2 PRE-EMPTION WITH MD 607.</p>		<p>APPROVALS</p> <p>CHIEF, SIGNAL SECTION</p> <p>ASST. DISTRICT ENGINEER, TRAFFIC</p> <p>CHIEF, TRAFFIC ENGINEERING DIVISION</p> <p>DEPUTY CHIEF ENGINEER, OFFICE OF TRAFFIC</p>		<p>MARYLAND DEPARTMENT OF TRANSPORTATION STATE HIGHWAY ADMINISTRATION - OFFICE OF TRAFFIC TRAFFIC ENGINEERING DIVISION</p> <p>REDRAWN 10-31-90 DRAWN BY D. DICKERSON/B. THOMPSON</p> <p>DES. BY: R.R. ZACHERL(STS)</p> <p>CHK. BY: D. DODA 8-1-88</p> <p>DATE: 3-1-88 SCALE: 1"=20'</p>		<p>MD. 177 @ JACOBVILLE FIRE STATION</p> <p>SIGNAL NO. 02017704.17</p> <p>COUNTY: ANNE ARUNDEL</p> <p>TS/FILE NO. TS-2470 B</p> <p>SHEET NO. OF</p>	
---	--	--	--	---	--	---	--

02017704.17 P#