F.H.W.A. REGION NO.	STATE	FED. AID PROJ. NO.	SHEET NO.	TOTAL SHEETS
3	MD.		2	5

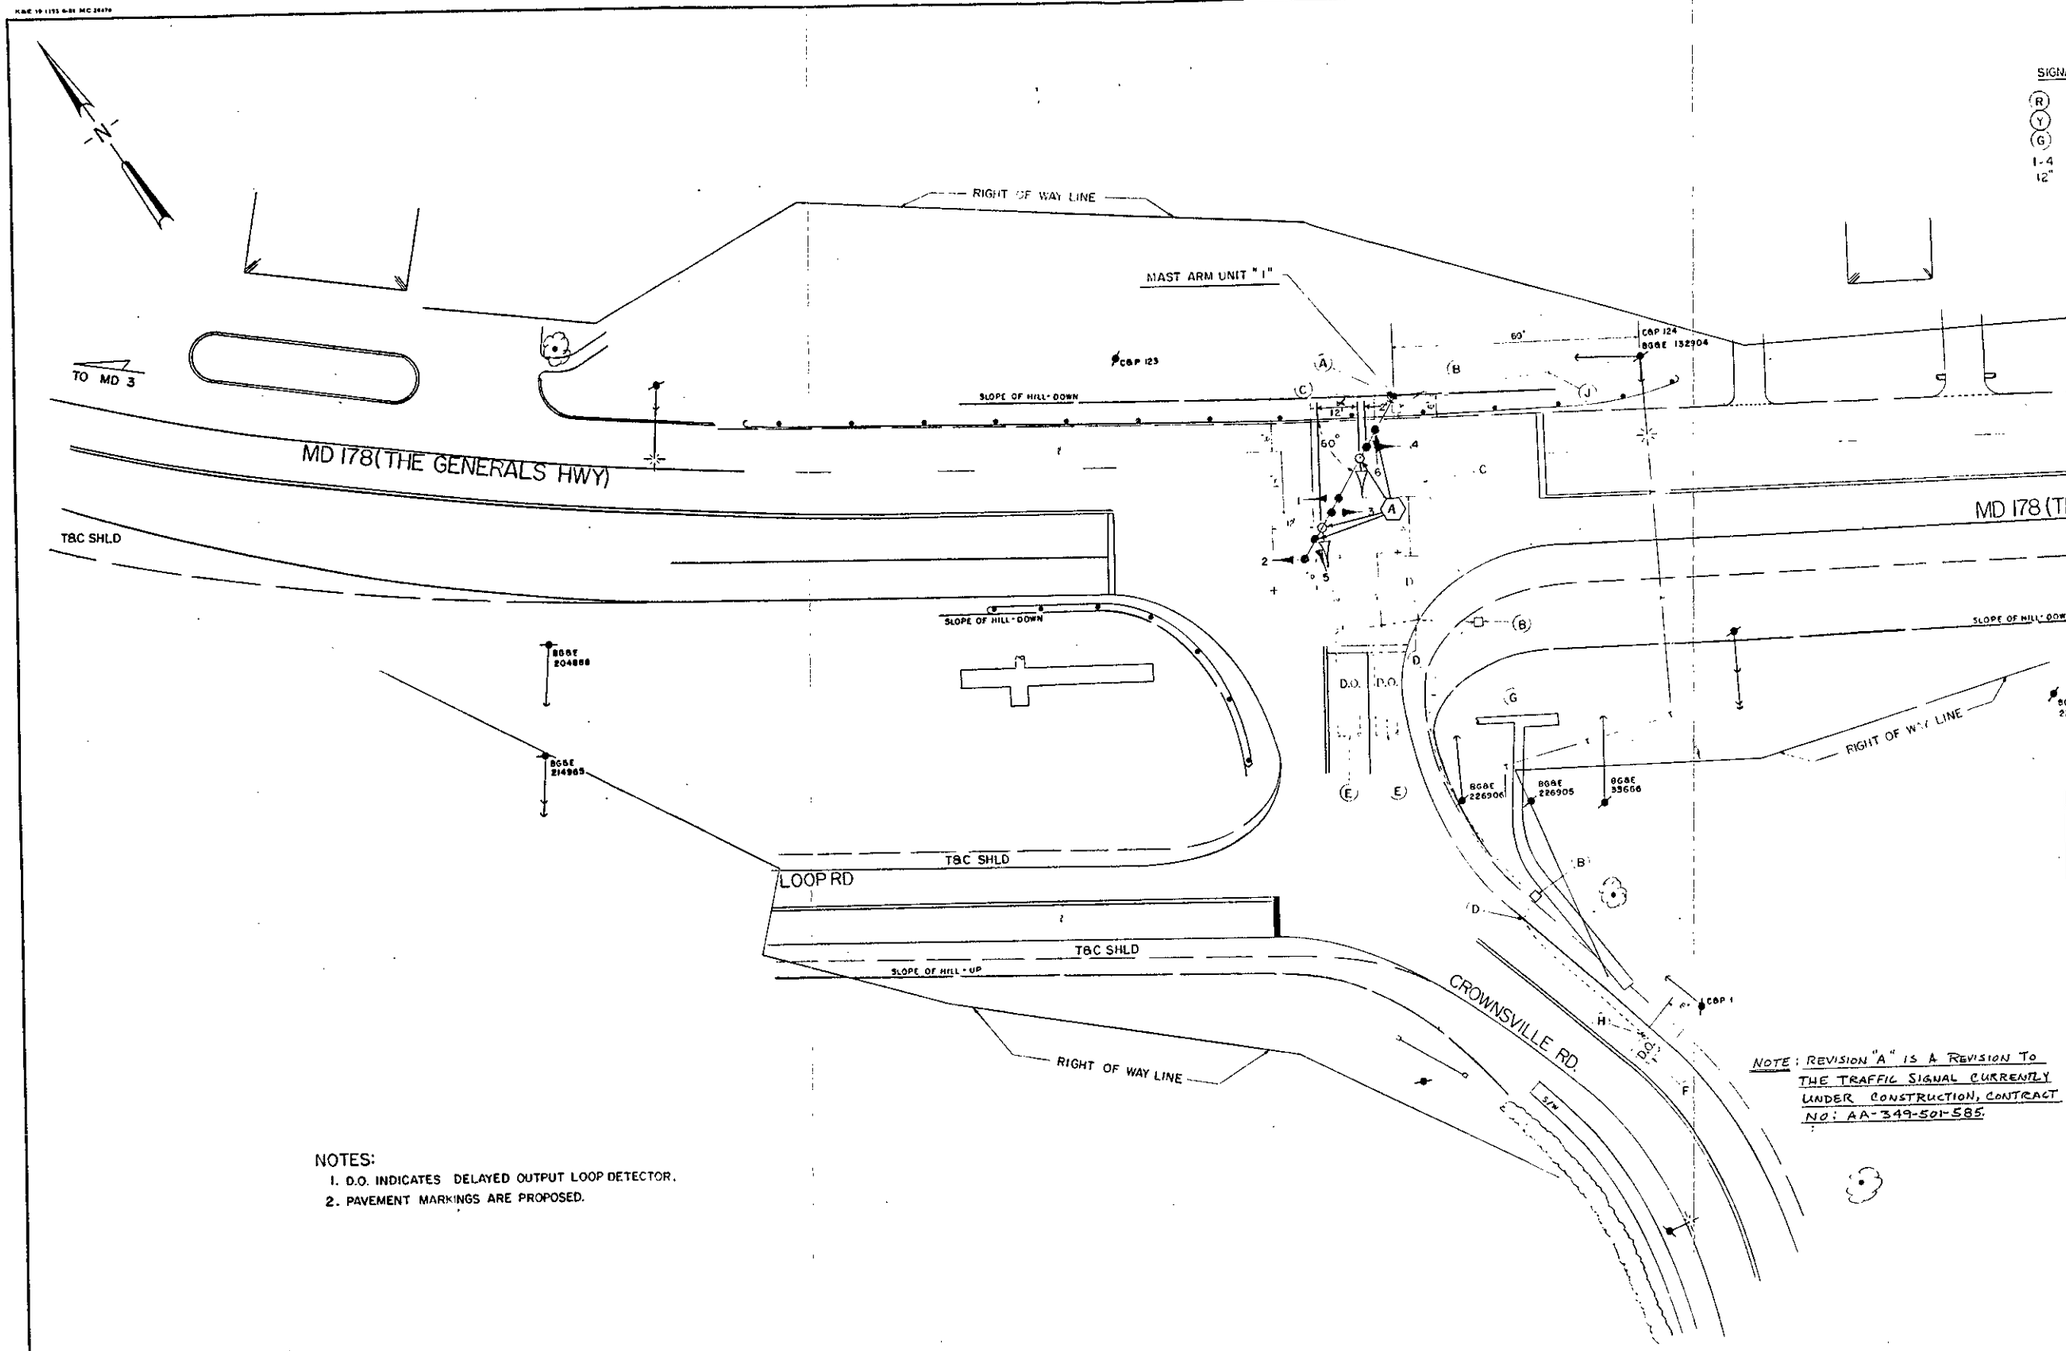

NOTE: REVISION "A" IS A REVISION TO THE TRAFFIC SIGNAL CURRENTLY UNDER CONSTRUCTION, CONTRACT NO: AA-349-501-585.

NOTES:
1. D.O. INDICATES DELAYED OUTPUT LOOP DETECTOR.
2. PAVEMENT MARKINGS ARE PROPOSED.

APPROVAL: CHIEF SIGNAL DESIGN SECTION

APPROVAL: REGIONAL TRAFFIC ENGINEER

Edward T. Paulis Jr. 1/19/83
APPROVAL: CHIEF BUREAU OF TRAFFIC ENGINEERING

APPROVAL: ASS'T. CHIEF ENGINEER TRAFFIC

(A) 8-9-83 RELOCATE SIG NOS. 5 & 6 AS PER D.T.E.'S REQUEST. S.H.A. NO. AA-349-501-585

REVISIONS

STATE OF MARYLAND
DEPARTMENT OF TRANSPORTATION
STATE HIGHWAY ADMINISTRATION

TRAFFIC DIVISION – BUREAU OF TRAFFIC ENGINEERING

MD 178 & CROWNSVILLE RD.

SCALE 1" = 20' DATE 11-1-82 CONTRACT NO. AA-349-501-585

DRAWN BY: J.A. BOLING COUNTY: ANNE ARUNDEL

DESIGNED BY: J.A. BOLING SIGNAL NO.

CHECKED BY: 1/10/83

DRAWING NO. TS-1892A

STREET TRAFFIC STUDIES LTD
16628 S. Westland Drive
Gaithersburg, Maryland 20760

02017804.22