FHWA REGION NO.	STATE	FED. AID PROJ. NO.	SHEET NO.	TOTAL SHEETS
3	MD			

SIGNALS

1-8

(R) 12"

SIGNS

9,10

Bush's Frontage RD

11,12

Saint Margarets RD

D 3-2
16" x Var.

NEMA PHASING

FLASHING OPERATION

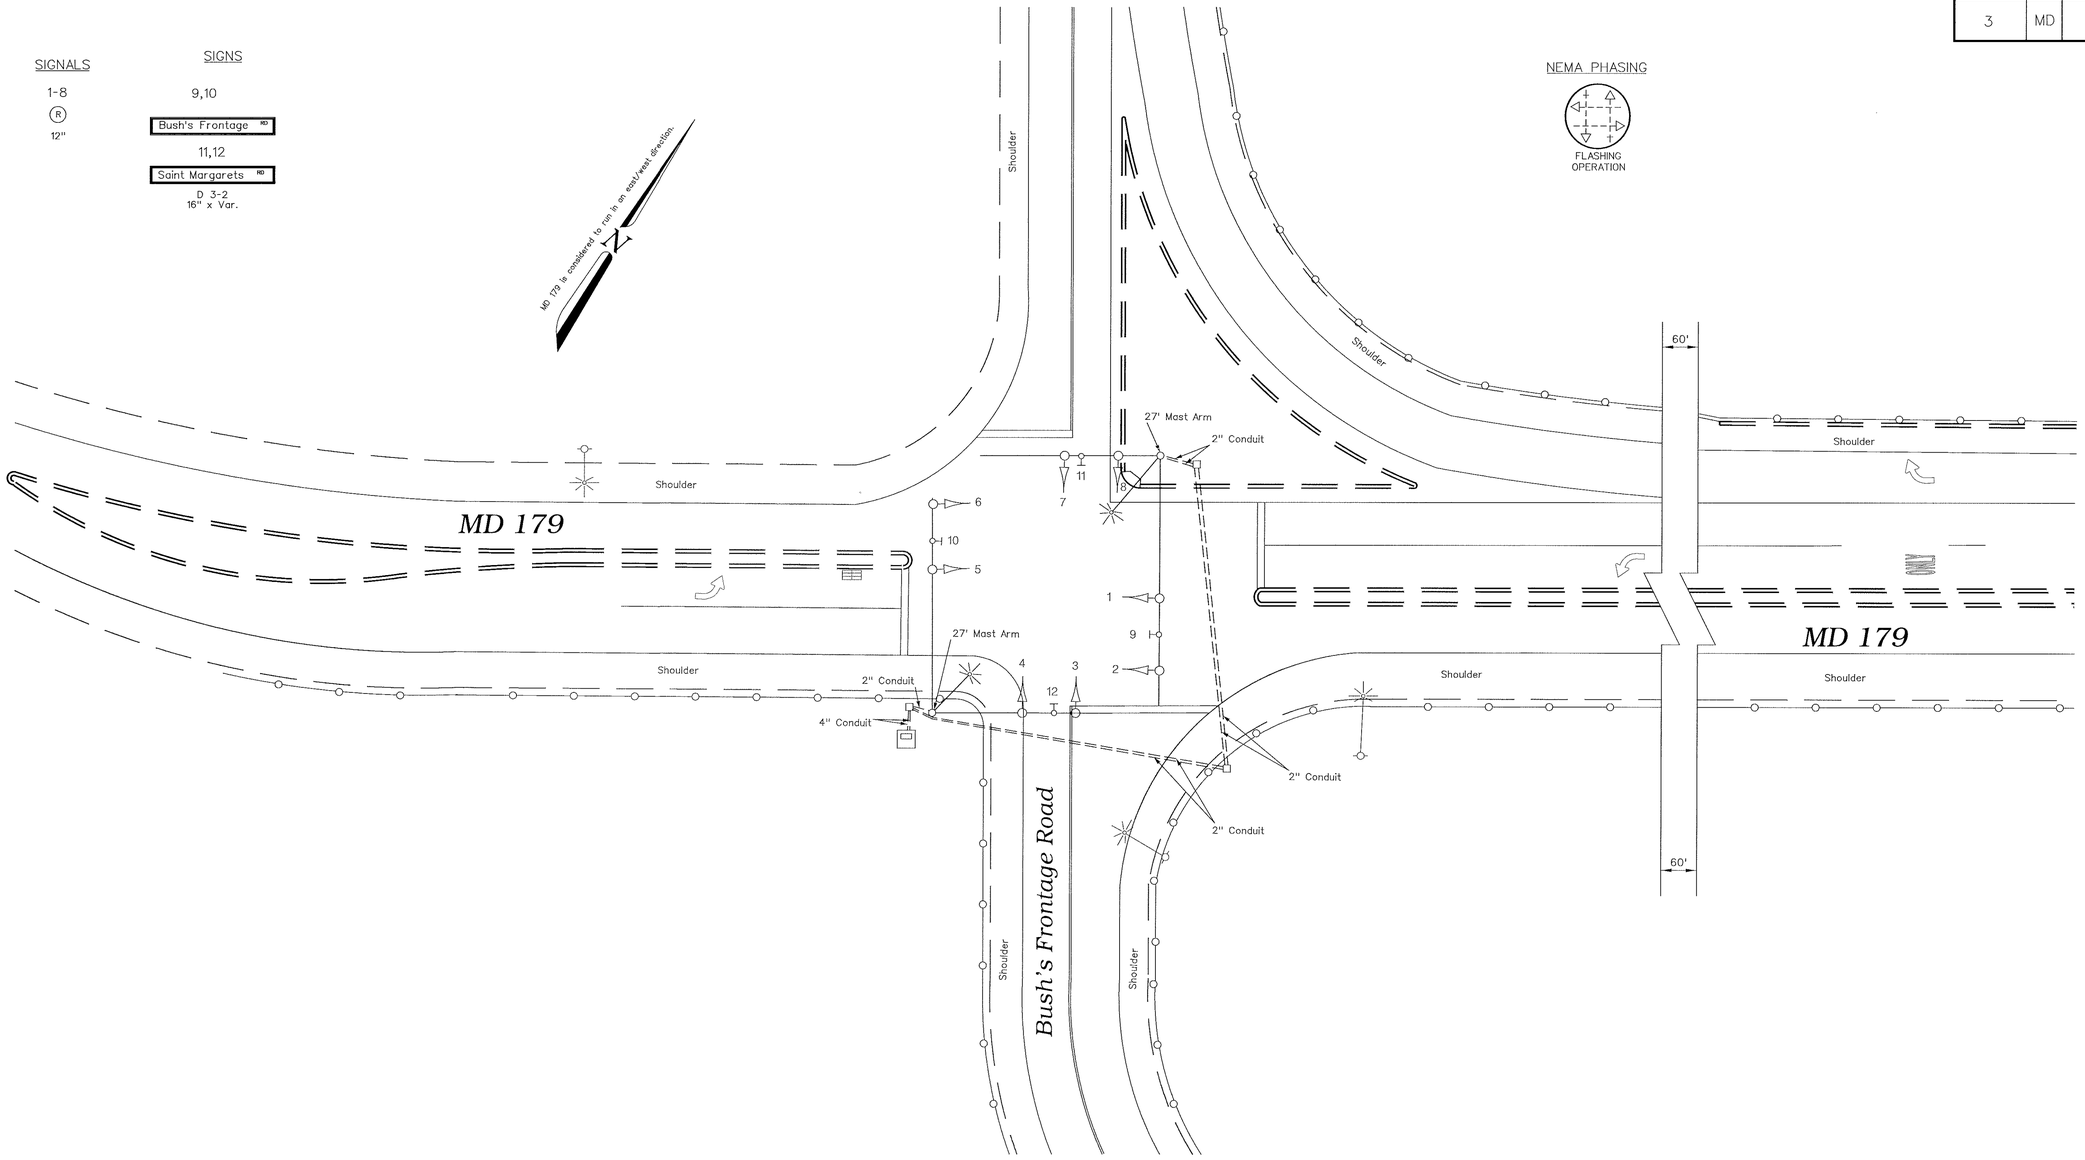

"As -Built"

The Traffic Group

The Traffic Group, Inc.
Suite 600
40 W. Chesapeake Avenue
Towson, Maryland 21204
410-583-8405
1-800-583-8411
Fax 410-321-8458
Job No. 960420

GEOMETRIC LEGEND

EXISTING GEOMETRICS

PROPOSED GEOMETRICS

UTILITY LEGEND

G	GAS MAIN
W	WATER MAIN
S	SEWER MAIN
E	ELECTRIC CABLES
D	STORM DRAIN
A	AERIAL CABLES
T	TELEPHONE CABLES

REVISIONS

(A) As-built May 7, 1996
S.H.A. No.: 855-25057048

APPROVALS

ASST. DIVISION CHIEF TRAFFIC ENGINEERING DESIGN DIVISION

CHIEF, TRAFFIC ENGINEERING DESIGN DIVISION

ASST. DISTRICT ENGINEER - TRAFFIC

DIRECTOR, OFFICE OF TRAFFIC & SAFETY

ORIGINAL ON FILE

MDOT – STATE HIGHWAY ADMINISTRATION
Office of Traffic & Safety
TRAFFIC ENGINEERING DESIGN DIVISION

DRAWN BY: T. Speca
DES. BY:
CHK. BY:

(Traffic Signal Plan)
MD 179 at
Bush's Frontage Road

COUNTY: ANNE ARUNDEL LOG MILE • 02017915.21

DATE: 10/31/95 F.A.P. NO. N/A
SCALE: 1" = 20' S.H.A. NO. 855-2507048

TS/STD. NO. 3597A-P

SHEET NO. 1 of 1