F.H.W.A. REGION NO.	STATE	FED. AID PROJ. NO.	SHEET NO.	TOTAL SHEETS
3	MD.			

NOTE:

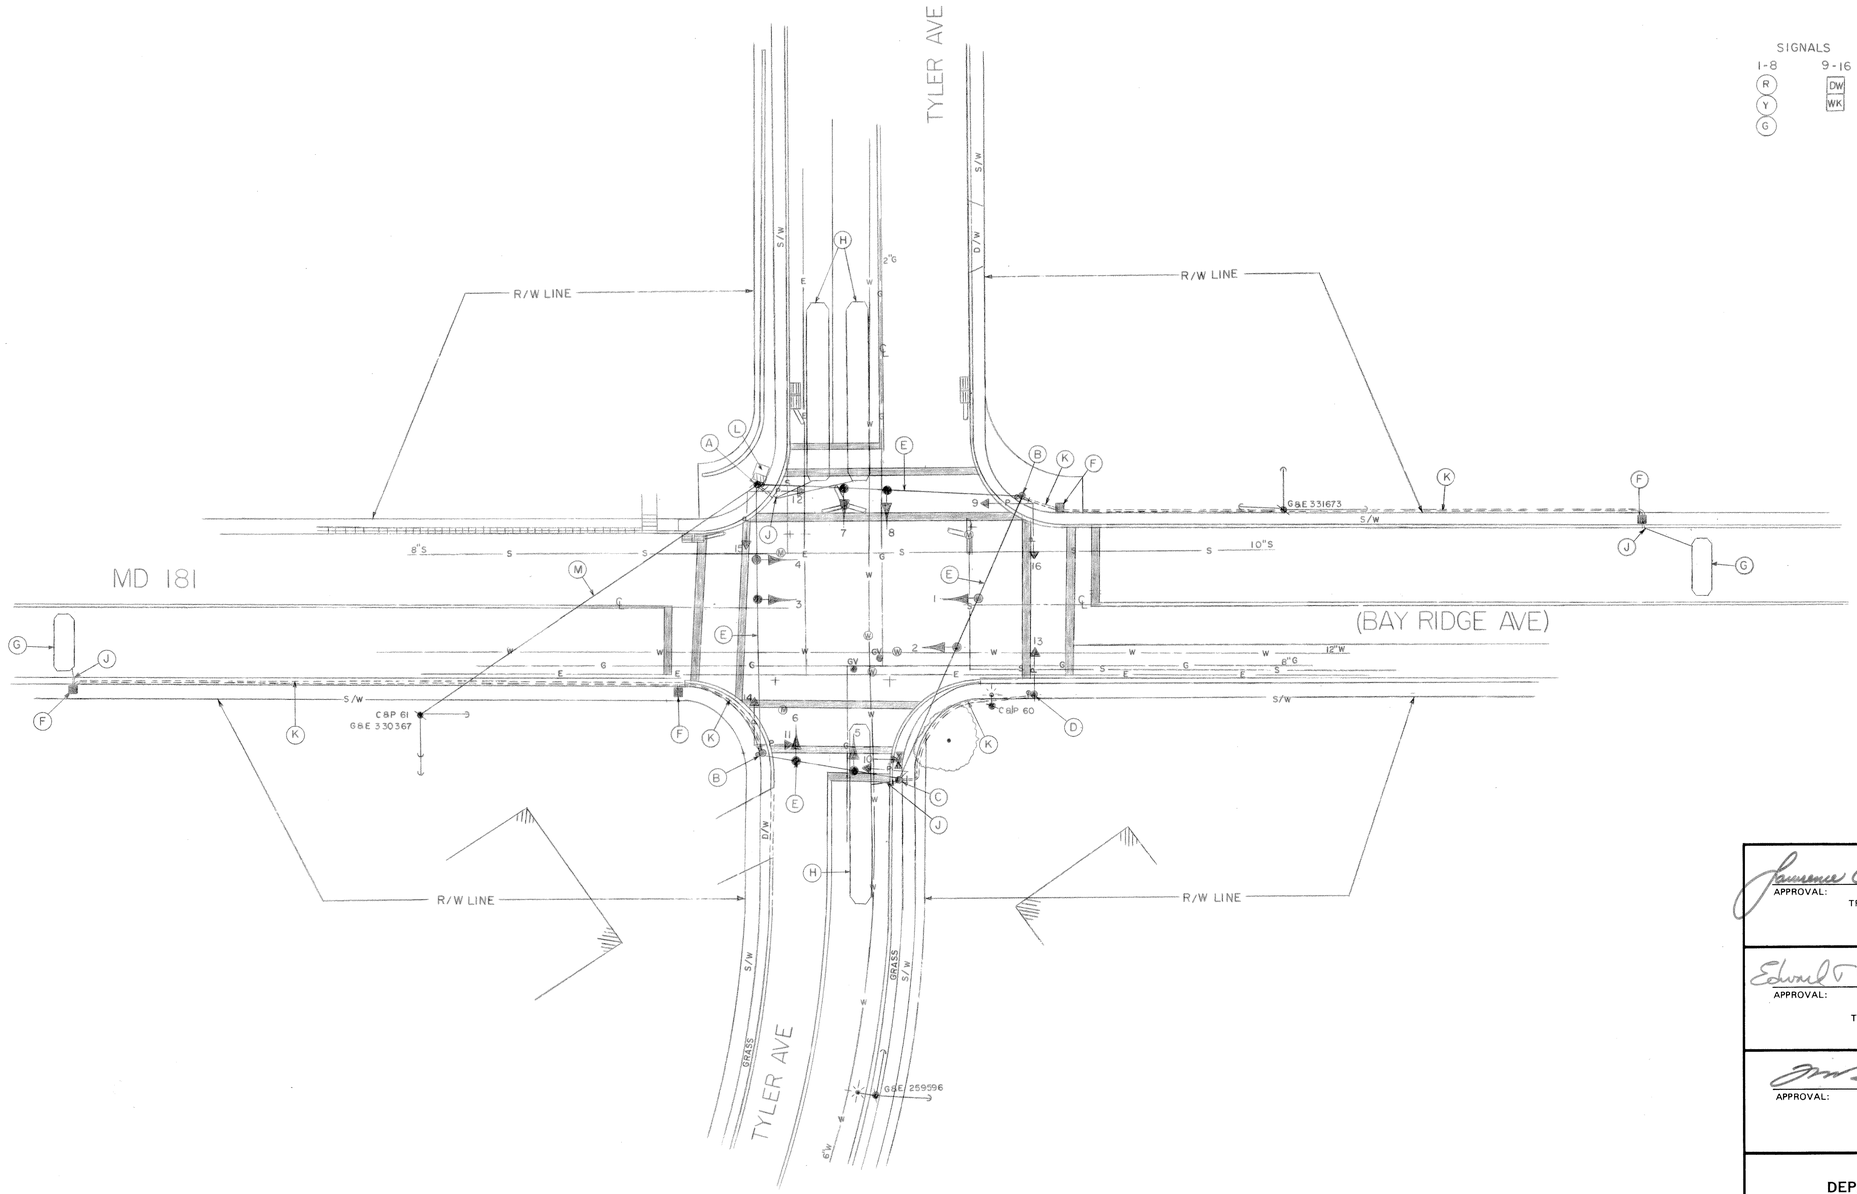

SIGNALS

1-8: R, Y, G

9-16: DW, WK

PHASE 1

PHASE 2

PHASE 2 ALTERNATE

FLASHING OPERATION

LEGEND OF UNDERGROUND UTILITIES

—G—G—	GAS MAIN
—W—W—	WATER MAIN
—S—S—	SEWER MAIN
—E—E—	ELECTRIC CABLES
—T—T—	TELEPHONE CABLES
—A—A—	AERIAL CABLES

Lawrence E. Eckhardt 7/22/75
APPROVAL: REGIONAL TRAFFIC ENGINEER

Edward T. Paulis Jr. 7/22/75
APPROVAL: CHIEF-BUREAU OF TRAFFIC ENGINEERING

7/22/75
APPROVAL: ASS'T. CHIEF ENGINEER TRAFFIC

A 5-4-76 ASBUILT AA-980X-000-585

DD A.B.

REVISIONS

STATE OF MARYLAND
DEPARTMENT OF TRANSPORTATION
STATE HIGHWAY ADMINISTRATION

TRAFFIC DIVISION – BUREAU OF TRAFFIC ENGINEERING

(Bay Ridge Ave.)
MD 181 & TYLER AVE (HILLTOP LA)

SCALE 1" = 20' DATE 5-29-75 CONTRACT NO.

DRAWN BY: JG, D DODA COUNTY: ANNE ARUNDEL

DESIGNED BY: D DODA 7-7-75 SIGNAL NO.: 02190

CHECKED BY: A. Budnichuk 7/22/75.

DRAWING NO. TS-827A

BRUNING 44-511 19927