FHWA REGION NO.	STATE	FED. AID PROJ. NO.	SHEET NO.	TOTAL SHEETS
3	MD			

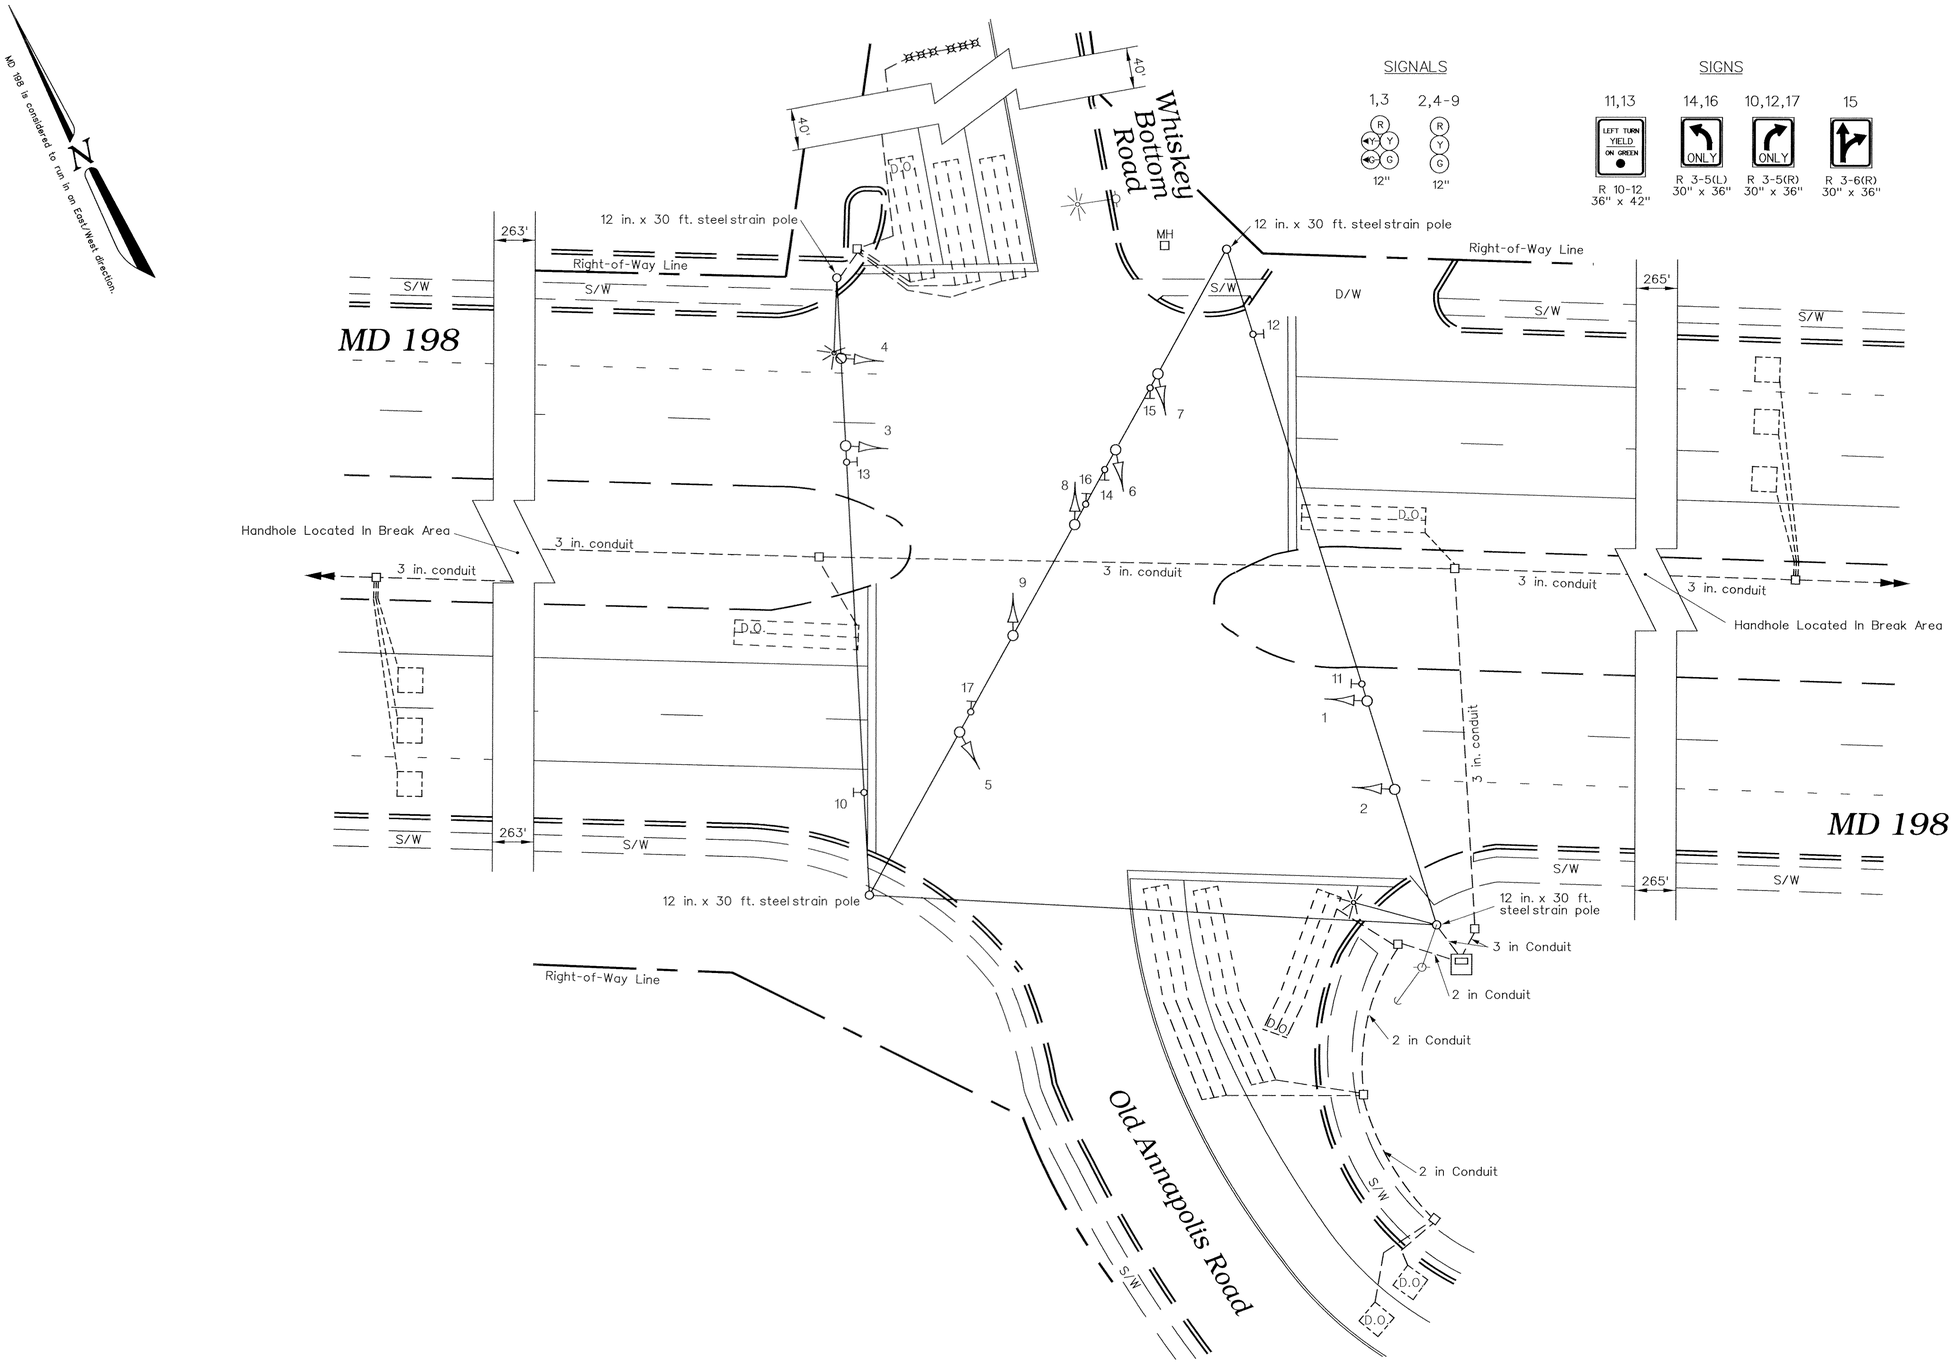

NEMA PHASING

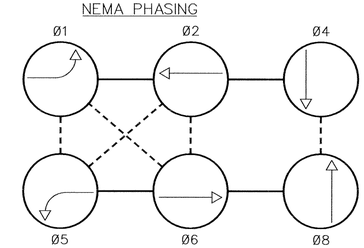

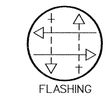

FLASHING OPERATION

PHASING NOTES:

1. PHASES ASSOCIATED BY A SOLID LINE WILL NOT OPERATE CONCURRENTLY
2. PHASES ASSOCIATED BY A DASHED LINE WILL OPERATE CONCURRENTLY

"AS BUILT"

The Traffic Group

The Traffic Group, Inc.
Suite 600
40 W. Chesapeake Avenue
Towson, Maryland 21204
410-583-8403
1-800-583-8411
Fax 410-321-8458
Job. No. 951117
SIGPLAN.DGN

GEOMETRIC LEGEND

EXISTING GEOMETRICS
PROPOSED GEOMETRICS

UTILITY LEGEND

G	GAS MAIN
W	WATER MAIN
S	SEWER MAIN
E	ELECTRIC CABLES
D	STORM DRAIN
A	AERIAL CABLES
T	TELEPHONE CABLES

REVISIONS

© AS-BUILT January 12, 1998

M.A.M.

APPROVALS

ASST. DIVISION CHIEF TRAFFIC ENGINEERING DESIGN DIVISION

CHIEF, TRAFFIC ENGINEERING DESIGN DIVISION

ASST. DISTRICT ENGINEER - TRAFFIC

DIRECTOR, OFFICE OF TRAFFIC & SAFETY

ORIGINAL ON FILE

MDOT – STATE HIGHWAY ADMINISTRATION
Office of Traffic & Safety
TRAFFIC ENGINEERING DESIGN DIVISION

DRAWN BY: H. KILIAN
DES. BY: H. KILIAN
CHK. BY: N/A

(Traffic Signal Plan)

MD 198 at Whiskey Bottom Rd / Old Annapolis Rd

COUNTY: ANNE ARUNDEL
LOG MILE • 02019801.12

DATE: January 4, 1983
SCALE: 1" = 20'

F.A.P. NO. N/A
S.H.A. NO. AA 487-501-571 P 762-503-371

TS/STD. NO. 1893-C

SHEET NO. 1 of 1