EXISTING SIGNS

15,16,17,19	14,20	18	21,22
ONLY	ONLY		LEFT ON GREEN ARROW ONLY
R 3-5(L) 30" x 36"	R 3-5(R) 30" x 36"	R 3-6(R) 30" x 36"	R 10-5 24" x 20"

EXISTING SIGNALS

1,2,5,6	3,4,7,8	9-13
R, Y, G	R, Y, G	R, Y, G
12" Black faced	12" Black faced	12"

EXISTING NEMA PHASING

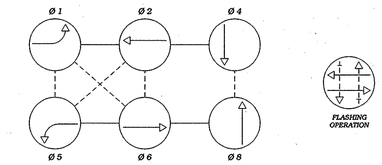

NEMA notes:
Phases associated by a dashed line will operate concurrently.
Phases associated by a solid line will not operate concurrently.

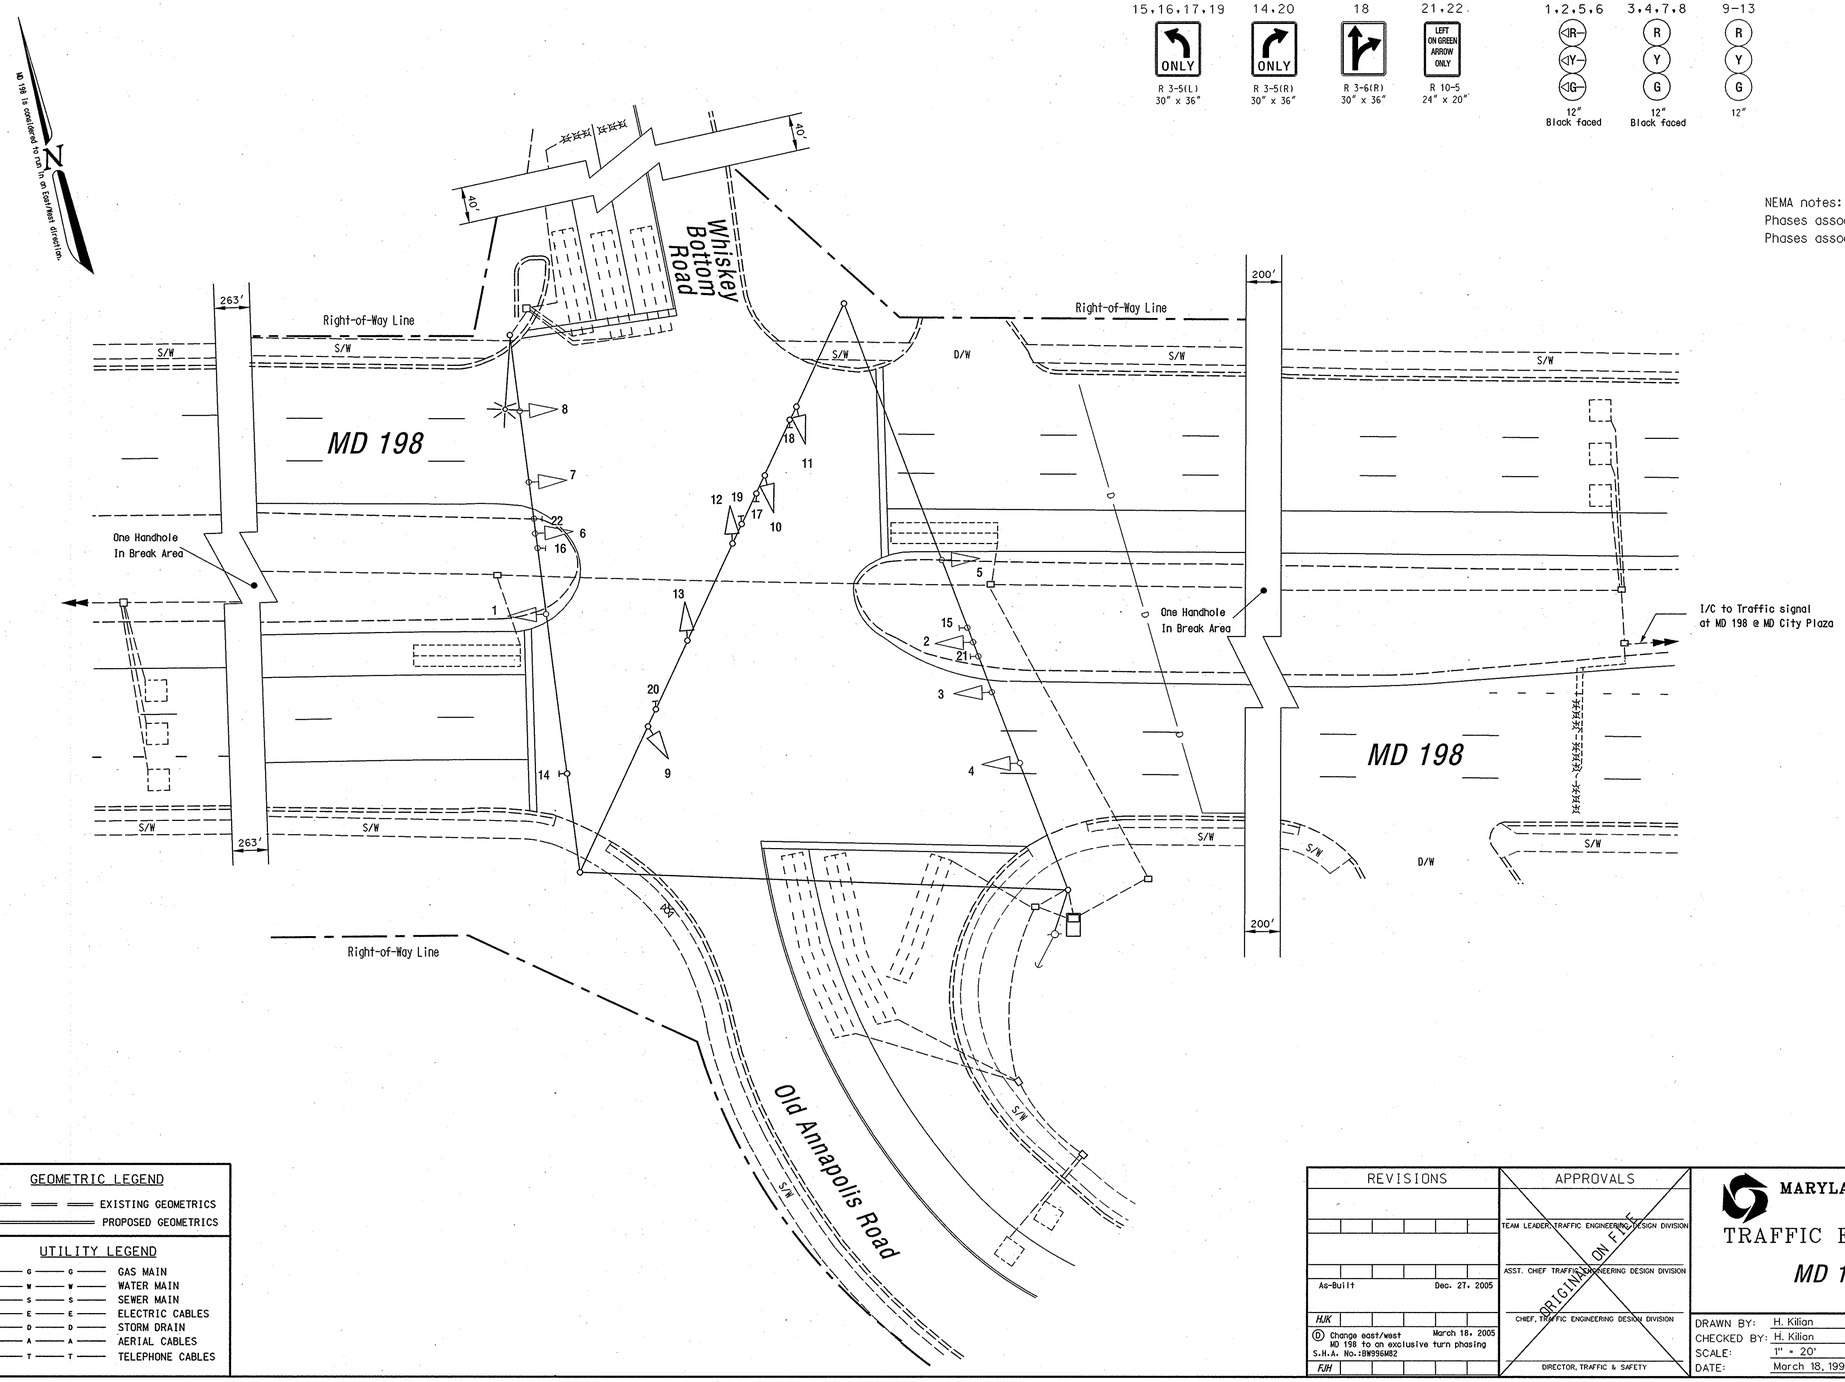

As-Built 12/05

The Traffic Group

The Traffic Group, Inc.
410-931-6600
Fax 410-931-6601

GEOMETRIC LEGEND

- EXISTING GEOMETRICS
- PROPOSED GEOMETRICS

UTILITY LEGEND

G	GAS MAIN
W	WATER MAIN
S	SEWER MAIN
E	ELECTRIC CABLES
D	STORM DRAIN
A	AERIAL CABLES
T	TELEPHONE CABLES

REVISIONS		
As-Built	Dec. 27, 2005	HJK
0 Change east/west MD 198 to an exclusive turn phasing S.H.A. No.:BW996M82	March 18, 2005	FJH

APPROVALS

TEAM LEADER, TRAFFIC ENGINEERING DESIGN DIVISION

ASST. CHIEF TRAFFIC ENGINEERING DESIGN DIVISION

CHIEF, TRAFFIC ENGINEERING DESIGN DIVISION

DIRECTOR, TRAFFIC & SAFETY

ORIGINAL ON FILE

MARYLAND DOT - STATE HIGHWAY ADMINISTRATION

Office of Traffic & Safety

TRAFFIC ENGINEERING DESIGN DIVISION

(Traffic Signal Plan)

MD 198 at Whiskey Bottom Rd./ Old Annapolis Rd.

DRAWN BY:	H. Kilian	F.A.P. NO.	N/A	TS NO.	SHEET NO.
CHECKED BY:	H. Kilian	S.H.A. NO.	AA 487-501-507 P 762-503-371	1893-D	1 OF 1
SCALE:	1" = 20'	COUNTY:	Anne Arundel	T.I.M.S. NO.	
DATE:	March 18, 1998	LOG MILE:	02019801.12	H-001	

f:\2003\2003-0403\Dwg\AS-Built-MD198_Whisky Bottom.dgn 1/10/2006