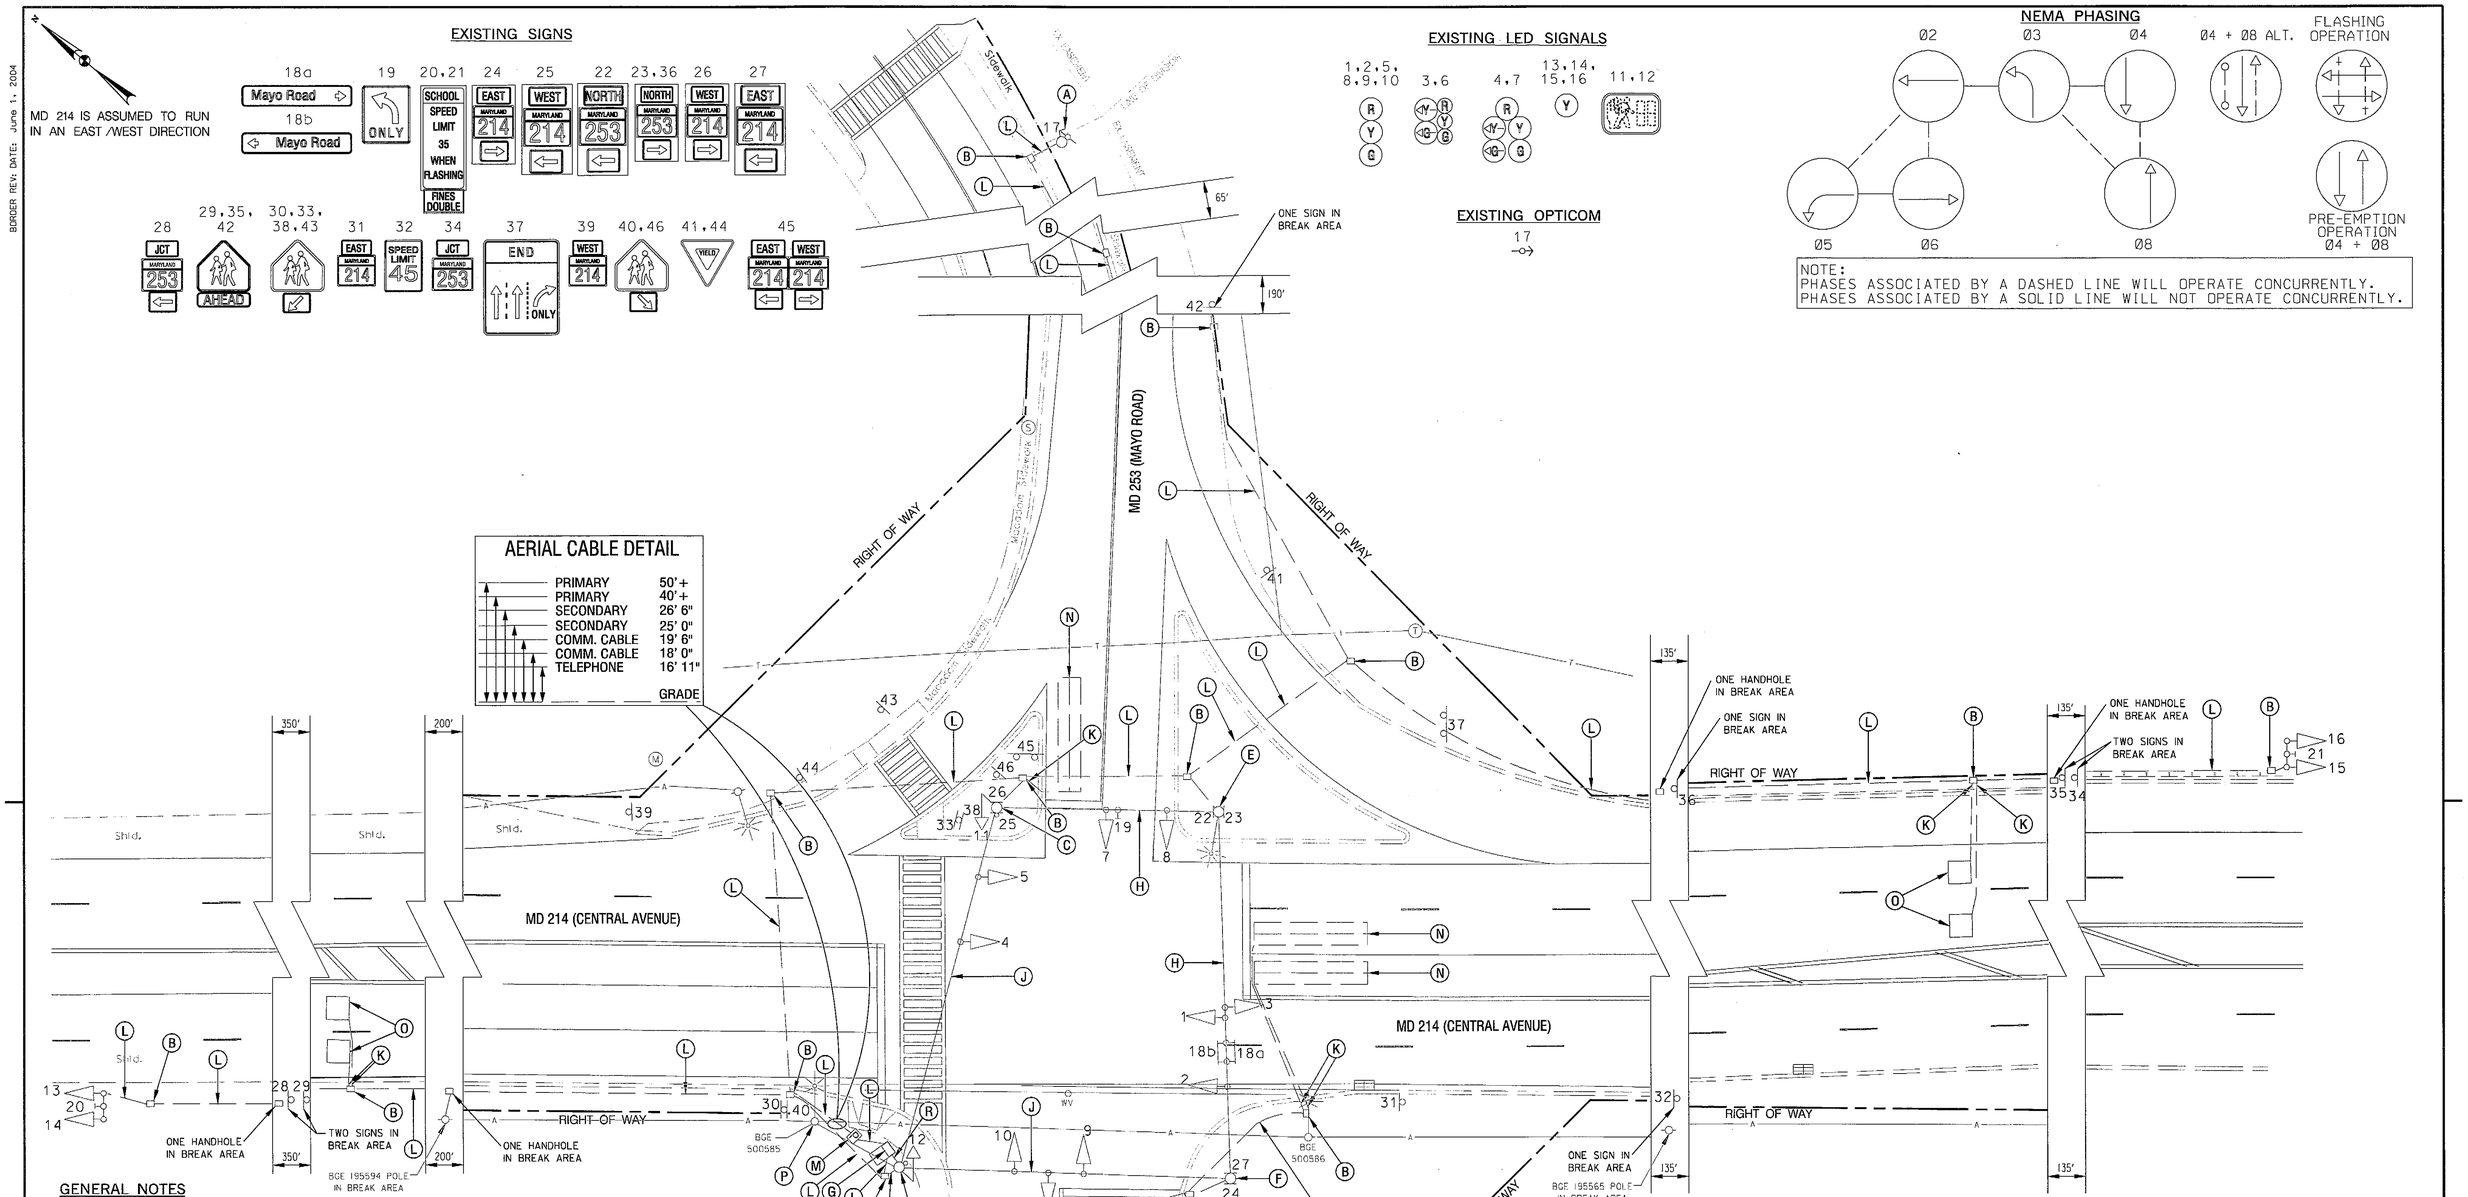

GENERAL NOTES

A. OPTICOM DETECTOR ON PEDESTAL POLE.
B. HANDHOLE.
C. 12" x 30' STRAIN POLE, AUDIBLE PUSHBUTTON STATION, COUNTDOWN SIGNAL HEADS, AND SIGNS.
D. 12" x 30' STRAIN POLE, AUDIBLE PUSHBUTTON STATION AND COUNTDOWN SIGNAL HEADS.
E. 12" x 30' STRAIN POLE WITH 8' LIGHTING ARM, LUMINAIRE AND SIGNS.
F. 12" x 30' STRAIN POLE AND SIGNS.
G. BASE MOUNTED CABINET AND CONTROLLER WITH ALL NECESSARY EQUIPMENT. (NOTE: 2-4" GALVANIZED STEEL BEND AND 2-2" CONDUIT BEND)
H. 3/8" STEEL SPAN WIRE, TRAFFIC SIGNAL HEADS AND SIGNS.
J. 3/8" STEEL SPAN WIRE, TRAFFIC SIGNAL HEADS.
K. 1" GALVANIZED STEEL CONDUIT.
L. 3 IN. SCHEDULE 80 RIGID PVC ELECTRICAL CONDUIT.
M. EMBEDDED METERED PEDESTAL.
N. 6' x 30' LOOP DETECTOR ENCASED IN 3/4" FLEXIBLE TUBING.
O. 6' x 6' LOOP DETECTOR ENCASED IN 3/4" FLEXIBLE TUBING.
P. UNDERGROUND ELECTRICAL SERVICE MAINTAINED BY BGE.
Q. 6' x 30' LOOP DETECTOR (CUTS NOT VISIBLE IN FIELD).
R. 4 IN. SCHEDULE 80 RIGID PVC ELECTRICAL CONDUIT.

GEOMETRIC LEGEND

EXISTING
PROPOSED

UTILITY LEGEND

SD — STORM DRAIN
G — GAS MAIN
W — WATER MAIN
SAN — SEWER MAIN
E — ELECTRIC CABLES
A — AERIAL CABLES
T — TELEPHONE CABLES
FO — FIBER-OPTIC

GENERAL NOTES

1. THIS PLAN REFLECTS ONLY THOSE UNDERGROUND UTILITIES THAT WERE APPARENT AT THE TIME OF THIS ASBUILT. A DETAILED REVIEW WAS NOT UNDERTAKEN AND THE PLAN SHOULD NOT BE CONSTRUED AS REPRESENTING ALL UNDERGROUND UTILITIES IN THE AREA.
2. ANY MODIFICATION TO THIS SUBJECT SIGNAL SHOULD BE PRECEDED BY A THOROUGH IDENTIFICATION OF ALL EXISTING UTILITIES.

SABRA, WANG & ASSOCIATES, INC.
1504 JOH AVENUE
SUITE 160
BALTIMORE, MD 21227
(410) 737-6564
WWW.SABRA-WANG.COM

REVISIONS		
H	ASBUILT SHA No. AT9365185 TIMS# 1048	06/ /2009
SWA F	ADD OPTICOM DETECTOR FOR SOUTHBOUND MD 253 (MAYO ROAD) SHA NO. AT7825185	10/2005
STV MWR E	MODIFICATION FOR GEOMETRIC CHANGES SHA NO.: BW 996M82	02/2000

STATE OF MARYLAND
DEPARTMENT OF TRANSPORTATION
STATE HIGHWAY ADMINISTRATION
OFFICE OF TRAFFIC & SAFETY
TRAFFIC ENGINEERING DESIGN DIVISION

MD 214 (CENTRAL AVENUE) AND MD 253 (MAYO ROAD)/ENTRANCE TO CENTRAL SCHOOL COMPLEX

TRAFFIC SIGNAL PLAN

SCALE 1"= 20' DATE JULY 25, 1977 CONTRACT NO. N/A
DESIGNED BY
DRAWN BY GFD/DJD
CHECKED BY ADB
F.A.P. NO. N/A
COUNTY ANNE ARUNDEL
LOGMILE 02021406.63
T.I.M.S. NO. G931
TOD NO. N/A
DRAWING NO. TS-1522H
SHEET NO. 1 OF 2

PLOTTED: THURSDAY, JUNE 04, 2009 AT 08:51 AM
FILE: R:\2004\45 SHA BCS 2004-028 TEDD TRAFFIC\TASK 30\DGN\MD 214 AND MD 253\PSG_P001_ASBUILT-2.DGN

BORDER REV: DATE: June 1, 2004
BY: JWOOD