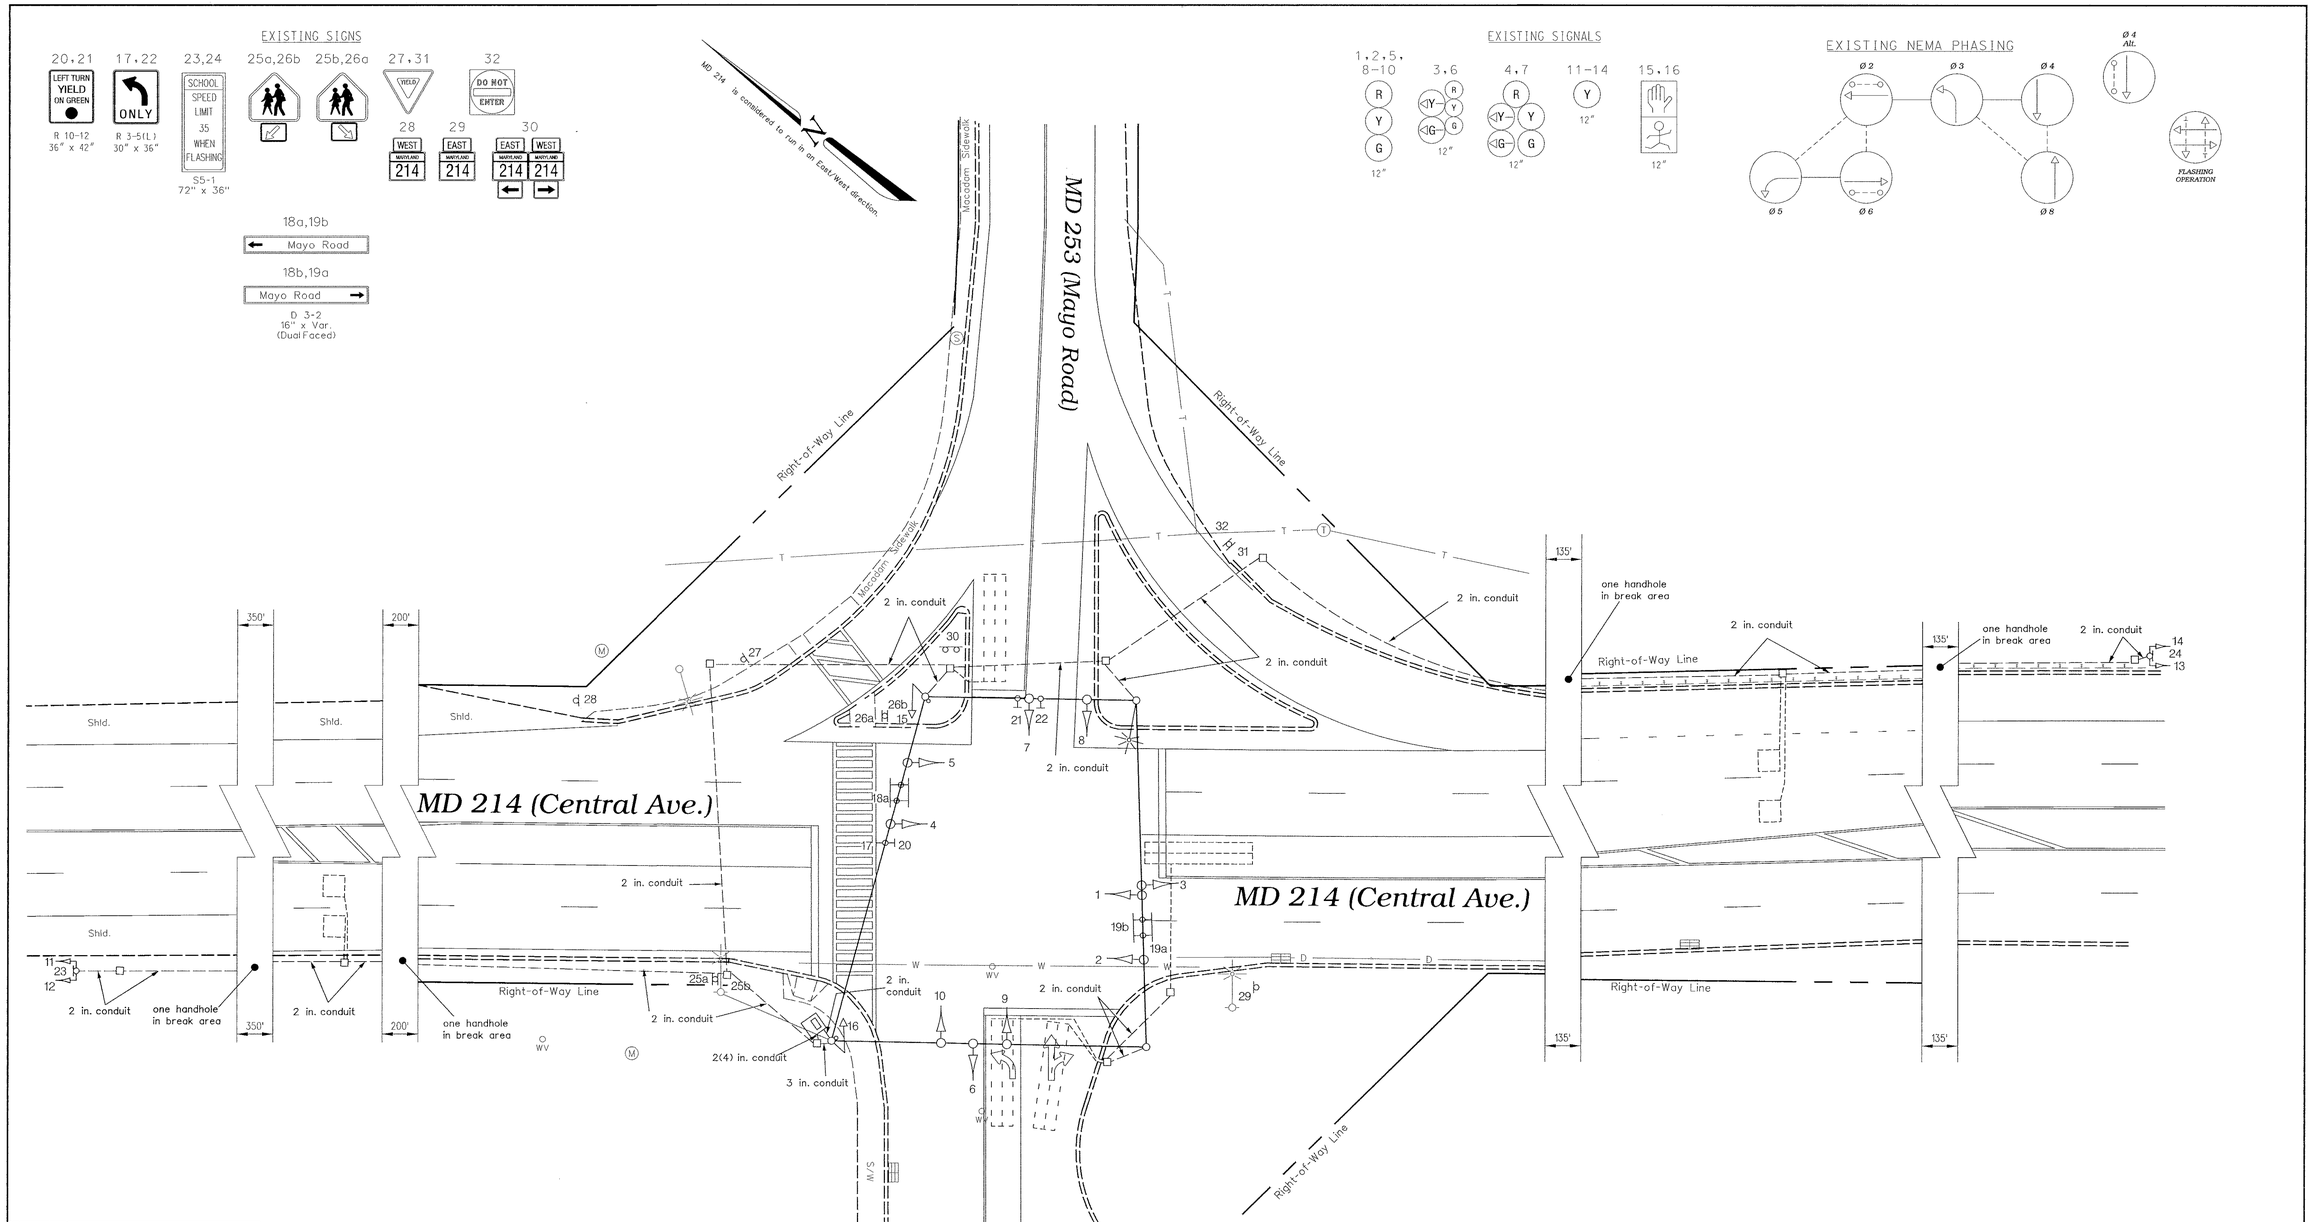


GEOMETRIC LEGEND

EXISTING GEOMETRICS

PROPOSED GEOMETRICS

UTILITY LEGEND

GAS MAIN

WATER MAIN

SEWER MAIN

ELECTRIC CABLES

STORM DRAIN

AERIAL CABLES

TELEPHONE CABLES

As-Built

The Traffic Group

The Traffic Group, Inc.
410-931-6600
Fax 410-931-6601

REVISIONS

February 7, 2002

"As-Built"
S.H.A. No.:8W996M82

APPROVALS

TEAM LEADER, TRAFFIC ENGINEERING DESIGN DIVISION

ASST. CHIEF TRAFFIC ENGINEERING DESIGN DIVISION

CHIEF, TRAFFIC ENGINEERING DESIGN DIVISION

DIRECTOR, TRAFFIC & SAFETY

ORIGINAL ON FILE

MARYLAND DOT - STATE HIGHWAY ADMINISTRATION

*Office of Traffic & Safety*

TRAFFIC ENGINEERING DESIGN DIVISION

(Traffic Signal Plan)

*MD 214 (Central Ave.) at MD 253 (Mayo Rd.)*

| | | | | | |
|---|---|---|---|---|---|
| DRAWN BY: GFD/DJD | F.A.P. NO. N/A | TS NO. 1522E | SHEET NO. |
| CHECKED BY: ADB | S.H.A. NO. N/A | | |
| SCALE: 1" = 20' | COUNTY: Anne Arundel | T.I.M.S. NO. D-212 | 1 OF 1 |
| DATE: July 25, 1977 | LOG MILE: 02021406.68 | | |

F:\1996\960808\DES\as-built.dgn 02/07/2002