F.H.W.A. REGION NO.	STATE	FED. AID PROJ. NO.	SHEET NO.	TOTAL SHEETS
3	MD.			

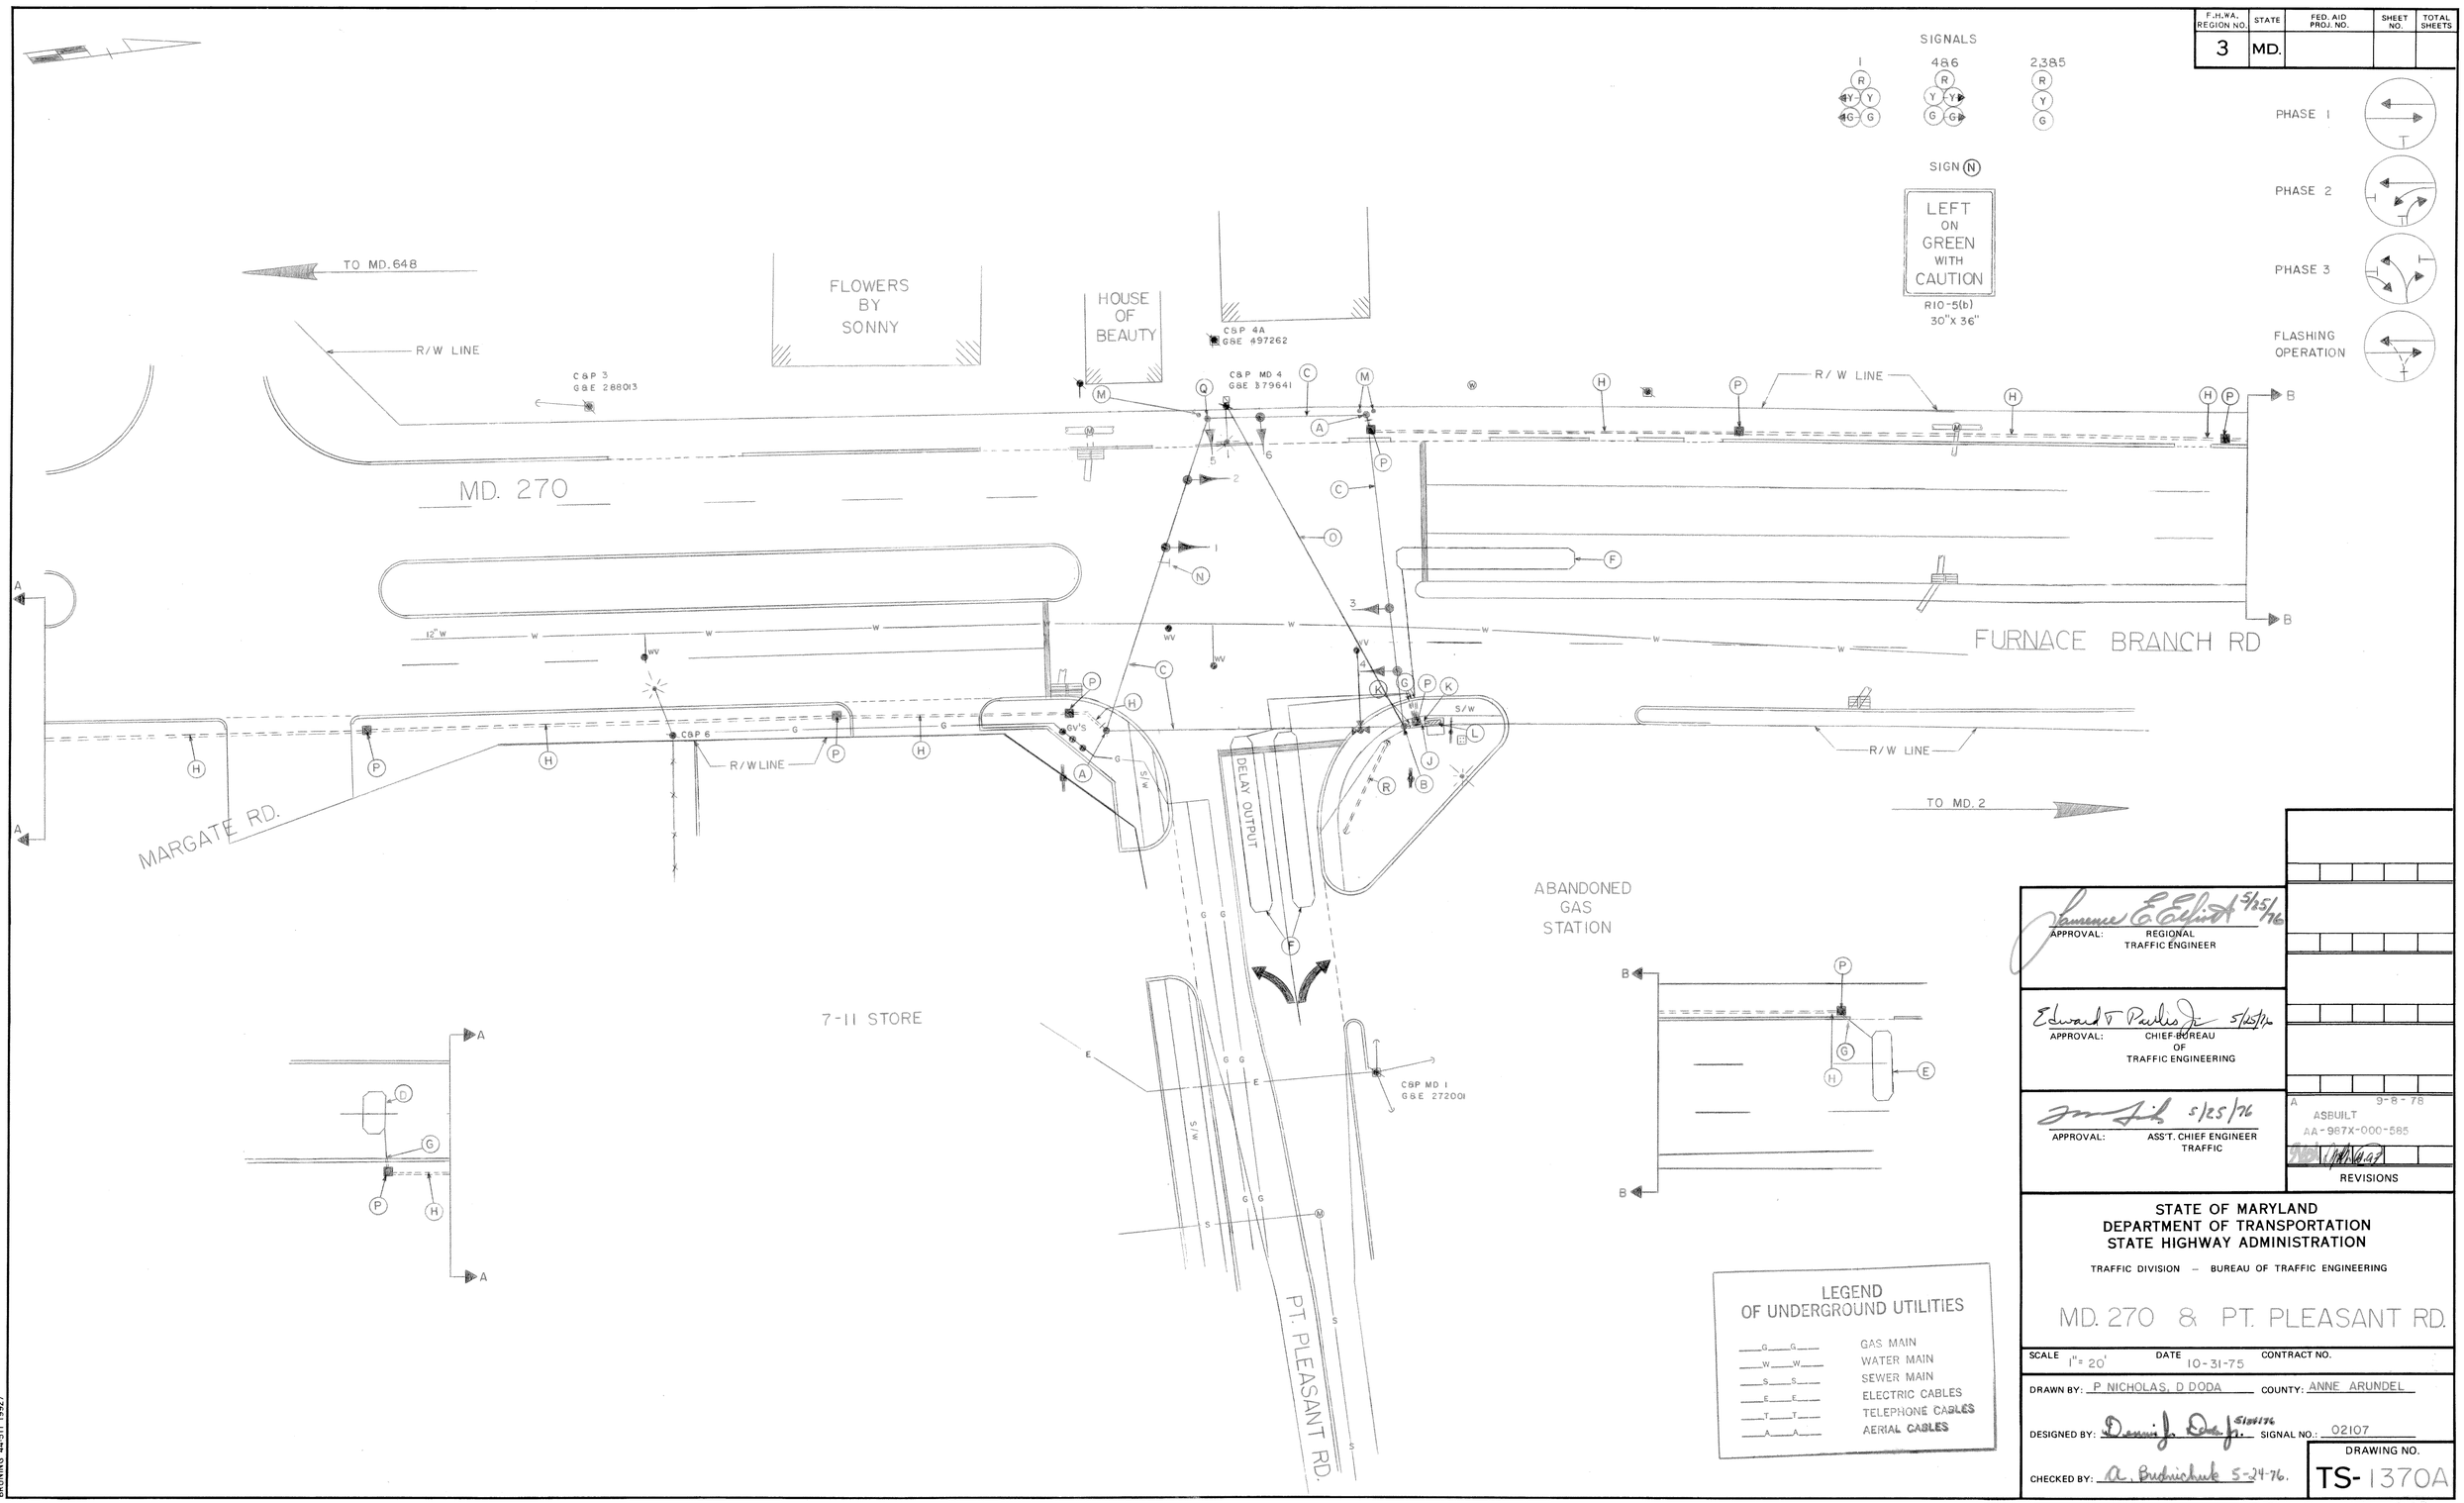

LEGEND OF UNDERGROUND UTILITIES

G G	GAS MAIN
W W	WATER MAIN
S S	SEWER MAIN
E E	ELECTRIC CABLES
T T	TELEPHONE CABLES
A A	AERIAL CABLES

APPROVAL: REGIONAL TRAFFIC ENGINEER — Lawrence E. Eckert 5/25/76

APPROVAL: CHIEF BUREAU OF TRAFFIC ENGINEERING — Edward T. Pierlis Jr. 5/25/76

APPROVAL: ASS'T. CHIEF ENGINEER TRAFFIC — 5/25/76

A 9-8-78 ASBUILT AA-987X-000-585

REVISIONS

STATE OF MARYLAND
DEPARTMENT OF TRANSPORTATION
STATE HIGHWAY ADMINISTRATION

TRAFFIC DIVISION – BUREAU OF TRAFFIC ENGINEERING

MD. 270 & PT. PLEASANT RD.

SCALE 1" = 20' DATE 10-31-75 CONTRACT NO.

DRAWN BY: P NICHOLAS, D DODA COUNTY: ANNE ARUNDEL

DESIGNED BY: Dennis J. Doda Jr. 5/25/76 SIGNAL NO.: 02107

CHECKED BY: A. Budnichuk 5-24-76.

DRAWING NO. TS-1370A

BRUNING 44511 19927