K&E BALTIMORE 17 0153 PHOENIX 54090•

FED. ROAD DIV. NO.	STATE	FED. AID PROJ. NO.	SHEET NO.	TOTAL SHEETS
3	MD.			

SIGNALS

1-9

R Y G

PHASE A

PHASE B

FLASHING OPERATION

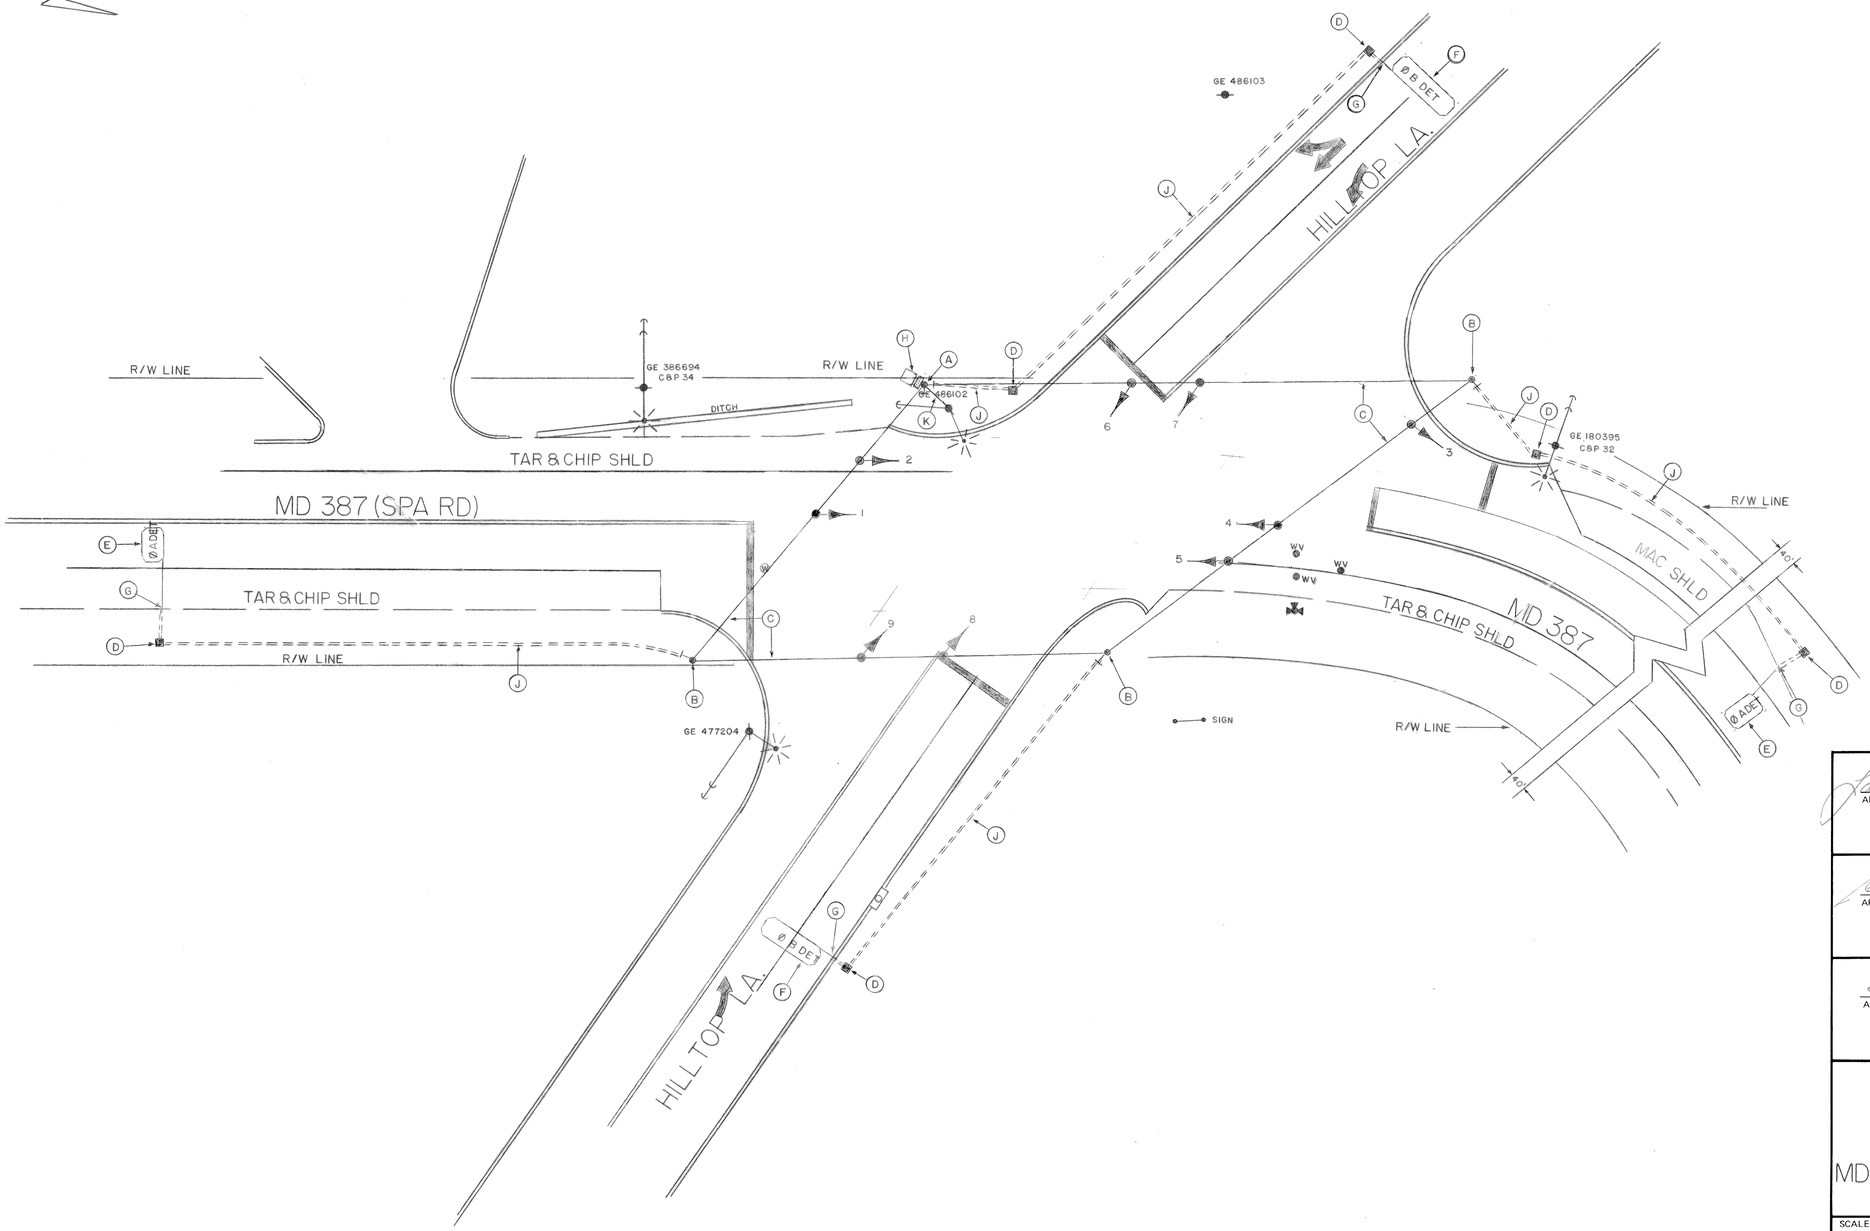

APPROVAL: REGIONAL TRAFFIC ENGINEER — 10/11/73

APPROVAL: CHIEF-BUREAU OF TRAFFIC ENGINEERING — 10/11/73

APPROVAL: ASS'T. CHIEF ENGINEER TRAFFIC — 10/11/73

A	6-24-74	ASBUILT	AA 899X-585
DD	AB		

REVISIONS

STATE OF MARYLAND
DEPARTMENT OF TRANSPORTATION
STATE HIGHWAY ADMINISTRATION

TRAFFIC DIVISION – BUREAU OF TRAFFIC ENGINEERING

MD 387 (SPA RD) & HILLTOP LANE

SCALE 1"=20' DATE 2-13-73 CONTRACT NO. AA 899X-585

DRAWN BY: J GORDON COUNTY: ANNE ARUNDEL

DESIGNED BY: Hugh D. Rinehart SIGNAL NO.: 0 2003

CHECKED BY: Alfred D. Budniechuk

DRAWING NO. TS-863A