FHWA REGION NO.	STATE	FED. AID PROJ. NO.	SHEET NO.	TOTAL SHEETS
3	MD			

SIGNALS

1-6

R 12"
Y 12"
G 8"

SIGNS

7,8

FIRE HOUSE SIGNAL

W11-8b (Modified)
(48" x 72")

MD 424 is considered to run in a North/South direction.

NEMA PHASING

PRE_EMPTION PHASE

NORMAL PHASE

FLASHING OPERATION

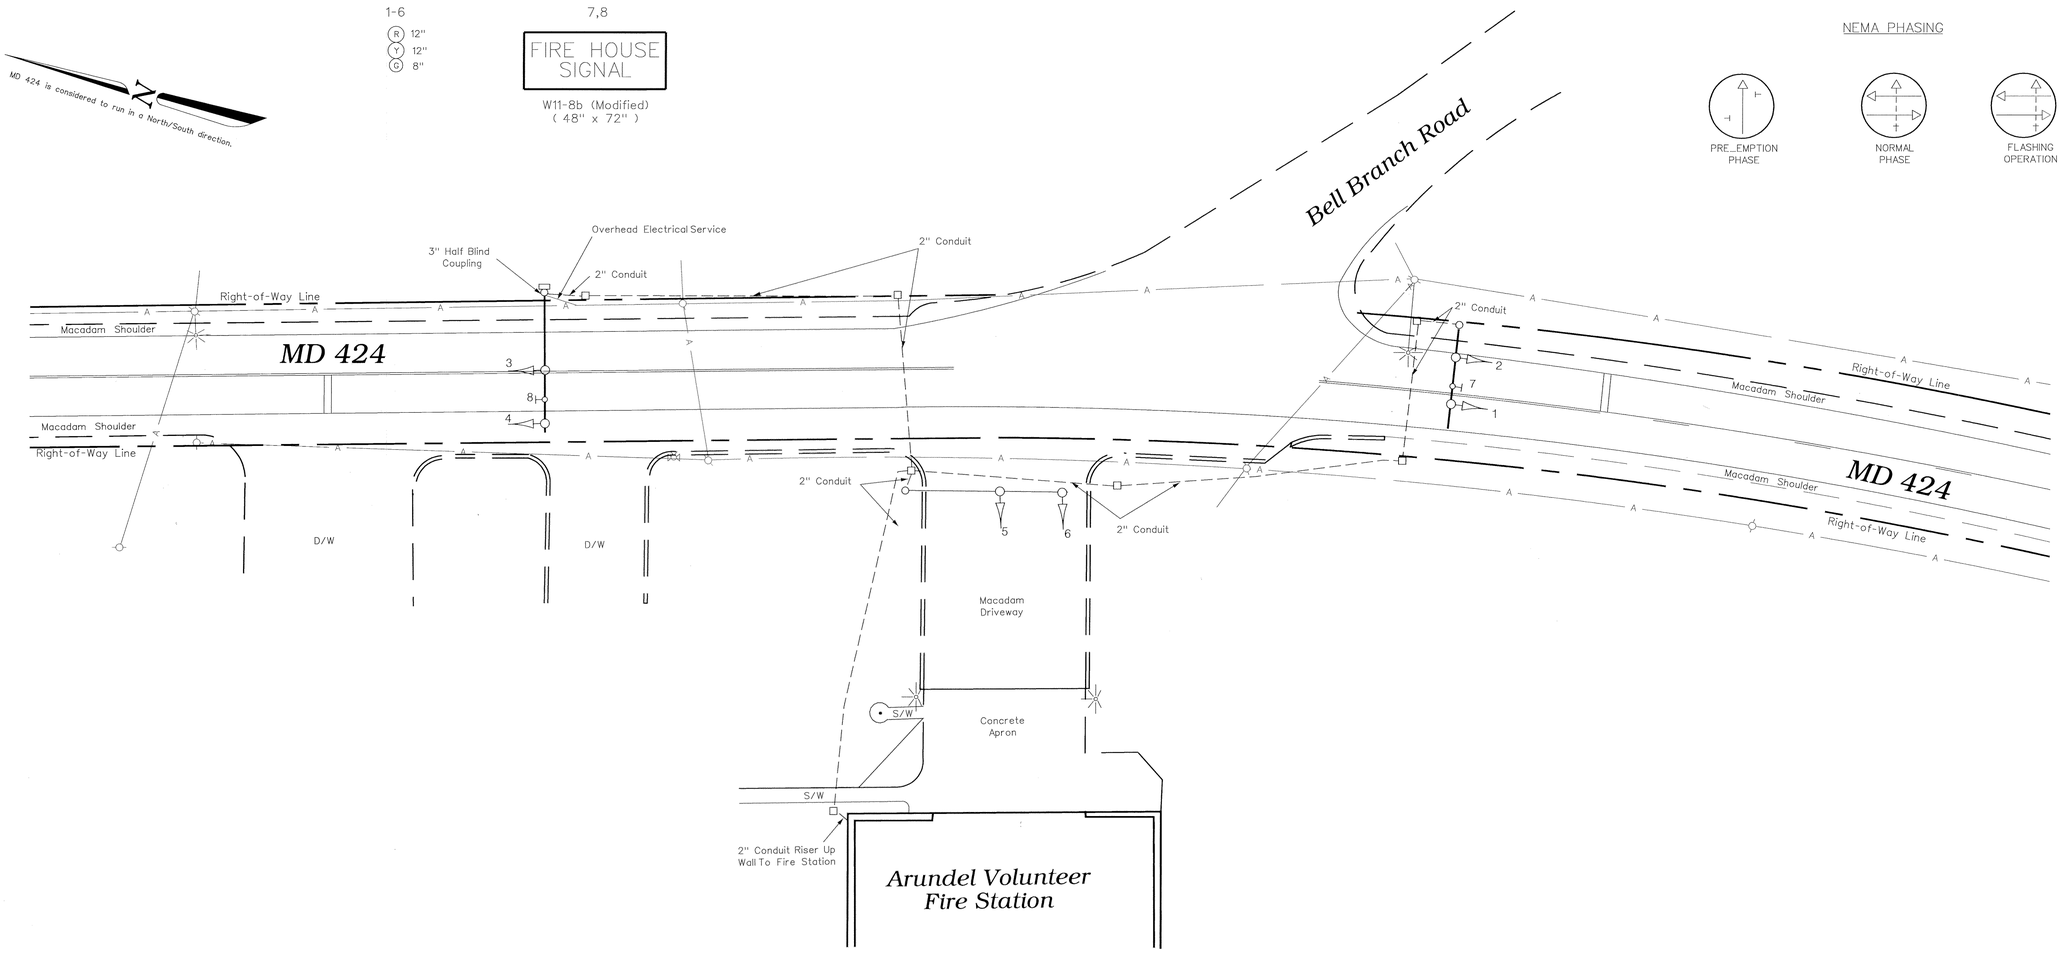

"AS-BUILT"

The Traffic Group

The Traffic Group, Inc.
Suite 600
40 W. Chesapeake Avenue
Towson, Maryland 21204
410-583-8405
1-800-583-8411
Fax: 410-321-8458
Job No. 960708
ASBUILT.DGN

GEOMETRIC LEGEND

EXISTING GEOMETRICS
PROPOSED GEOMETRICS

UTILITY LEGEND

G	GAS MAIN
W	WATER MAIN
S	SEWER MAIN
E	ELECTRIC CABLES
D	STORM DRAIN
A	AERIAL CABLES
T	TELEPHONE CABLES

REVISIONS

B ASBUILT AUG. 6, 1996
S.H.A. No.: 855-25057056
FJH

APPROVALS

ASST. DIVISION CHIEF TRAFFIC ENGINEERING DESIGN DIVISION

CHIEF, TRAFFIC ENGINEERING DESIGN DIVISION

ASST. DISTRICT ENGINEER - TRAFFIC

DIRECTOR, OFFICE OF TRAFFIC & SAFETY

ORIGINAL ON FILE

MDOT – STATE HIGHWAY ADMINISTRATION
Office of Traffic & Safety
TRAFFIC ENGINEERING DESIGN DIVISION

DRAWN BY: W J Nies
DES. BY: R R ZACHERL
CHK. BY:

(Traffic Signal Plan)
MD 424 and Arundel Volunteer Fire Station

COUNTY: ANNE ARUNDEL LOG MILE • 02042405.70

DATE: 3-30-88 F.A.P. NO. N/A
SCALE: 1" = 20' S.H.A. NO.

TS/STD. NO. 2490B

SHEET NO. 1 of 1